


O.D.O.T. DISTRICT 2 SURVEY OFFICE (USE ONLY)

PERSONNEL _____ REFERENCE NO. 37 SHEET 16 OF 38
 NOTES RHOADES _____ DATE 5/1/13 ROUTE US 20
 H.C. CODER _____ WEATHER CLEAR COUNTY WILLIAMS
 R.C. LAU _____ TEMP. 74° TOWNSHIP NORTHWEST
 _____ SECTION 34
 _____ T 9 S R 4 W

TYPE MONUMENT P.K.SHANK
 ON SURFACE - BELOW ON
 LEFT - ☉ PAV'T - RIGHT 0.4'
- TO - EDGE PAVEMENT
 S.L.M. 162+20.65
 GRID: NORTHING: 725460.532 EASTING: 1354333.282

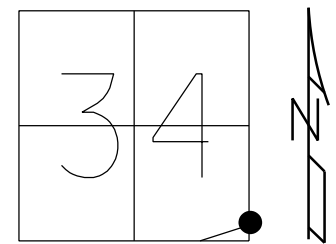

NOTE: REF 15A, US 20

RECORD:
 FD P.K.NAIL
 7/10/90, I.S.
 SET P.K.NAIL
 9/6/90, DJC
 FD P.K.SHANK
 4/6/12, SAH
 SET MAG/WASHER
 GPS, REFA15
 7/17/14, EBW

