


O.D.O.T. DISTRICT 2 SURVEY OFFICE (USE ONLY)


PERSONNEL _____ REFERENCE NO. 40 SHEET 3 OF 11

NOTES O'DONNELL DATE 4/11/16 ROUTE SR 49
 H.C. HOMAN WEATHER CLOUDY COUNTY WILLIAMS
 R.C. O'DONNELL TEMP. 51° TOWNSHIP NORTHWEST
 _____ SECTION 27
 _____ T 9 S R 4 W

TYPE MONUMENT P.K./WASHER
 ON SURFACE - ~~BELOW~~ ON _____
 LEFT - ☉ PAV'T - ~~RIGHT~~ 2.0', 0.5' S OF ☉ W
 _____ TO _____ EDGE PAVEMENT
 S.L.M. 935+25

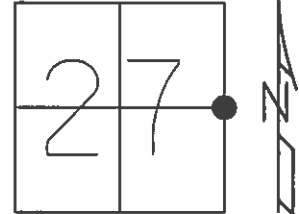

GRID: NORTHING: 733114.290 EASTING: 1354418.0760

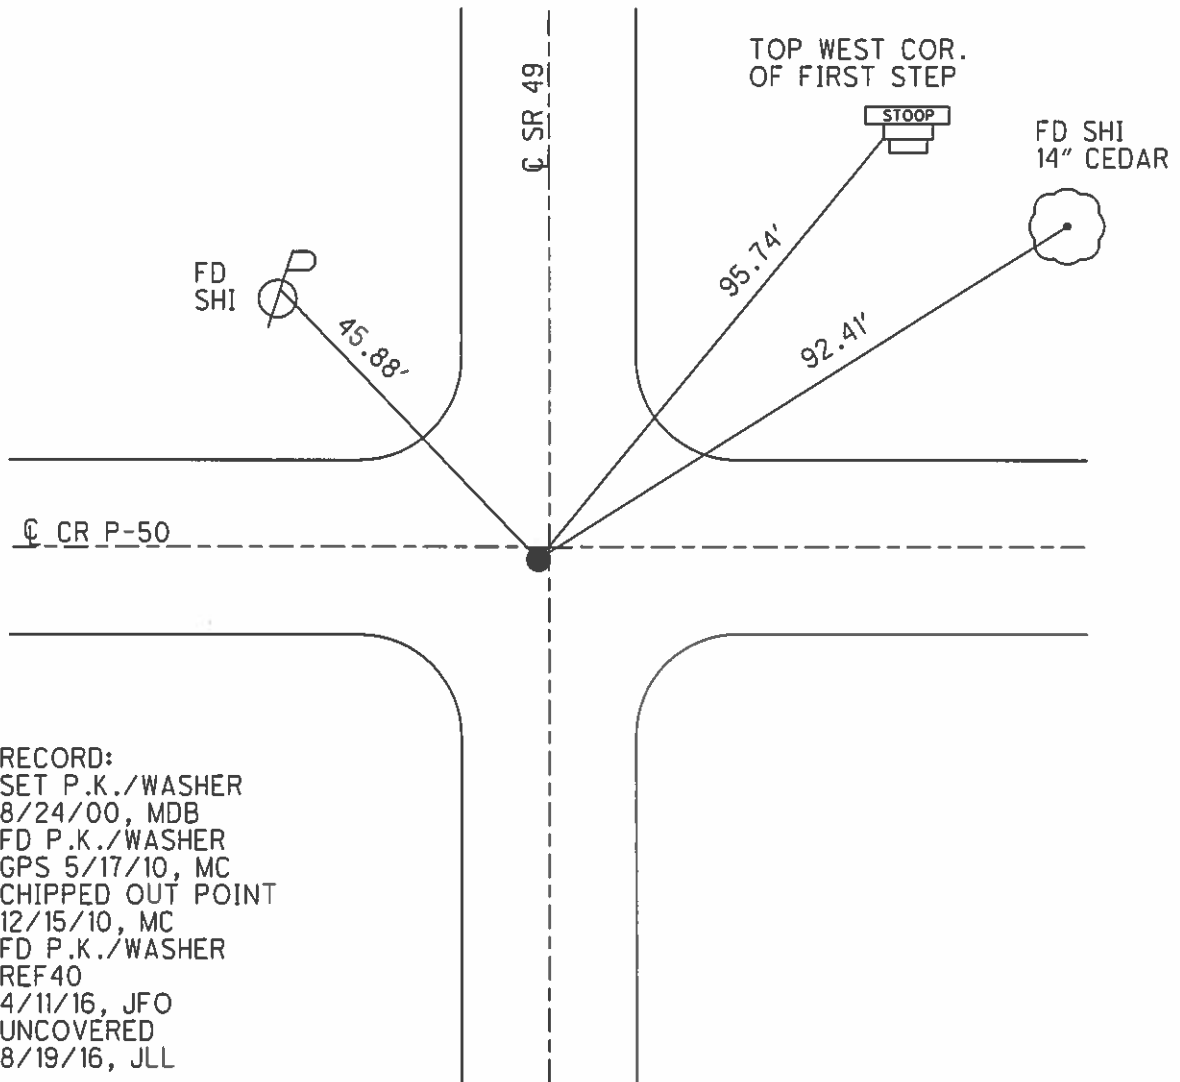

RECORD:
 SET P.K./WASHER
 8/24/00, MDB
 FD P.K./WASHER
 GPS 5/17/10, MC
 CHIPPED OUT POINT
 12/15/10, MC
 FD P.K./WASHER
 REF40
 4/11/16, JFO
 UNCOVERED
 8/19/16, JLL