

O.D.O.T. DISTRICT 2 SURVEY OFFICE (USE ONLY)

PERSONNEL _____ REFERENCE NO. 42 SHEET 7 OF 11
 NOTES O'DONNELL DATE 4/11/16 ROUTE SR 49
 H.C. HOMAN WEATHER P. CLOUDY COUNTY WILLIAMS
 R.C. O'DONNELL TEMP. 51° TOWNSHIP NORTHWEST
 _____ SECTION 22
 _____ T 9 S R 4 W


TYPE MONUMENT P.K./WASHER

ON SURFACE - ~~BELOW~~ ON _____

LEFT - ☉ PAV'T - ~~RIGHT~~ 0.3', 3.7' S OF ☉ CR Q-50
10.3' TO LT EDGE PAVEMENT

S.L.M. 988+42

GRID: NORTHING: 738409.374 EASTING: 1354515.575

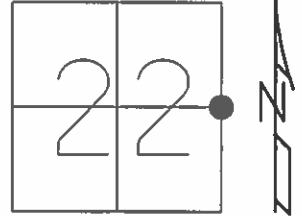

RECORD:
 SET P.K./WASHER
 8/24/00, MDB
 FD P.K./WASHER
 GPS 5/14/10, DCH
 CHIPPED OUT POINT
 12/15/10, MC
 FD P.K./WASHER
 REF42
 4/11/16, JFO
 UNCOVERED
 8/19/16, JLL

