



O.D.O.T. DISTRICT 2 SURVEY OFFICE (USE ONLY)

PERSONNEL \_\_\_\_\_ REFERENCE NO. 46 SHEET 11 OF 11  
 NOTES O'DONNELL DATE 4/11/16 ROUTE SR 49  
 H.C. HOMAN WEATHER CLOUDY COUNTY WILLIAMS  
 R.C. O'DONNELL TEMP. 51° TOWNSHIP NORTHWEST  
 SECTION 11  
 T 9 S R 4 W

TYPE MONUMENT ROUND MON. BOX 8"  
~~ON SURFACE~~ - BELOW 4"  
 LEFT - ☉ PAV'T - ~~RIGHT~~ ON \_\_\_\_\_  
11.9' TO LT EDGE PAVEMENT  
 S.L.M. 1085+32

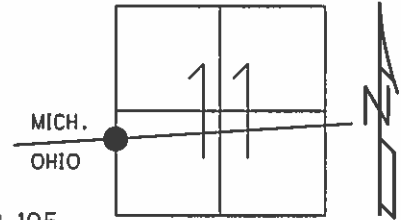

GRID: NORTHING: 748061.014 EASTING: 1354762.105

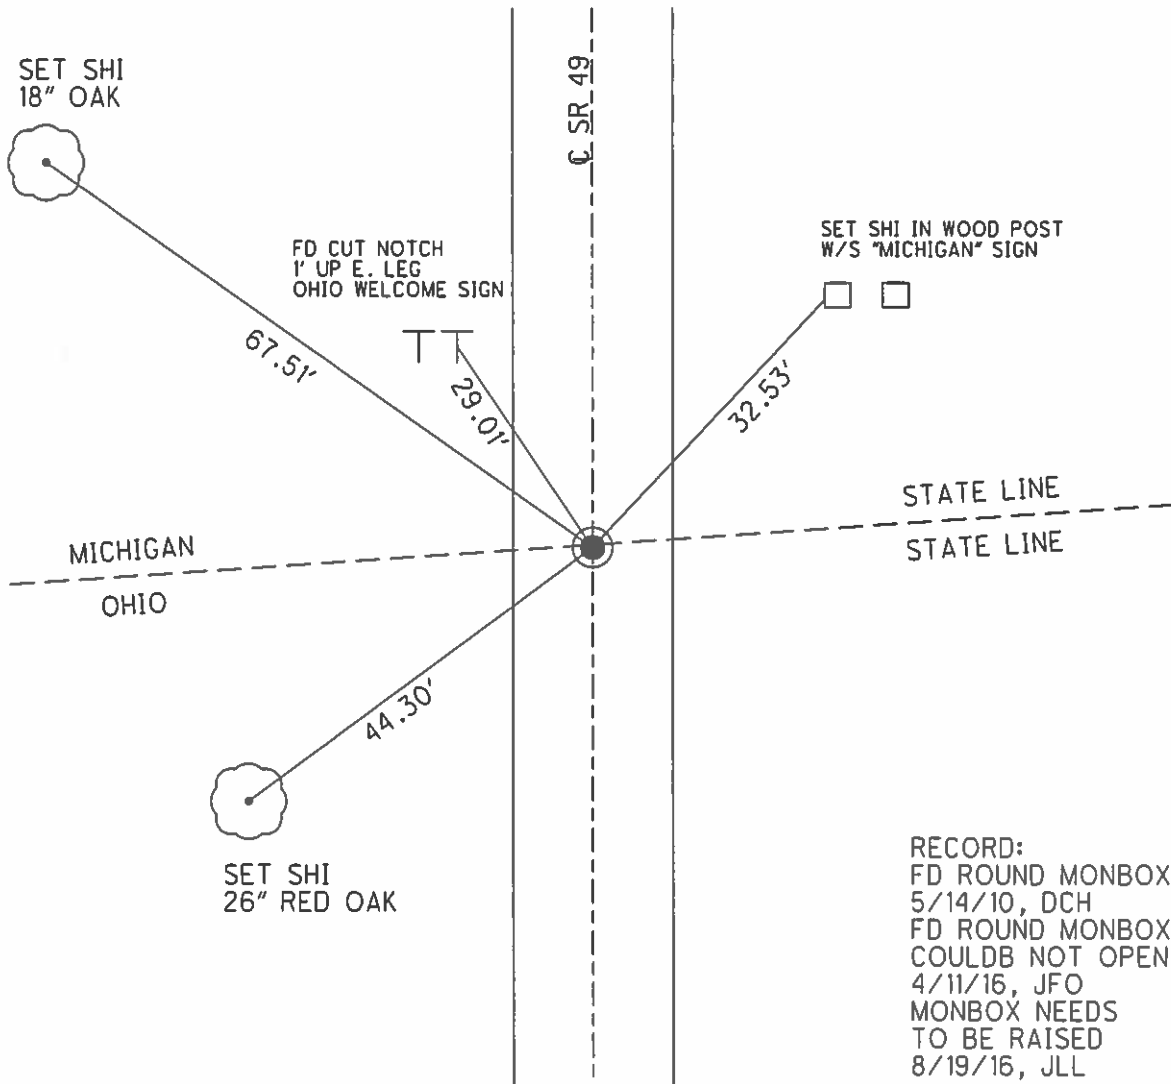

RECORD:  
 FD ROUND MONBOX  
 5/14/10, DCH  
 FD ROUND MONBOX  
 COULDB NOT OPEN  
 4/11/16, JFO  
 MONBOX NEEDS  
 TO BE RAISED  
 8/19/16, JLL