

O.D.O.T. DISTRICT 2 SURVEY OFFICE (USE ONLY)

PERSONNEL

REFERENCE NO. 1

SHEET 1 OF 4

NOTES RHOADES
 H.C. O'DONNELL
 R.C. MILLER

DATE 3/22/19
 WEATHER WINDY
 TEMP. 36°

ROUTE SR 66
 COUNTY WILLIAMS
 TOWNSHIP SPRINGFIELD
 SECTION 36
 T 6 N R 4 E

DWG BY NIESE PID 101344

TYPE MONUMENT MONBOX W/ 1" IPIN

ON SURFACE - ~~BELOW~~ ON

OFFSET Q PAVEMENT ON LT : RT
- TO - EDGE PAVEMENT


STATION: 0+00

HORZ. DATUM: NAD83(2011)


GEOID: 2012A

GRID: NORTHING: 646992.655

EASTING: 1458195.682

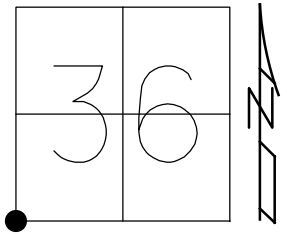

RECORD:
 FD 1" SUARE IPIPE
 5/6/99, MC
 SET P.K./WASHER
 10-22-99, MDB
 FD RR SPIKE
 REF1
 4-2-18, JFO
 FD MONBOX
 W/ 1" IPIN
 NEWREF1
 3-22-19, JFO

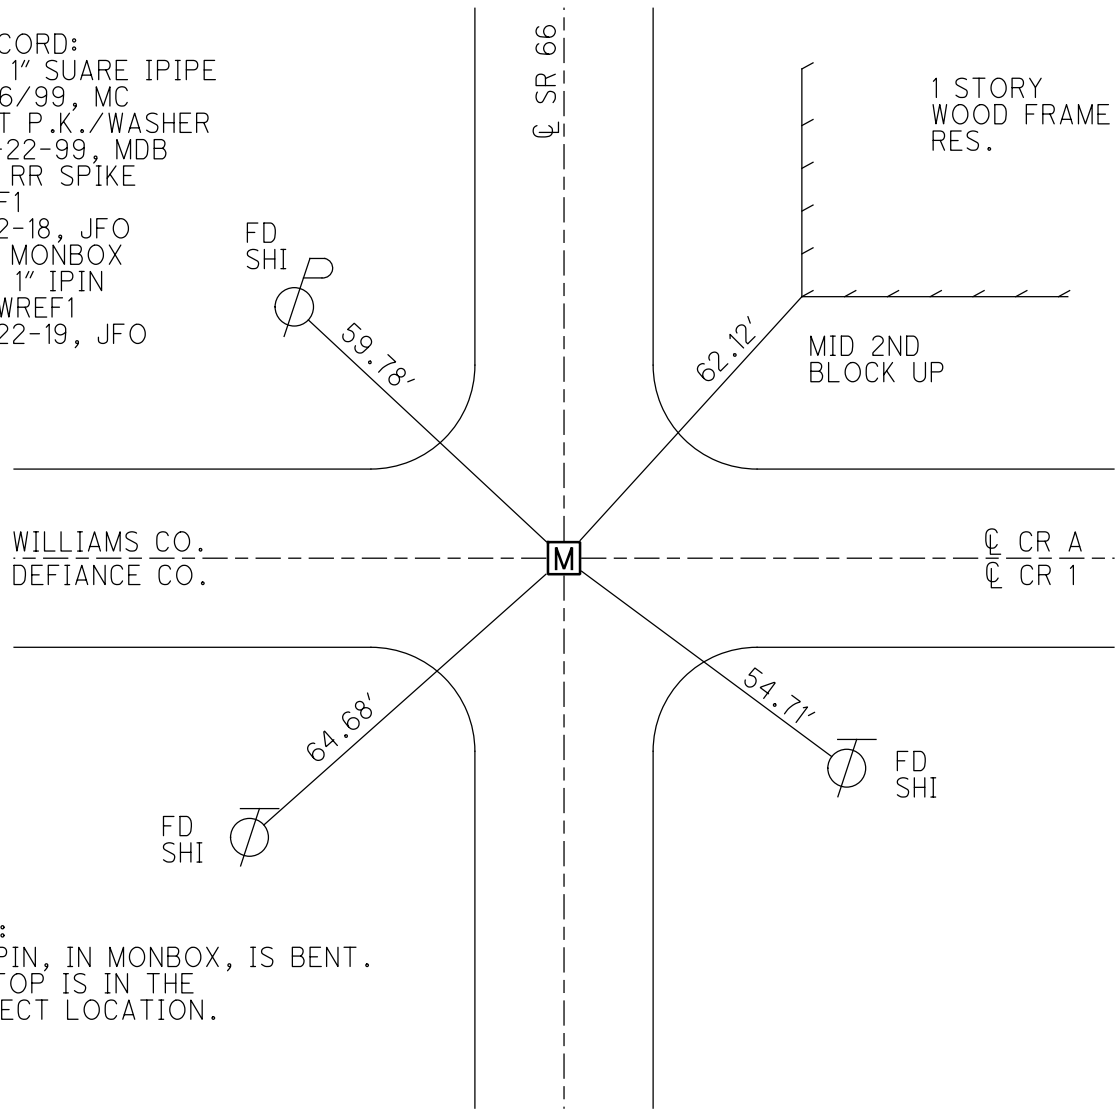

NOTE:
 NEW PIN, IN MONBOX, IS BENT.
 THE TOP IS IN THE
 CORRECT LOCATION.

O.D.O.T. DISTRICT 2 SURVEY OFFICE

PERSONNEL

REFERENCE NO. 1

SHEET 1 OF 4

NOTES CANTERBURY

H.C. ROUSOS

R.C. CANTERBURY

DATE 5/6/99

WEATHER WINDY

TEMP. +75°

ROUTE SR 66

COUNTY Williams

TOWNSHIP Springfield

SECTION 36

T.C. N.R. 4 E


TYPE MONUMENT Square Steel Monument w/ 1" Hole in Ctr.

ON SURFACE - BELOW 3" DOWN

LEFT - & PAV'T. - RIGHT ON & BOTH

TO EDGE PAVEMENT

S.L.M. 0+00

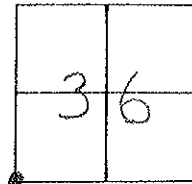

RESET P.K./WASHER

10-22-99 MDB.

SR 66

SW/CORNER OF
CONC BLK. FDN.
1 STORY WOOD FRAME RES.

Fd. SHI.
SE/S.

59.80'

62.10'

Williams Co.
DEFIANCE Co.

Co. Rd. A
Co. Rd 1

64.86'

54.71'

SET SHI.
NE/S.

SET SHI.
NW/S.

Center Point