

O.D.O.T. DISTRICT 2 SURVEY OFFICE (USE ONLY)

PERSONNEL

REFERENCE NO. 3

SHEET 3 OF 4

NOTES RHOADES
 H.C. O'DONNELL
 R.C. SEAMAN

DATE 4-2-18
 WEATHER SUNNY
 TEMP. 31°

ROUTE SR 66
 COUNTY WILLIAMS
 TOWNSHIP SPRINGFIELD
 SECTION 36
 T 6 N R 4 E

DWG BY NIESE PID 101344

TYPE MONUMENT P.K./WASHER

ON SURFACE - ~~BELOW~~ ON

OFFSET 12.5' TO RT EDGE PAVEMENT

OFFSET 1.0' RT : RT



STATION: 26+41

HORIZ.DATUM: NAD83(2011)

GEOID: 2012A

GRID: NORTHING: 649632.708

EASTING: 1458248.307

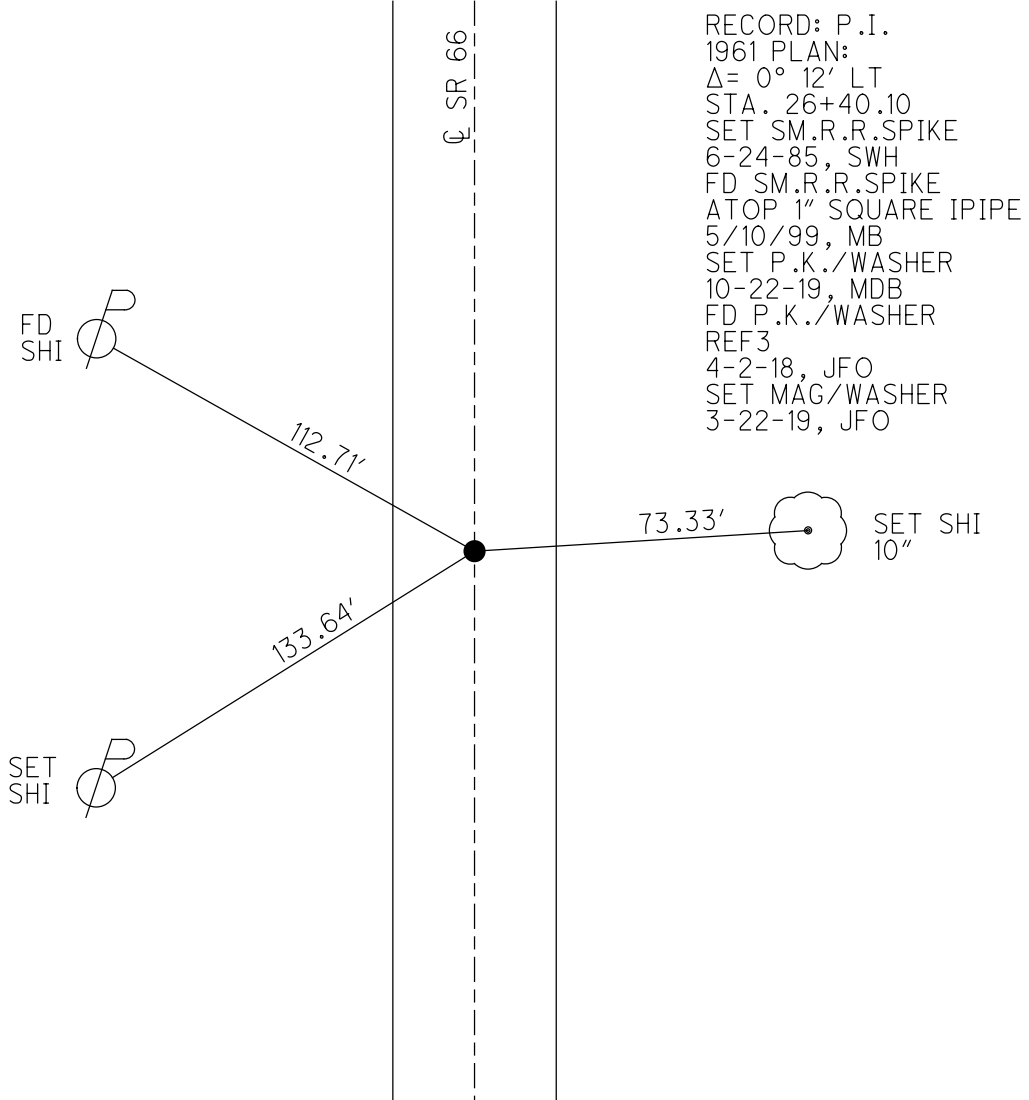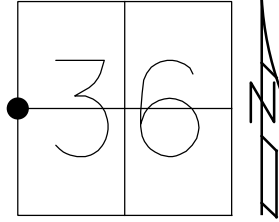

RECORD: P.I.
 1961 PLAN:
 $\Delta = 0^\circ 12' \text{ LT}$
 STA. 26+40.10
 SET SM.R.R.SPIKE
 6-24-85, SWH
 FD SM.R.R.SPIKE
 ATOP 1" SQUARE IPIPE
 5/10/99, MB
 SET P.K./WASHER
 10-22-19, MDB
 FD P.K./WASHER
 REF3
 4-2-18, JFO
 SET MAG/WASHER
 3-22-19, JFO

O.D.O.T. DISTRICT 2 SURVEY OFFICE

PERSONNEL _____

REFERENCE NO. 3

SHEET 3 OF 4

NOTES CANTERBURY

H.C. Rousos

R.C. BARNHISEL

DATE 5/10/99

WEATHER FAIR

TEMP. +75°

ROUTE US. 66

COUNTY Williams

TOWNSHIP SPRINGFIELD

SECTION 36

T. 6 N. 4 E.


TYPE MONUMENT Sm. R.R. SPK. ATOP SQUARE Steel Mon. w/1" HOLE IN CTR.

ON SURFACE - BELOW SURFACE

LEFT - PAV'T. - RIGHT 0.2' RT &

12.5' TO RT. EDGE PAVEMENT


S.L.M. 26+41 sLm / 0+806.005 sLk

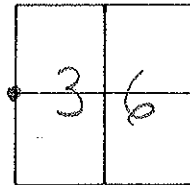


1961 Plan:
P.I. ΔLT 0°12'
Sta. 26+40.10
Sm. RR. Spk. set
6-24-85
SWH

RESET P.K./WASHER
10-22-99 M.D.B.


SET SHI.
SE/S.

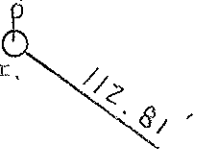

SRGG

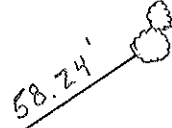

SET SHI.
W/S 4" TWIN ASH

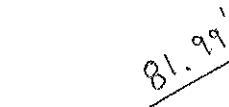

SET SHI.
NE/S. 4" WILLOW TREE

Pymt

