

O.D.O.T. DISTRICT 2 SURVEY OFFICE (USE ONLY)

PERSONNEL \_\_\_\_\_

REFERENCE NO. 4


SHEET 4 OF 4

NOTES CANTERBURY DATE 5-10-99  
 H.C. ROUSOS WEATHER FAIR  
 R.C. BARNHISEL TEMP. 75°

ROUTE SR 66  
 COUNTY WILLIAMS  
 TOWNSHIP SPRINGFIELD  
 SECTION 36  
 T 6 N R 4 E

DWG BY NIESE PID 101344

TYPE MONUMENT SM. R.R. SPK. ATOP P.K. SHANK  
 ON SURFACE - ~~BELOW~~ ON  
 OFFSET ☉ PAVEMENT ON ~~LT~~ : RT  
13.1' TO RT EDGE PAVEMENT  
 STATION: 37+01

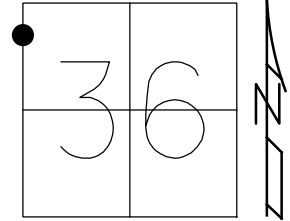


HORZ.DATUM: NAD83(2011)

GEOID: 2012A

GRID: NORTHING: 650692.289

EASTING: 1458265.452

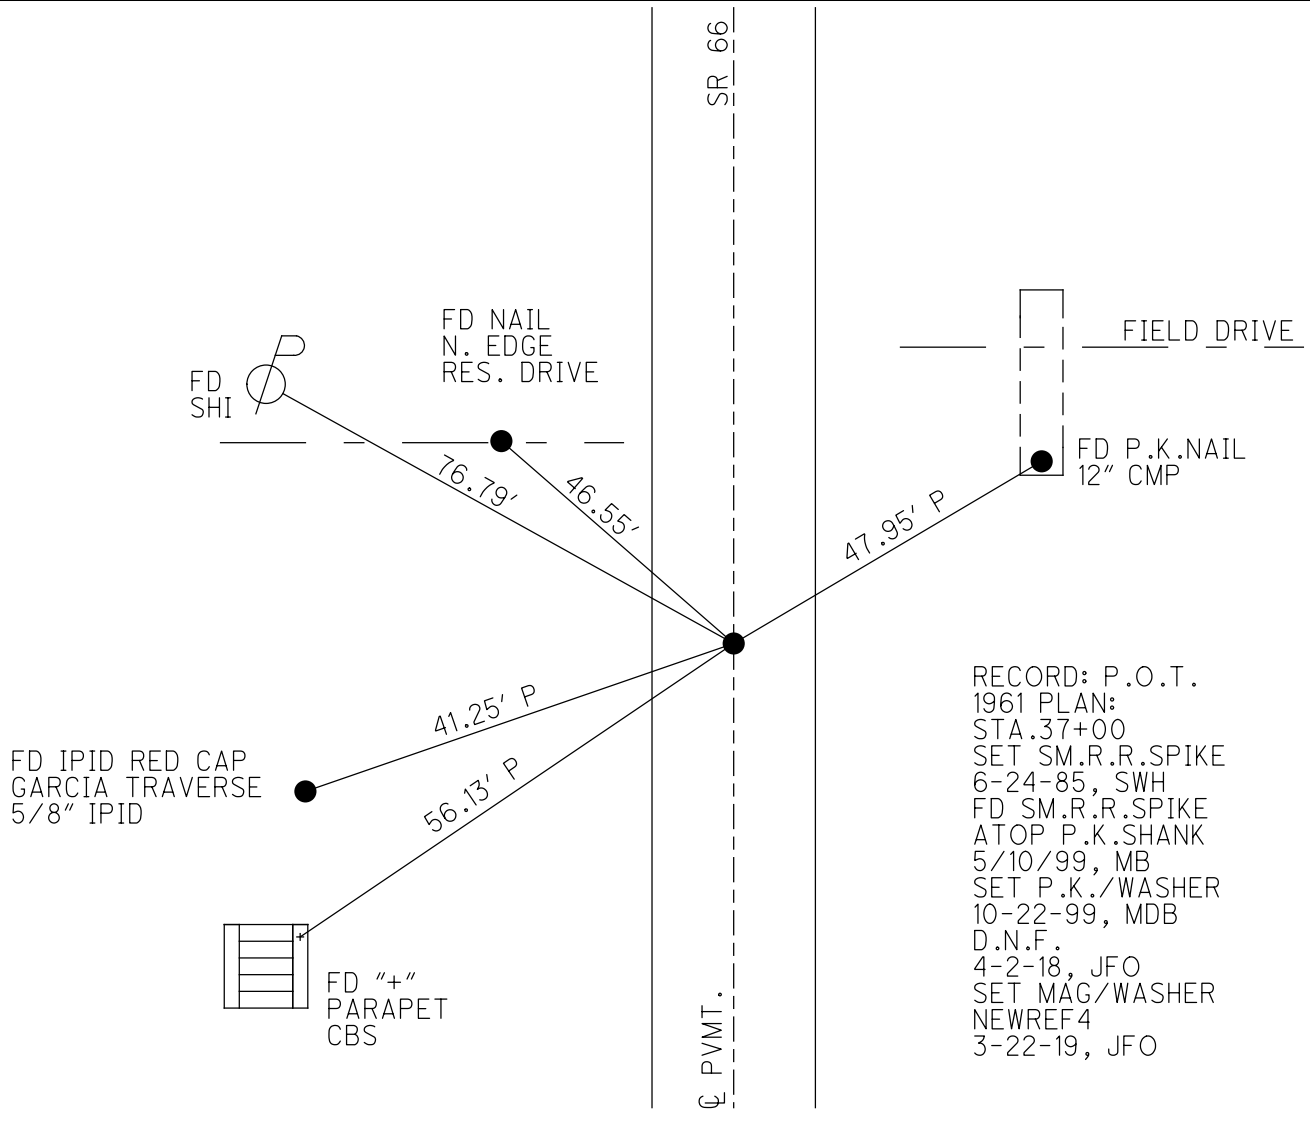

RECORD: P.O.T.  
 1961 PLAN:  
 STA.37+00  
 SET SM.R.R.SPIKE  
 6-24-85, SWH  
 FD SM.R.R.SPIKE  
 ATOP P.K.SHANK  
 5/10/99, MB  
 SET P.K./WASHER  
 10-22-99, MDB  
 D.N.F.  
 4-2-18, JFO  
 SET MAG/WASHER  
 NEWREF4  
 3-22-19, JFO

# O.D.O.T. DISTRICT 2 SURVEY OFFICE

PERSONNEL

REFERENCE NO. 4

SHEET 4 OF 4

NOTES CANTERBURY

H.C. Rousos

R.C. BARNHISEL

DATE 5/10/99

WEATHER FAIR

TEMP. +75°

ROUTE SR 66

COUNTY Williams

TOWNSHIP Springfield

SECTION 36

T 6 N R 4 E


TYPE MONUMENT Sm. R.R. SPK. ATOP P.K. SHANK

ON SURFACE - ~~BELOW~~ SURFACE

LEFT = ☉ PAV'T. - ~~RIGHT~~ ON E

13.1' TO RT. EDGE PAVEMENT

S.L.M. 37+01 SLM / 1+129.06 SLK

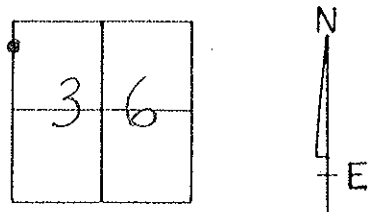

1961 PLAN:  
P.D.T. 37+00

Sm. RR SPK SET  
6-24-85  
SWH

RESET P.K. + WASHER  
10-22-99 M.D.B.

SET SH. 3' UP NE/S.

SET SH. N. EDGE RES. DRIVE

FIELD DRIVE  
FD. P.K. S. END  
12" C.M.P.

76.79'

46.55'

47.95' (P)

56.13' (P)

FD "4"  
NORTH END EAST  
PARAPET C.B.

SR 66

Pav't