

COUNTY Williams

ROUTE

SR 107

SECTION 761

L = Prop Pav't Depth(in.) x 10; W = Width @ Mouth; W-1 = Width @ Throat

[illegible]

UTILITIES (Catch Basin, Manhole, Inlet, Watervale Box and Monument Box)

COUNTY Williams ROUTE SR107 SECTION 101
R = Raise F = Feather

R = Raise F = Feather

STATION	OUT Rt/Lt (FT)	CATCH BASIN	MAN- HOLE	INLET	W V BOX	MON BOX	CASTING		REMARKS
							R	F	
427+11	Rt CURB	X					X		
427+11	Lt CURB	X					X		
430+13	9' Rt G		X					X	
430+13	Rt CURB			X					No WORK AREA
430+13	Lt CURB			X					No WORK AREA
432+08	12 Lt G				X		X		No WORK AREA
432+16	Lt CURB	X							No WORK AREA
432+42	9 Lt G		X						No WORK AREA
432+67	Lt CURB	X							No WORK AREA
432+69	Rt CURB	X		(2' Lt of Rt CURB)			X		1" Below Top of PAVT
432+79	12.5' Lt G				X				No WORK AREA
435+38	15' Lt G	10' " No WORK AREA"			X				No WORK AREA
435+79	20 Lt G								No WORK AREA
436+05	15 Lt G								No WORK AREA
438+60	15 Lt G				X	2" Below Asph Top	X		No WORK AREA
438+70	12' Rt		X						No WORK AREA
438+75	15 Lt G				X				No WORK AREA
438+75	2' Lt of Rt CURB	X							No WORK AREA
438+78	Lt CURB	X							No WORK AREA
439+27	37' Rt G						X		No WORK AREA
439+51	10' Lt G				X				No WORK AREA
442+72	7 Lt G		X						No WORK AREA
442+80	32 Lt G				X				No WORK AREA
443+03	14 Lt G				X				No WORK AREA
443+24	Lt CURB	X							No WORK AREA
443+47	G								No WORK AREA
443+56	6' Lt G		X						No WORK AREA
444+52	4' Lt G		X						No WORK AREA
446+28	18 Lt G		X						No WORK AREA
446+43	Lt CURB			X					No WORK AREA

UTILITIES (Catch Basin, Manhole, Inlet, Watervalue Box and Monument Box)

COUNTY Williams ROUTE SECTION

R = Raise F = Feather

STATION	OUT Rt/Lt (FT)	CATCH BASIN	MAN- HOLE	INLET	W V BOX	MON BOX	CASTING		REMARKS
							R	F	
452+84	Rt CURB			X				X	
453+08	15' Lt		X				X		
453+08	5' Lt		X				X		
453+08	7' Rt		X				X		
453+20	21' Behind	X					X		RAISE IF PAVED BACK To New PAVT.
453+34	Lt CURB			X				X	
453+37	Rt CURB			X				X	
456+21	12' Lt				X		X		
456+51	7' Lt		X				X		
456+57	5' Rt		X						
456+39	Lt CURB			X				X	
456+80	Rt CURB			X				X	
458+80	12' Lt				X		X		
459+06	7' Lt		X				X		
459+06	21' Lt		X				X		
462+53	8' Lt		X				X		
462+60	7' Rt		X				X		
462+62	13' Lt				X		X		
462+70	Lt CURB			X				X	
462+76	18' Rt				X		X		
466+13	Rt CURB			X			X		
466+14	6' Lt		X				X		
466+14	Lt CURB			X			X		
466+48	Lt CURB			X			X		
466+57	Rt CURB			X			X		
467+57	Rt CURB			X			No WORK		-AT BEGINNING 2' GUTTER
467+71	10' Lt				X		X		
467+86	17' Rt		X				X		
468+07	15' Lt			X			No WORK		

OHIO DEPARTMENT OF TRANSPORTATION

LD-5 Rev. 2-83

SHEET NO. 5-15

PERSONNEL

TITLE

PERSONNEL

TITLE

COUNTY Williams

DATE 10-13-92

LOEHLKE

E

S. R. S. R. 107

WEATHER BREEZY

CREW

SEC. 7.67

TEMP. +60

JOB NO.


PAVT WIDTHS

DESCRIPTION

LEFT

CENTER LINE

RIGHT

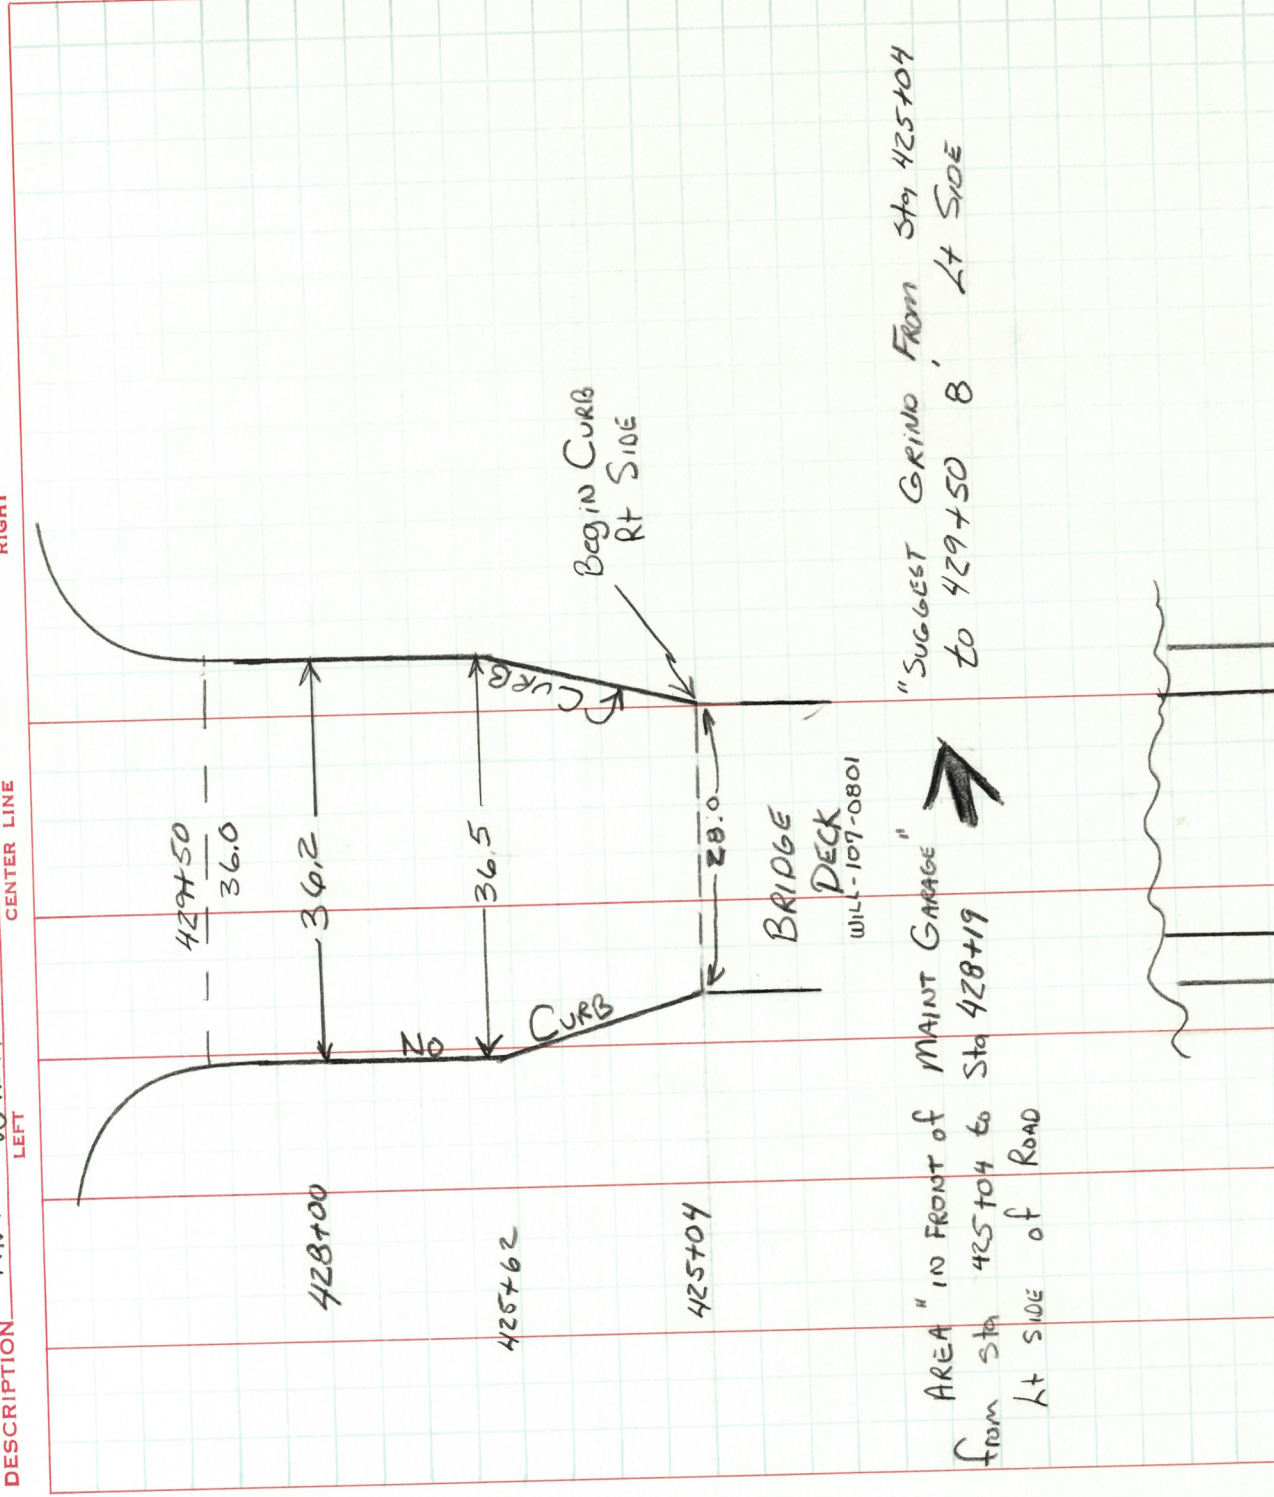

OHIO DEPARTMENT OF TRANSPORTATION

SHEET NO. 6-15

PERSONNEL

TITLE

PERSONNEL

TITLE

COUNTY Williams

DATE 10-14-92

LOENAKE

S. R.

S. R. 107

WEATHER Breezy

CREW

SEC.

7.67


TEMP. +65

DESCRIPTION

PAVT WIDTH'S

RIGHT

JOB NO.

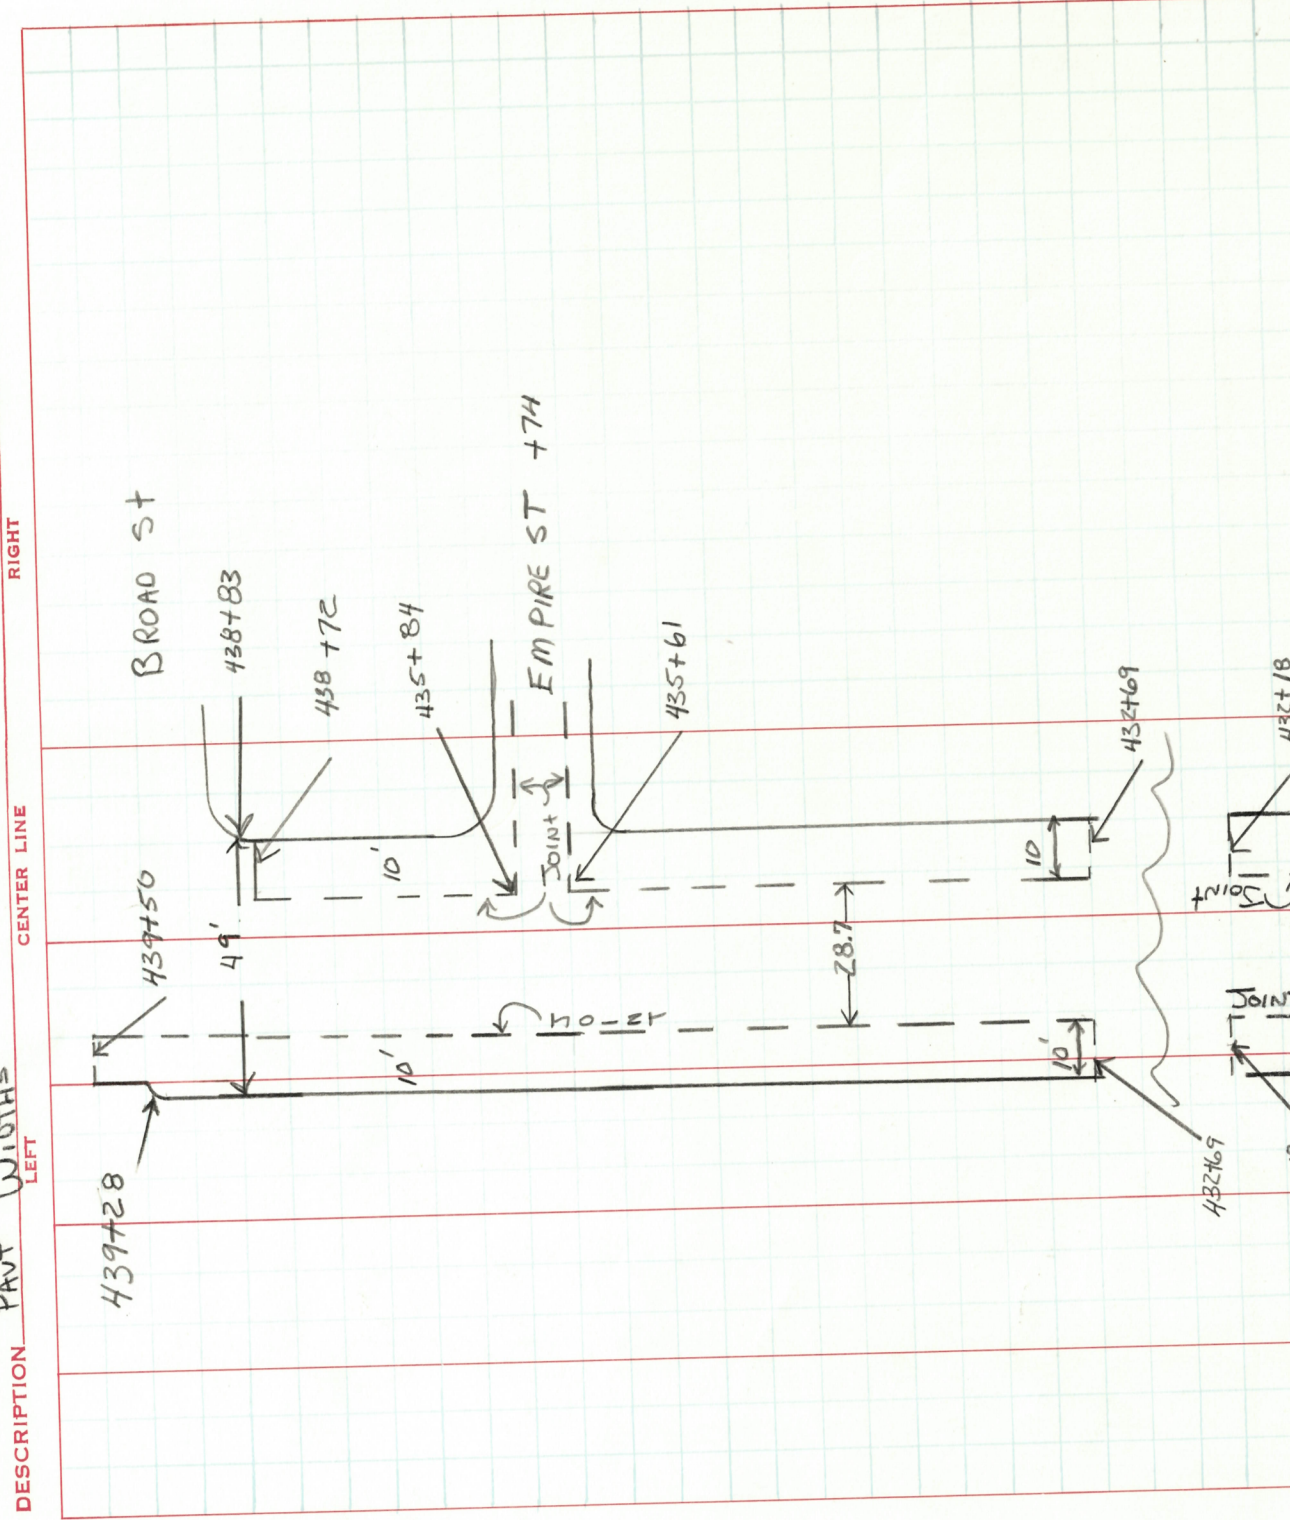


OHIO DEPARTMENT OF TRANSPORTATION

SHEET NO. 7-15

PERSONNEL TITLE PERSONNEL TITLE COUNTY Williams DATE 10-14-92
 LOEHMKE
 CURTIS S. R. S. R. 107 WEATHER Cloudy
 ROMERO SEC. 7.67 TEMP. +70

DESCRIPTION PAUT WIDTHS CENTER LINE RIGHT JOB NO.

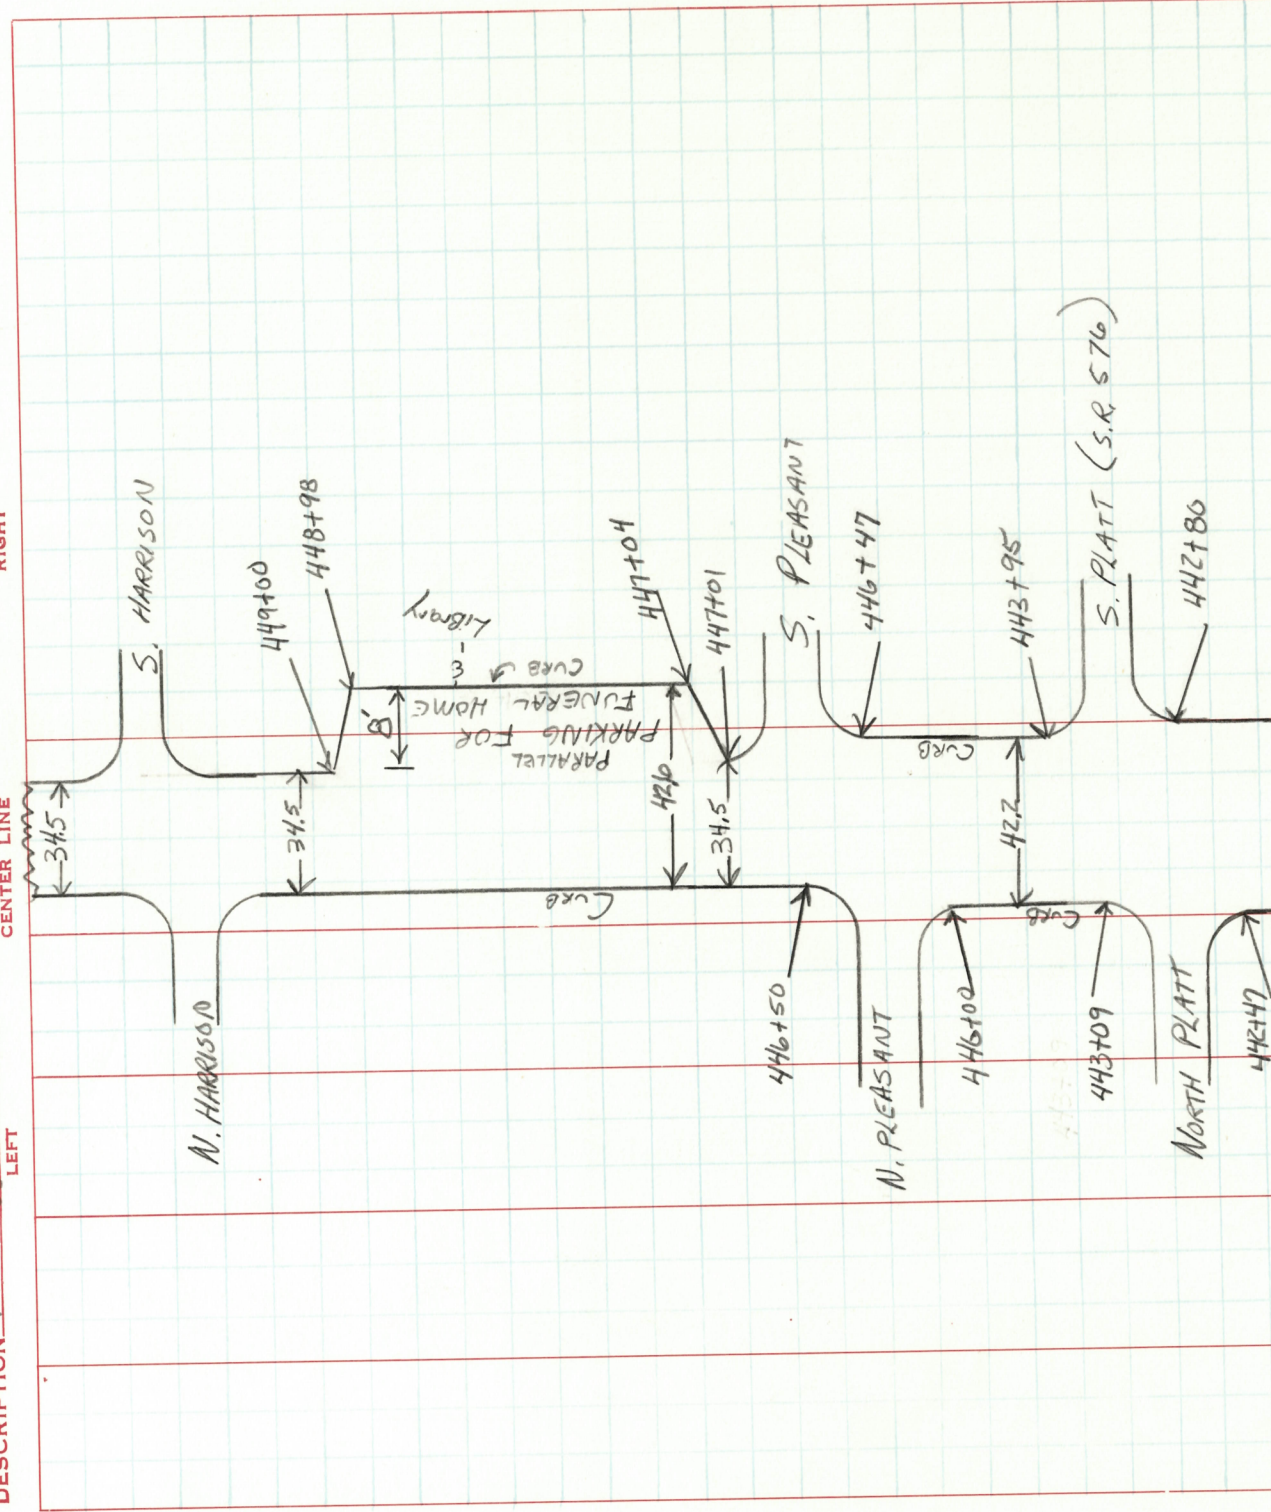

OHIO DEPARTMENT OF TRANSPORTATION

SHEET NO. 8-15


PERSONNEL	TITLE	PERSONNEL	TITLE	COUNTY	DATE
LOENAKE				Will	10-28-92
CURTIS					
ROMETO					

WEATHER Pt Cloudy

TEMP. +54

JOB NO. _____

DESCRIPTION	PAVT	WIDTHS	CENTER LINE	RIGHT
		LEFT		

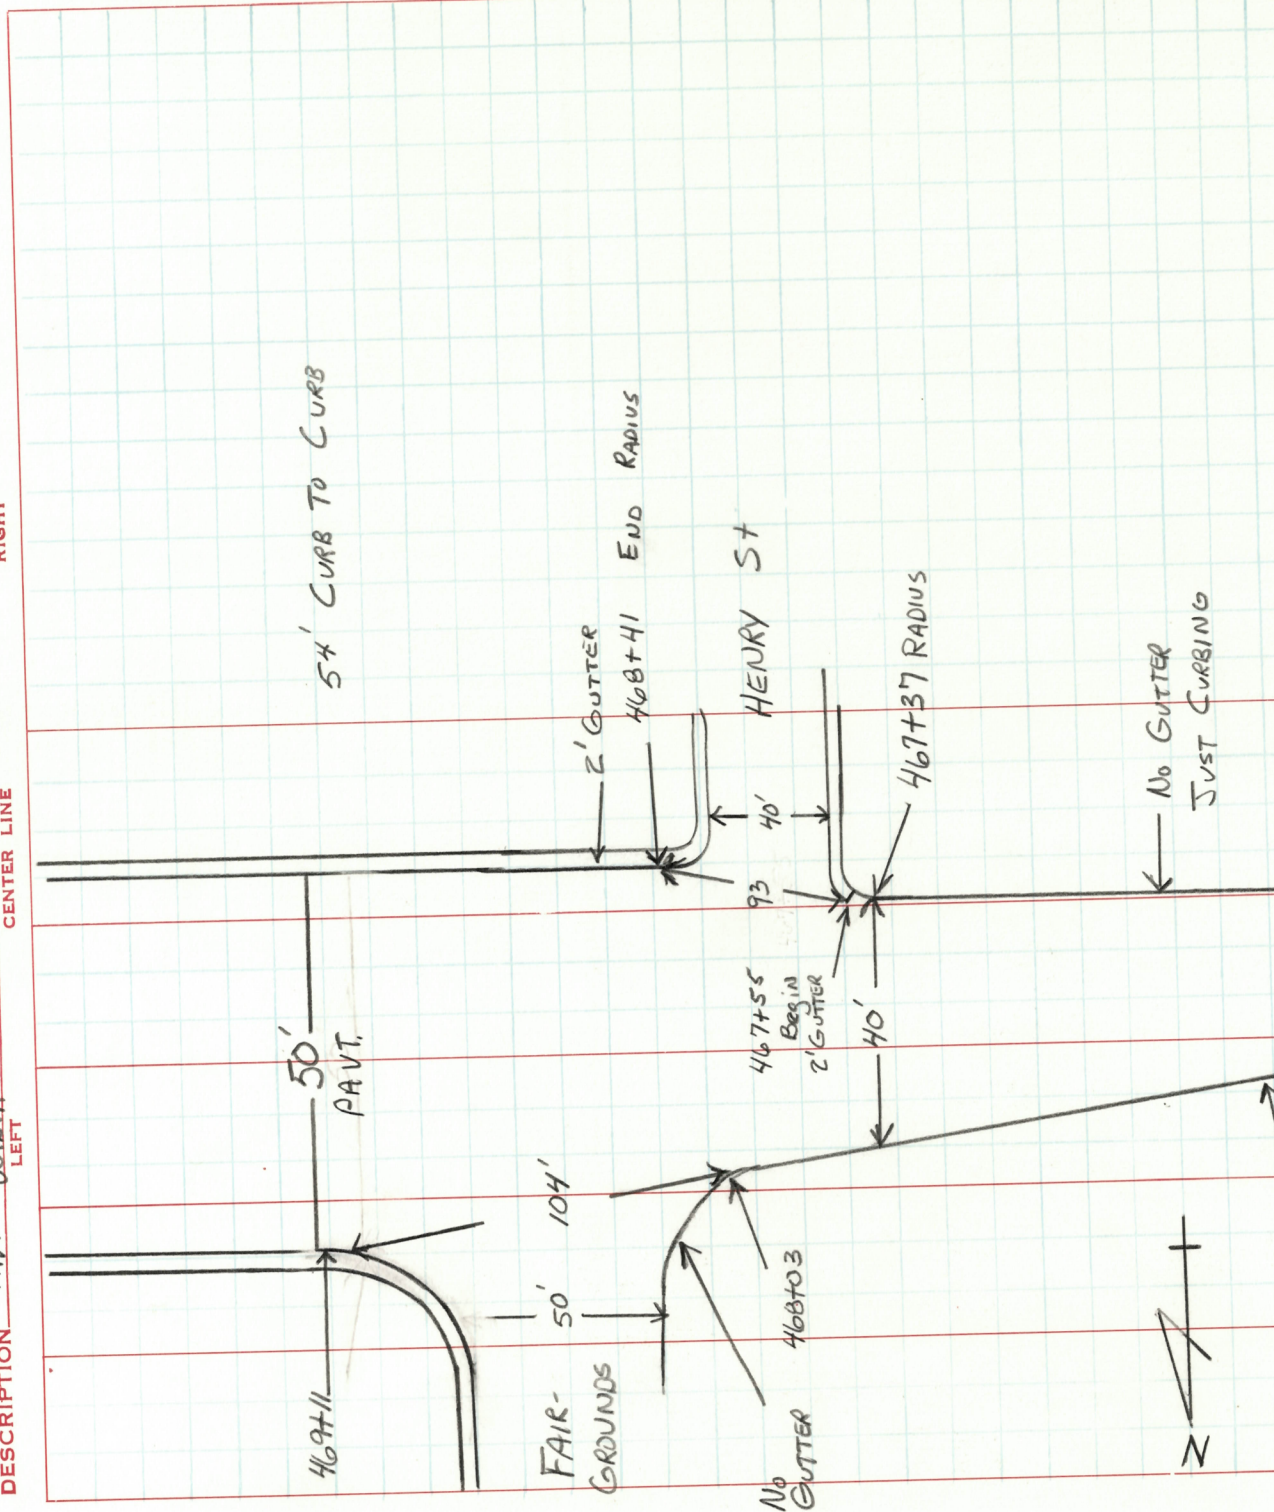

OHIO DEPARTMENT OF TRANSPORTATION

SHEET NO. 9-15

PERSONNEL

Loehrke

TITLE

PERSONNEL

TITLE

COUNTY W, HDATE 10-28-92ES. R. 107WEATHER Pt Cloudy

CREW

SEC. 7.67TEMP. +57

DESCRIPTION

STOP BARS

LEFT

CENTER LINE

RIGHT

JOB NO.

TYPE:

"A" is

"B" is

S.R. 107

To S.R. 107, Across Side Streets.

Sta

Length

Width

Type

430+10

31'

12"

A

432+07

28'

12"

A

432+78

30'

12"

A

435+34

23'

12"

A

436+08

29'

12"

A

438+51

28'

12"

A

439+57

27'

12"

A

442+30

29'

12"

A

443+87

25'

12"

A

445+80

OHIO DEPARTMENT OF TRANSPORTATION

SHEET NO. 10-15

PERSONNEL

LOEHARKE

TITLE

TITLE

COUNTY WILL

DATE

10-28-92

CREW

S. R. 107

WEATHER Pt Cloudy

CREW

SEC. 7.67

TEMP. +58

JOB NO.

RIGHT

ZONES

CENTER LINE

LEFT

PAINTED

"ARROWS" & "SCHOOL"

DESCRIPTION

ARROWS

430+47

431+69

433+09

436+39

438+13

439+67

442+11

443+91

444+67

447+03

449+25

450+22

452+66

453+48

456+88

458+64

462+34

463+09

→ OR ←

FOR TURN LANES ⇒ "T" TO THE
MOST WESTERLY PT. OF ARROW

OHIO DEPARTMENT OF TRANSPORTATION

SHEET NO. 11-15

PERSONNEL

TITLE

PERSONNEL

TITLE

COUNTY Will

DATE 10-28-92

LOGHARKE

&

S. R.

107

WEATHER Pt Cloudy

CREW

SEC.

7.67

TEMP. +56

JOB NO.

CROSS WALK

DESCRIPTION

LEFT

CENTER LINE

RIGHT


Sta	Type: "A" is "B" is		Across PARALLEL		S.R. 107 To S.R. 107, Across Side Streets	
	STERE WIDTH	Avg. Length	Avg. Width	Type		
429+81	6"	38'	5'	B	EMPTY	S. MONROE ST N. MONROE ST. (S.R. 576)
430+08	12"	48.5'	5'	A	"	
432+12	12"	48.5'	5'	A	"	
432+42	6"	42'	5'	B	"	NORTH JONESVILLE
432+42	12"	41'	5'	B	"	SOUTH JONESVILLE
432+65	12"	49'	5'	A	"	
435+40	12"	48.5'	5'	A	"	
435+74	6"	44'	5'	B	"	S. EMPIRE
435+98	12"	49'	5'	A	"	
438+79	12"	49'	5'	A	"	
439+11	12"	46'	5'	B	"	BROAD ST
439+45	12"	45'	5'	A	"	
440+23	12"	25'	5'	B	"	OPDYKE ST
442+45	12"	46'	5'	A	"	
443+77	12"	49'	5'	A	"	
446+25	12"	30"	5'	B	"	N. PLEASANT ST.
446+50	12"	39'	5'	A	"	
446+68	12"	26'	5'	B	"	S. PLEASANT ST.
446+95	12"	35'	5'	A	"	

PAVT MARK
OHIO DEPARTMENT OF TRANSPORTATION

SHEET NO. 12-15
DATE 10-28-92
COUNTY W, 11
WEATHER Pt Cloudy
TEMP. +58

PERSONNEL TITLE PERSONNEL TITLE
LOEHARKE
CURTIS
ROMERO
S. R. 107
SEC. 7.67

DESCRIPTION PAVT MARKINGS CENTER LINE RIGHT JOB NO.

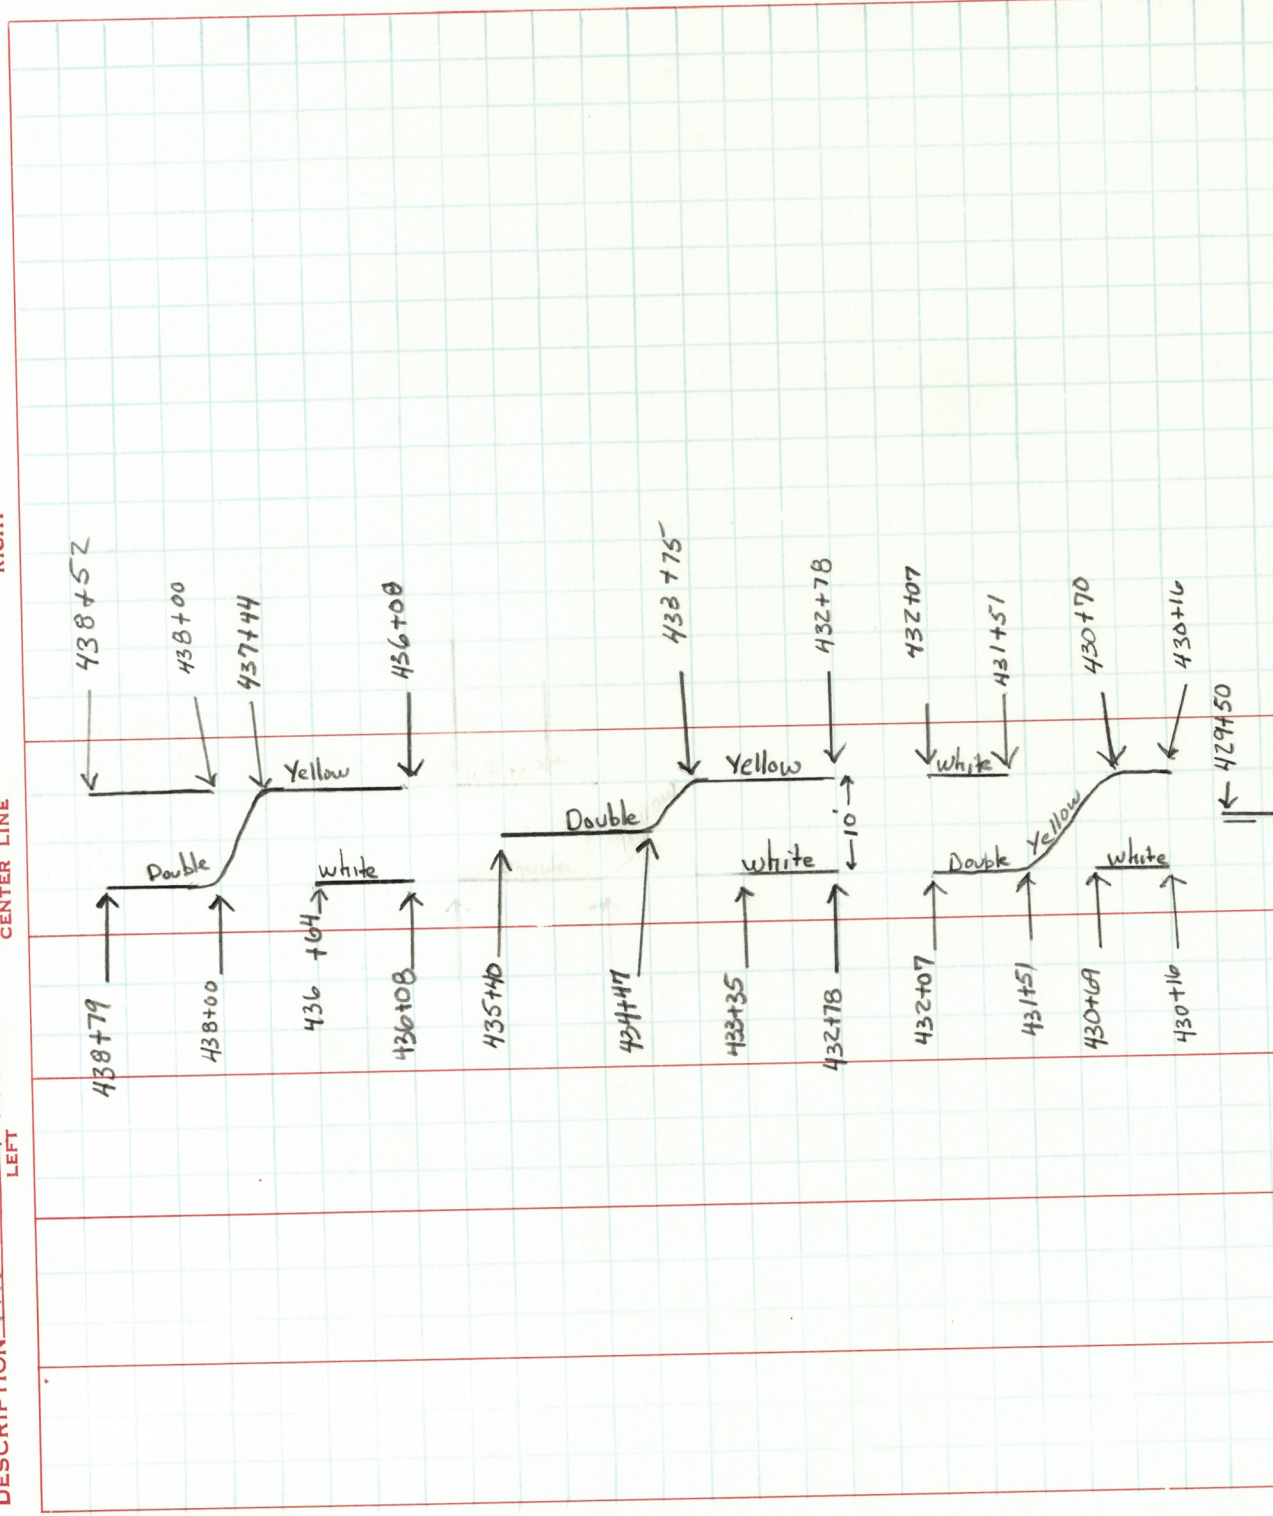

OHIO DEPARTMENT OF TRANSPORTATION

SHEET NO. 13-15

PERSONNEL

TITLE

PERSONNEL TITLE

COUNTY

DATE

10-29-92

LOENRKE

2

S. R.

WEATHER

Cloudy

Crew

SEC.

TEMP.

+44


DESCRIPTION

PAVT MARKINGS

CENTER LINE

RIGHT

JOB NO.

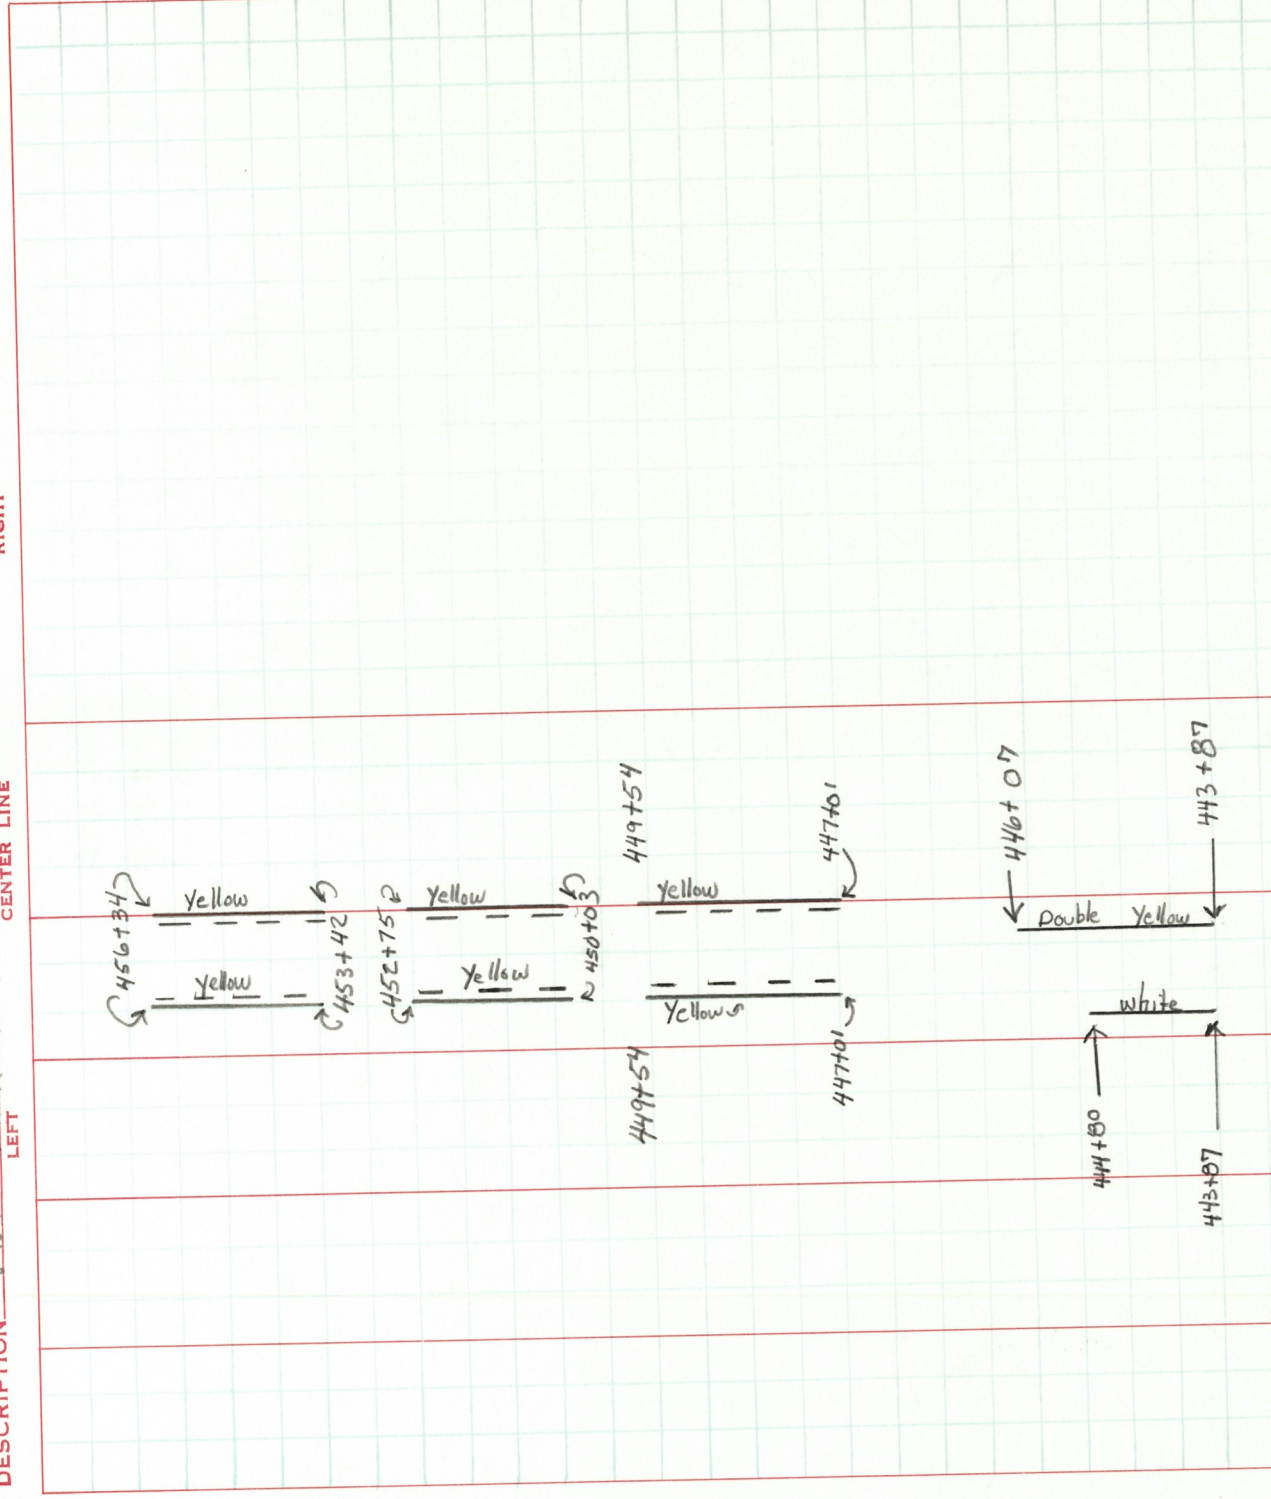


OHIO DEPARTMENT OF TRANSPORTATION

SHEET NO. 14-15

LD-5 Rev. 2-83

PERSONNEL	TITLE	PERSONNEL	TITLE	COUNTY	DATE	WEATHER	TEMP.
LOEHRKE				Will.	10-29-92	Cloudy	+45
				S. R.	107		
				SEC.	7.67		

DESCRIPTION	PAVT	MARKINGS	CENTER LINE	RIGHT	JOB NO.
-------------	------	----------	-------------	-------	---------

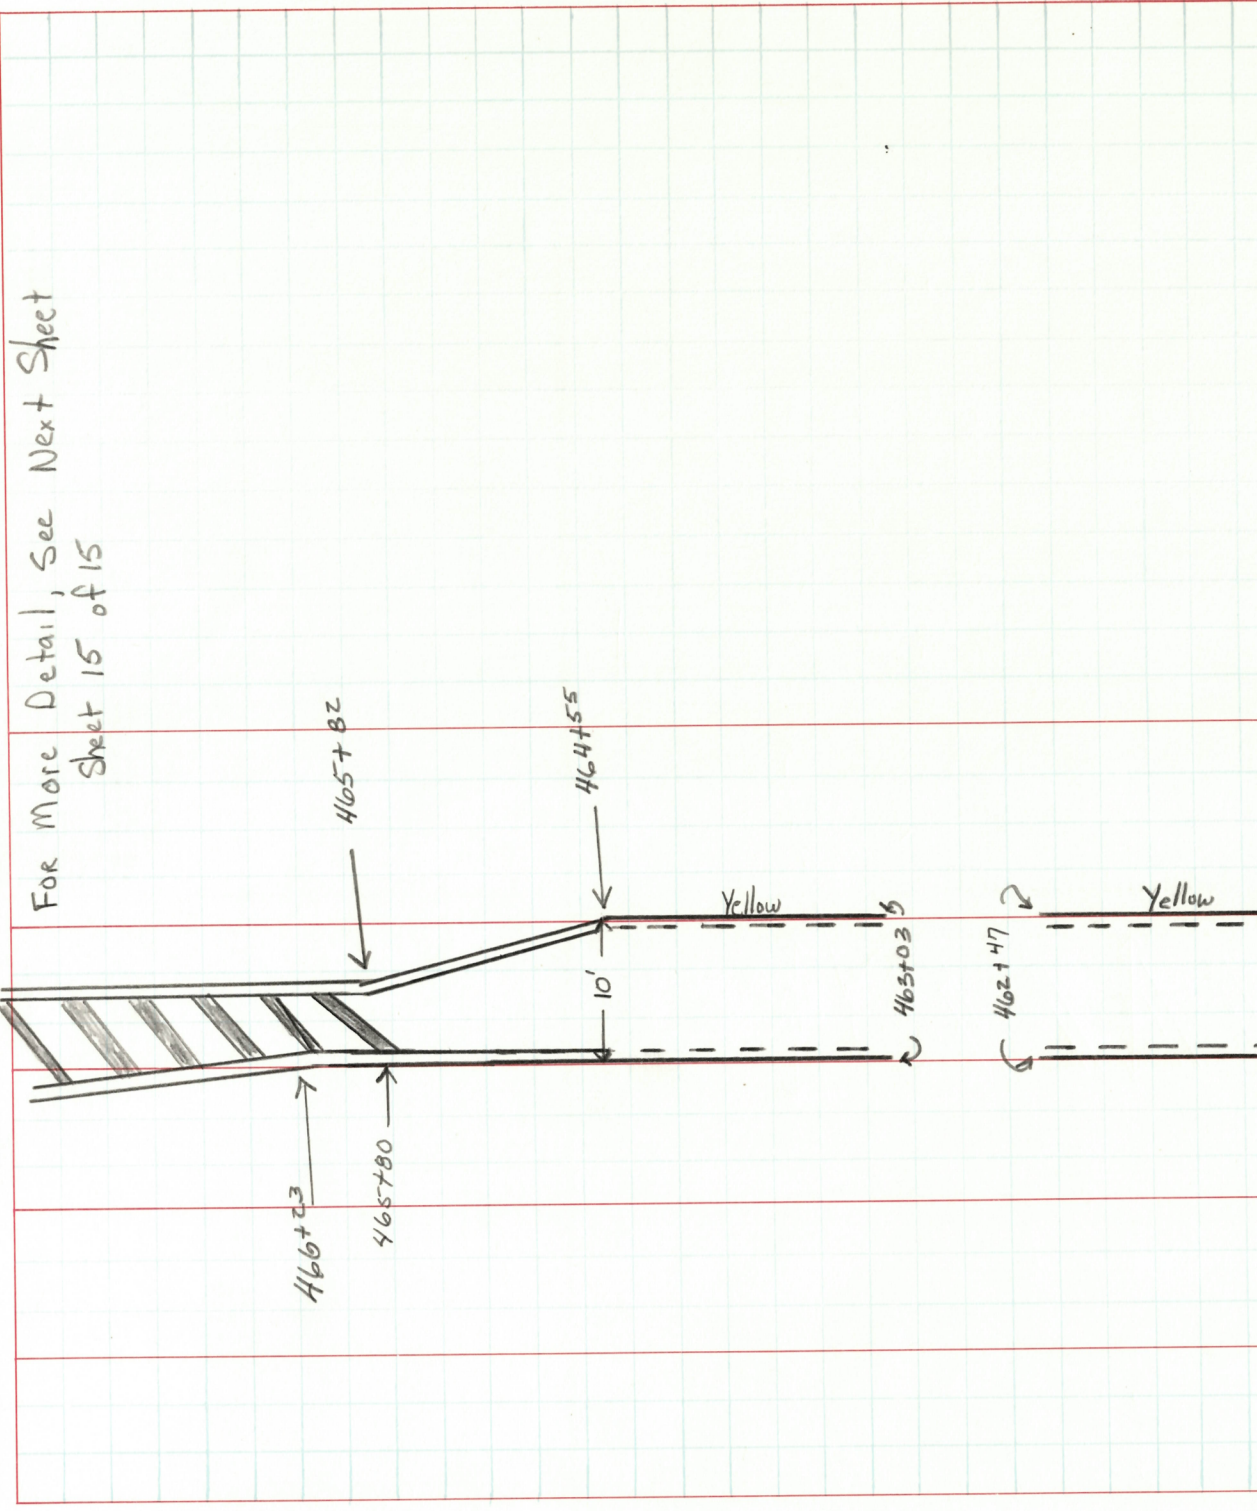

OHIO DEPARTMENT OF TRANSPORTATION

SHEET NO. 15-15

PERSONNEL	TITLE	PERSONNEL	TITLE	COUNTY	DATE
LOEHRKE		Will		10-29-92	
CREW		S. R.	107	WEATHER	Cloudy
		SEC.	7.67	TEMP.	+48

DESCRIPTION	PAVT	MARKINGS	CENTER LINE	RIGHT	JOB NO.
-------------	------	----------	-------------	-------	---------

