

PRIORITY NO. 35PART OF SHEET OF COUNTY WilliamsROUTE SR 107 SECTION 09.85BEGIN LOG (SLM) 9.85CALC. 520+08 - Meas. 520+08
TERMINII E Approach WIL-107-0979 (Butt)END LOG (SLM) 11.05CALC. 583+44
TERMINII SR 15 Meas. 582+95 (Feather)TOTAL LENGTH 1.20

MILES

MUNICIPALITY MontpelierBEGIN LOG (SLM) 9.85 END LOG (SLM) 10.11MUNICIPALITY BBEGIN LOG (SLM) END LOG (SLM) PROPOSED WORK:
PAVEMENT 1 1/2" - 404SHOULDER 1 1/2" - 404 \$617OTHER

EXISTING DATA:

SLM <u>9.85</u> TO <u>10.11</u>	; PAV'T	WIDTH <u>50'</u> (type <u>404</u>)	, SHLD	WIDTH <u>24</u> (type <u> </u>)
SLM <u>10.11</u> TO <u>11.05</u>	; PAV'T	WIDTH <u>22'</u> (type <u>404</u>)	, SHLD	WIDTH <u>2@30"</u> (type <u>405</u>)
SLM <u> </u> TO <u> </u>	; PAV'T	WIDTH <u> </u> (type <u> </u>)	, SHLD	WIDTH <u> </u> (type <u> </u>)
SLM <u> </u> TO <u> </u>	; PAV'T	WIDTH <u> </u> (type <u> </u>)	, SHLD	WIDTH <u> </u> (type <u> </u>)
STRUCTURES:

STR. NO. <u>None</u>	, WIDTH <u> </u>	, LENGTH <u> </u>	, PROP. WORK <u> </u>
STR. NO. <u> </u>	, WIDTH <u> </u>	, LENGTH <u> </u>	, PROP. WORK <u> </u>
STR. NO. <u> </u>	, WIDTH <u> </u>	, LENGTH <u> </u>	, PROP. WORK <u> </u>
RAILROAD CROSSING:

NAME <u>None</u>	STATION <u> </u>	NO. TRACKS <u> </u>	LENGTH ALONG C L <u> </u> ft
NAME <u> </u>	STATION <u> </u>	NO. TRACKS <u> </u>	LENGTH ALONG C L <u> </u> ft
NAME <u> </u>	STATION <u> </u>	NO. TRACKS <u> </u>	LENGTH ALONG C L <u> </u> ft


MISCELLANEOUS:

NO. RAISED PAVEMENT MARKERS; EDGE OF PAVEMENT 39, CENTERLINE 27
 NO. MAILBOX APPROACHES None, AVERAGE AREA

REMARKS:

PERSONNEL	TITLE	PERSONNEL	TITLE	COUNTY	DATE
<u>Stone</u>				<u>Williams</u>	<u>19 March 87</u>
<u>Crow</u>				S. R. <u>#107</u>	WEATHER <u>Sunny</u>
				SEC. <u>9.85-11.05</u>	TEMP. <u>43°</u>

DESCRIPTION Reconnect Widther LEFT CENTER LINE RIGHT JOB NO.

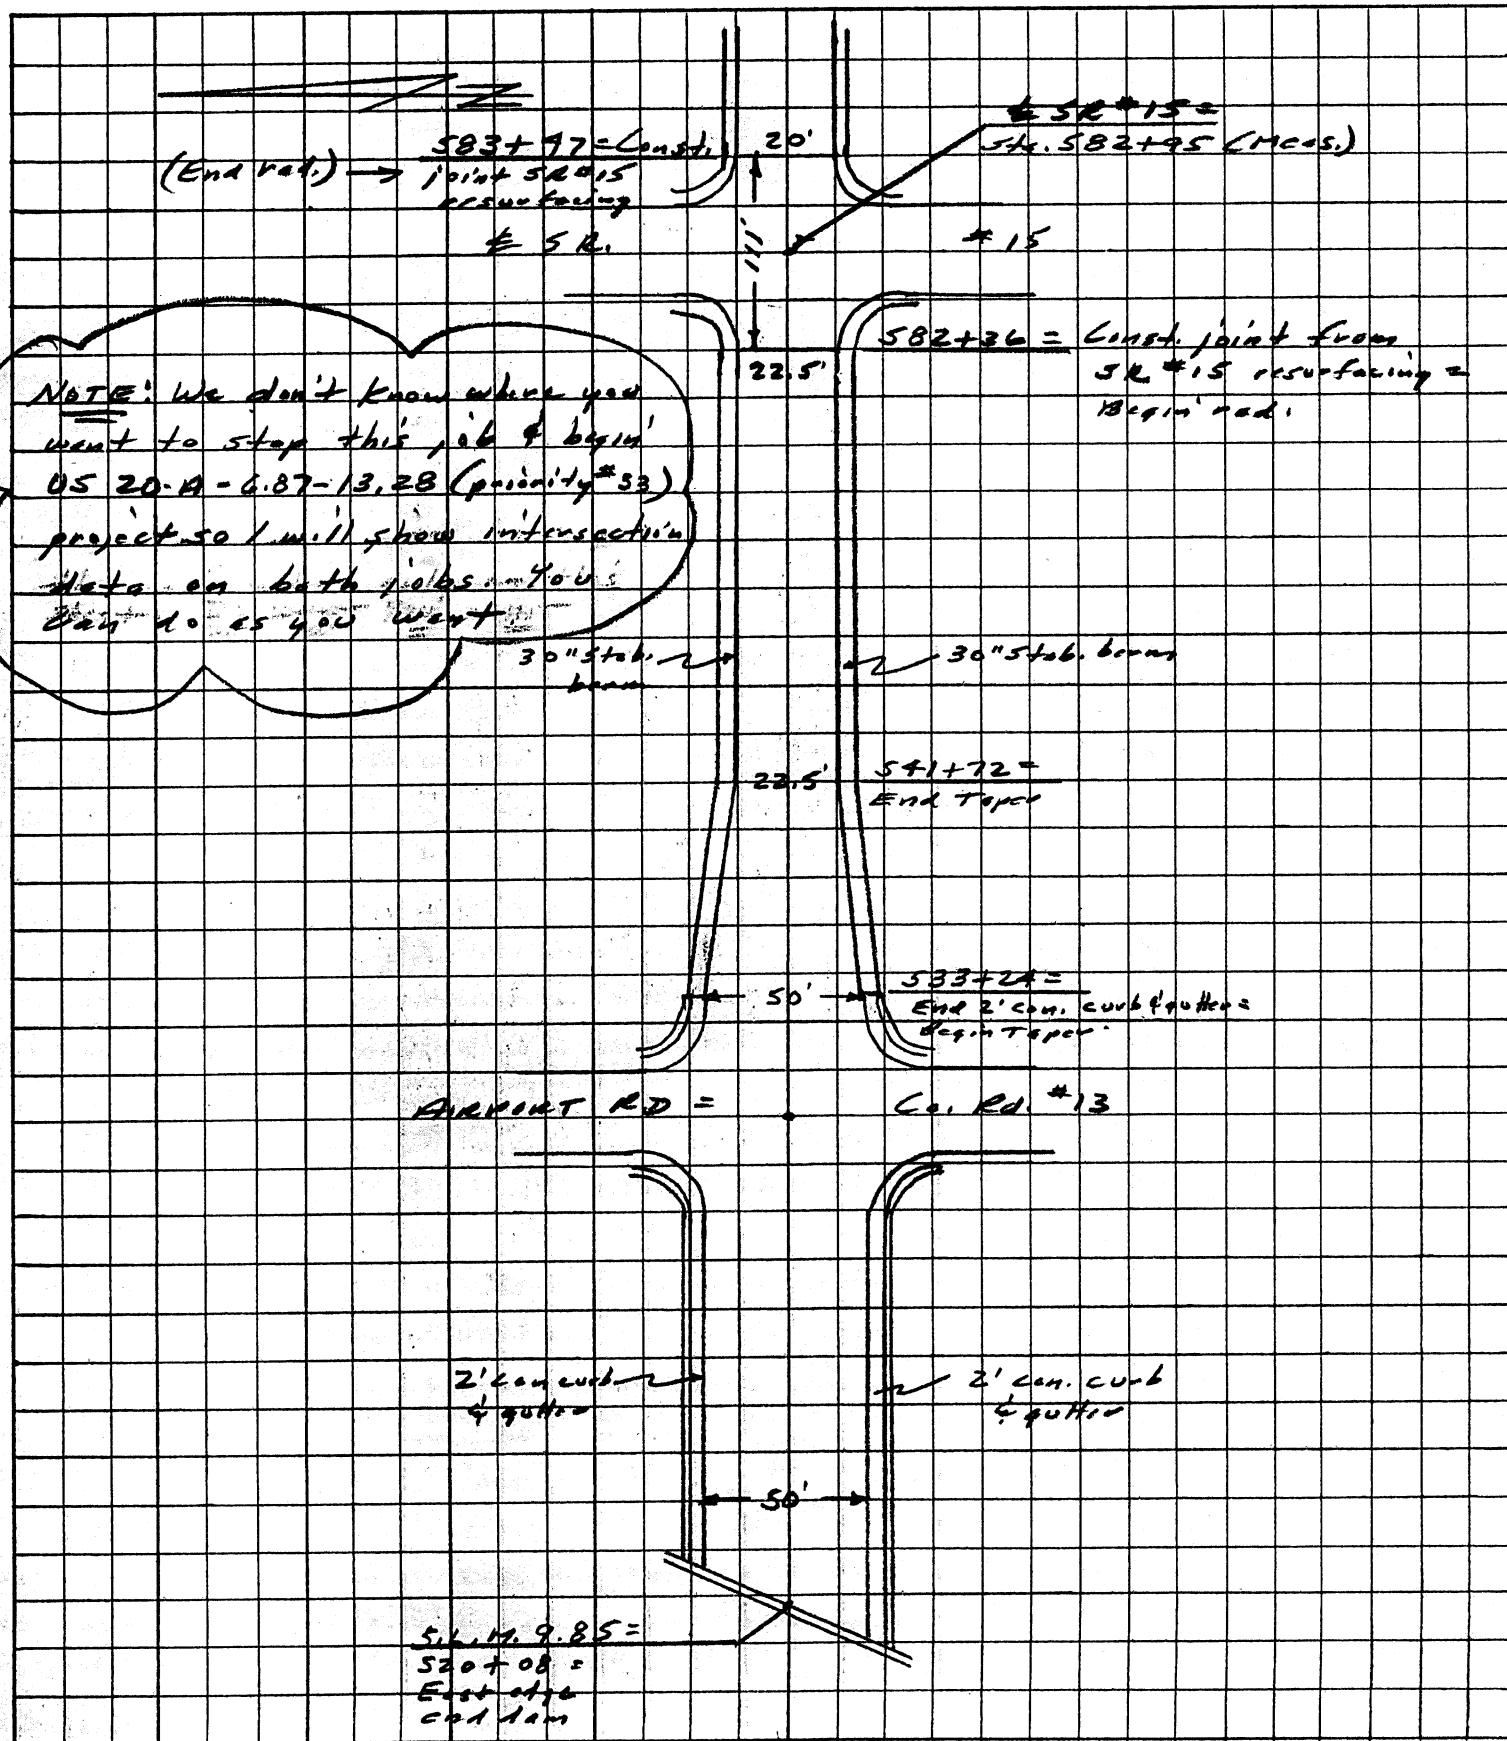

SECTION 9.85-11.05

[illegible]

SECTION 9.85-11.05

R = Raise F = Feather

[illegible]