



O.D.O.T. DISTRICT 2 SURVEY OFFICE (USE ONLY)

PERSONNEL _____ REFERENCE NO. 17 C SHEET 8 OF 25
 NOTES STONE DATE 10/14/80 ROUTE SR 107
 H.C. MICHALAK WEATHER CLOUDY COUNTY WILLIAMS
 R.C. NEUSER TEMP. 59° TOWNSHIP SUPERIOR
 _____ CURTIS _____ SECTION 11
 _____ T 7 N R 2 E

TYPE MONUMENT NAIL
 ON SURFACE - ~~BELOW~~ ON _____
 LEFT - ☉ PAV'T - RIGHT ON _____
16' TO RT S.FACE CURB
 S.L.M. 449+60±
 Grid: Northing: _____ Easting: _____

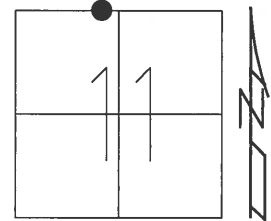

RECORD:
 DNF POINT
 1993, 5/18/05
 12/29/14

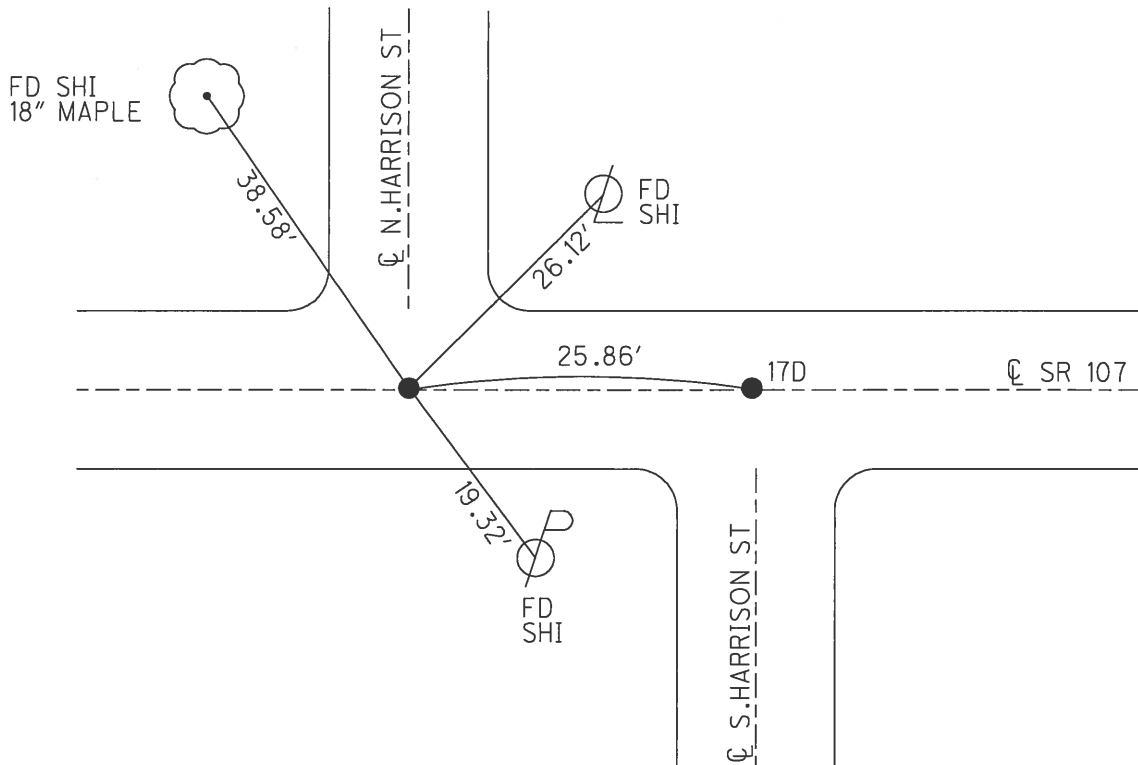


O.D.O.T. DISTRICT 2 SURVEY OFFICE (USE ONLY)


PERSONNEL _____ REFERENCE NO. 17 C SHEET 4 OF 13

NOTES STONE DATE 10/14/80 ROUTE SR 107
 H.C. MICHALAK WEATHER CLOUDY COUNTY WILLIAMS
 R.C. NEUSER TEMP. 59° TOWNSHIP SUPERIOR
CURTIS SECTION 11
 T 7 N R 2 E

TYPE MONUMENT NAIL
 ON SURFACE - ~~BELOW~~ ON _____
 LEFT - ☉ PAV'T - RIGHT ON _____
16' TO RT S.FACE CURB
 S.L.M. 449+60±
 Grid: Northing: _____ Easting: _____

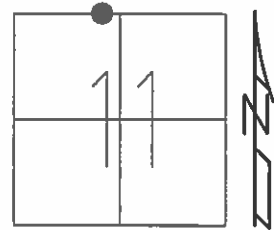

RECORD:
 DNF POINT
 1993, 5/18/05

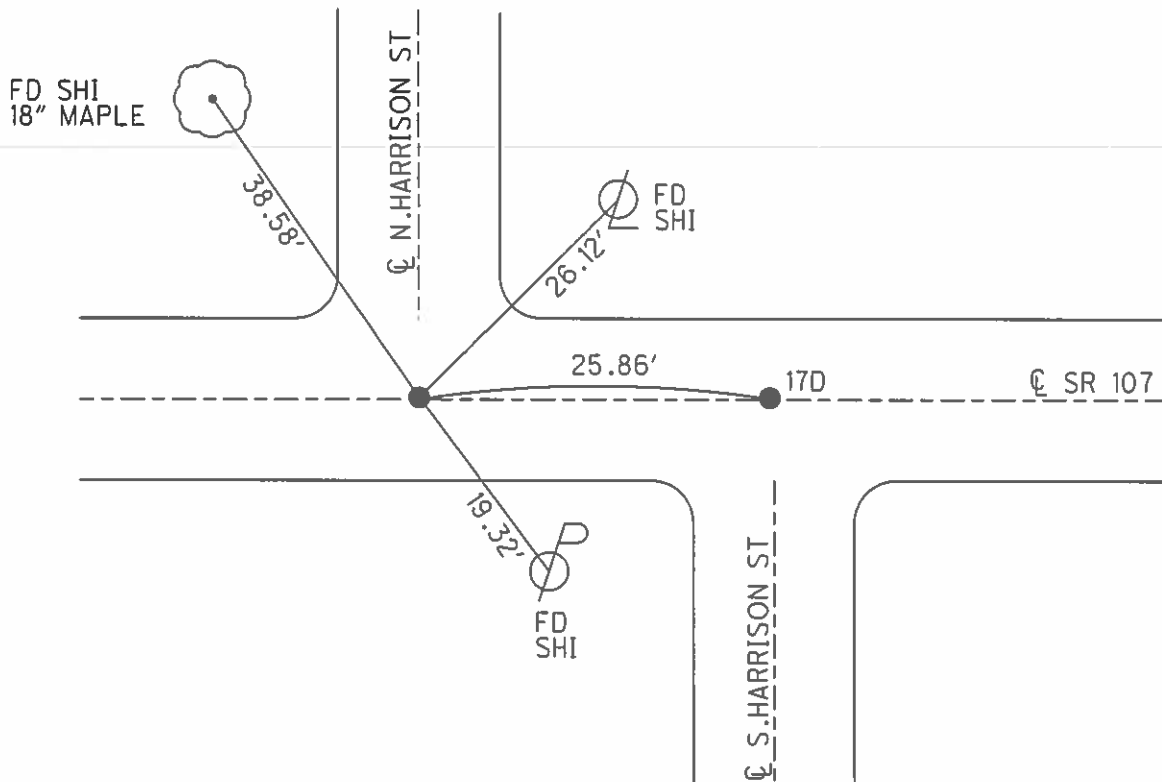

County Williams S.R. 107

Date 14 Oct. 80

Township Superior

Weather cloudy

Section 11

Temp. 59°


T_N, R_E

Personnel J. Stone


R. Michalak

P. Neuse

D. Curtis

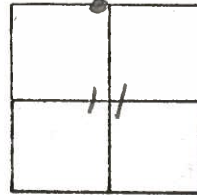

REF. No. 17-C

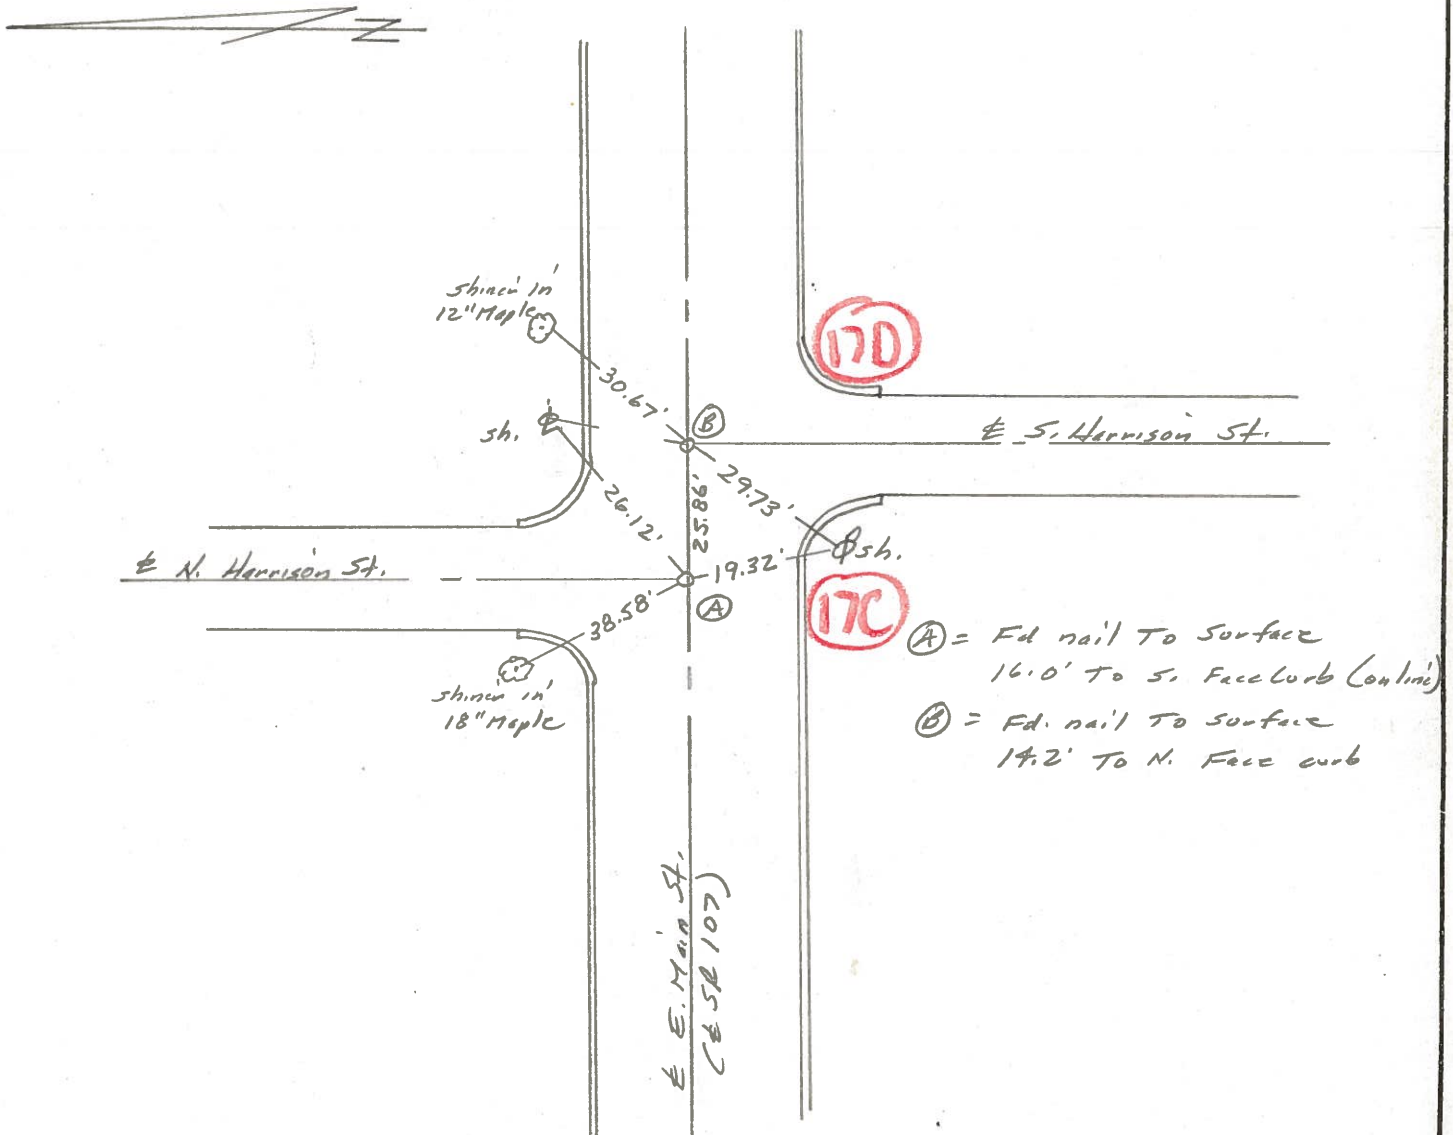

DID NOT FIND during
1993 Resurface Project
5/18/05 RESURFACE PROJECT - DID NOT FIND