

O.D.O.T. DISTRICT 2 SURVEY OFFICE (USE ONLY)

PERSONNEL \_\_\_\_\_ REFERENCE NO. 18 C SHEET 14 OF 25


NOTES HOMAN DATE 4/19/17 ROUTE SR 107  
 H.C. HOMAN WEATHER CLOUDY COUNTY WILLIAMS  
 R.C. HELDMAN TEMP. 65° TOWNSHIP SUPERIOR  
 \_\_\_\_\_ SECTION 11  
 \_\_\_\_\_ T 7 N R 2 E

TYPE MONUMENT \_\_\_\_\_ MONBOX W/IPIN \_\_\_\_\_

~~ON SURFACE~~ - BELOW 2"  
 LEFT - ☉ PAV'T - RIGHT ON, 2' E OF ☉ S  
 - TO - EDGE PAVEMENT


S.L.M. 467+80.97

GRID: NORTHING: 706361.941 EASTING: 1394560.825

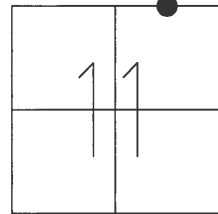

RECORD:  
 FD MON.BOX W/IPIN  
 5/18/05, MB  
 REFD18  
 12/29/14, DCH


WOOD CO.  
 FAIRGROUND  
 ENTRANCE

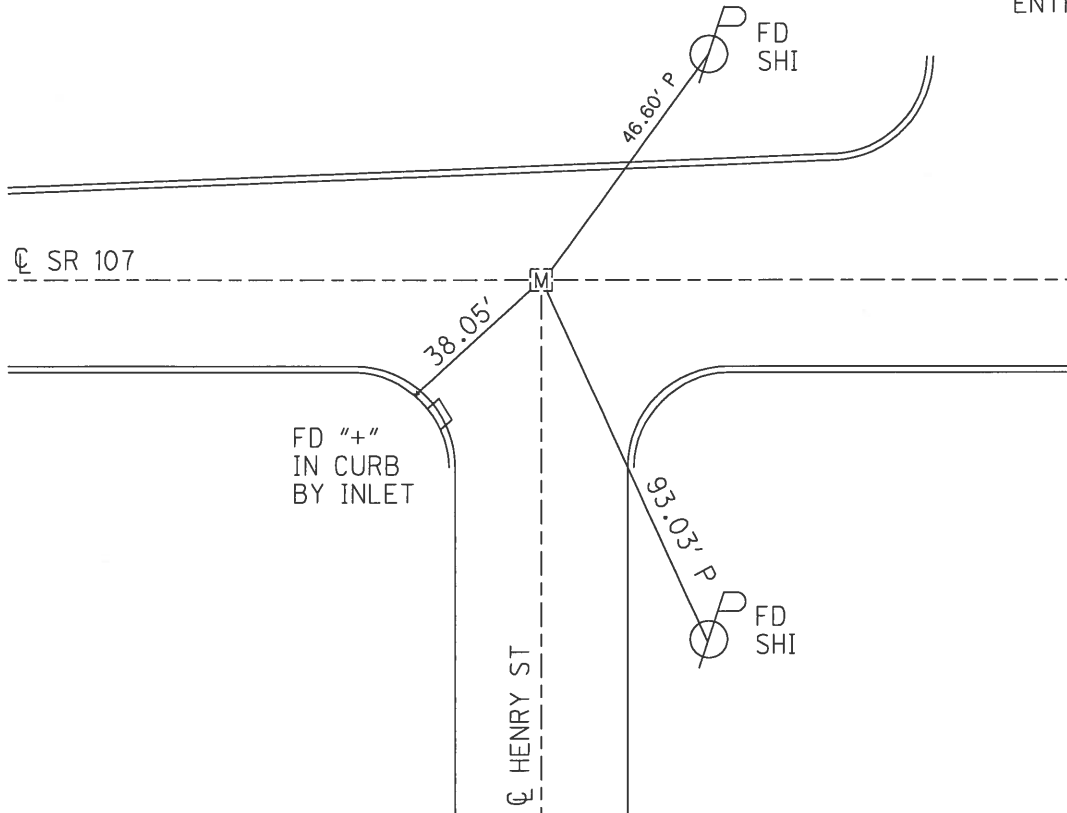

O.D.O.T. DISTRICT 2 SURVEY OFFICE (USE ONLY)

PERSONNEL \_\_\_\_\_ REFERENCE NO. 18 C SHEET 10 OF 13  
 NOTES BARNHISEL DATE 5/18/05 ROUTE SR 107  
 H.C. CANTERBURY WEATHER PT CLOUDY COUNTY WILLIAMS  
 R.C. MIKLOVIC TEMP. 50° TOWNSHIP SUPERIOR  
 SECTION 11  
T 7 N R 2 E


TYPE MONUMENT MONBOX W/IPIN  
~~ON SURFACE~~ - BELOW 2"  
 LEFT - CL PAV'T - RIGHT ON, 2' E OF CL S  
- TO - EDGE PAVEMENT  
 S.L.M. 467+88

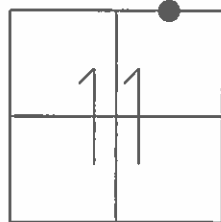

GRID: NORTHING: \_\_\_\_\_ EASTING: \_\_\_\_\_

NOTE:  
 ALL MEASUREMENTS TO  
 CENTER OF MONBOX LID

WOOD CO.  
 FAIRGROUND  
 ENTRANCE

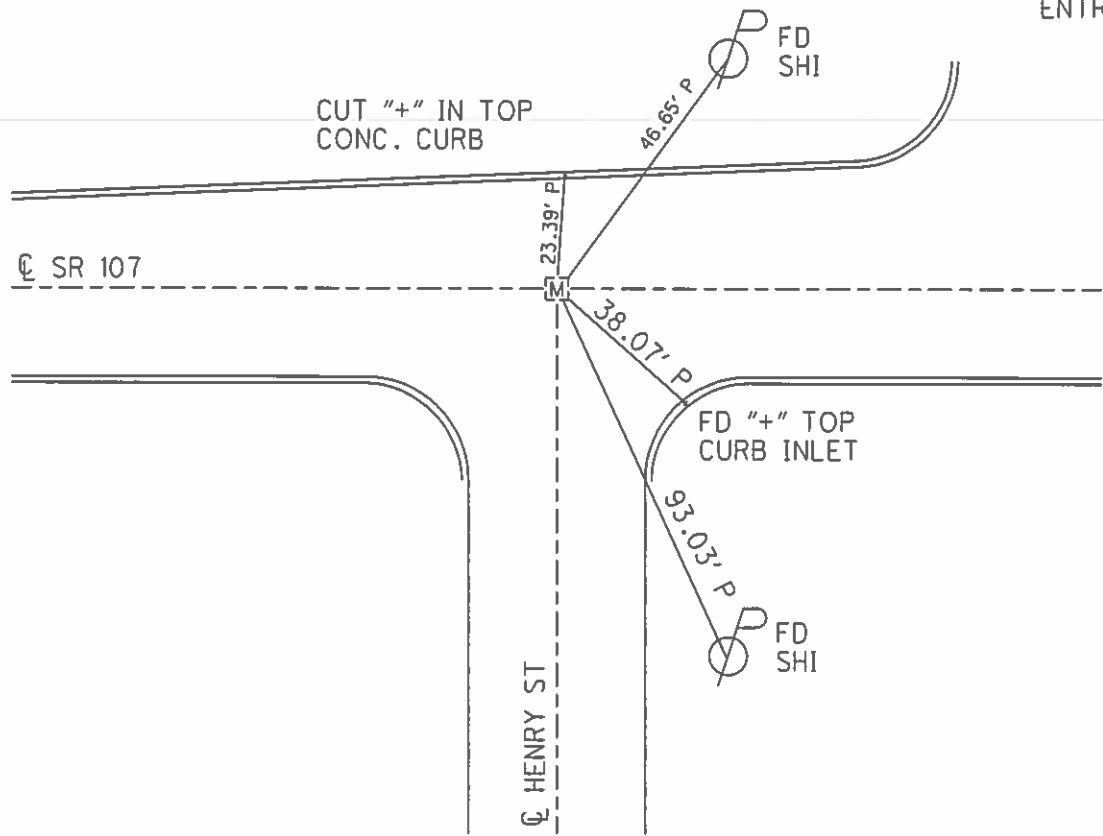

O.D.O.T. DISTRICT 2 SURVEY OFFICE

PERSONNEL

REFERENCE NO. 18-C

SHEET 8 OF 10

NOTES BARNHISEL

DATE 5/18/05

ROUTE S.R.#107

H.C. CANTERBURY

WEATHER PT. CLOUDY

COUNTY WILLIAMS

R.C. MIKLOVIC

TEMP. +50°

TOWNSHIP SUPERIOR

SECTION 11

T    N    R    E



TYPE MONUMENT MON. BOX W/ I. ROD

~~ON SURFACE~~ - BELOW 2" BELOW

~~LEFT -~~ CL PAV'T - ~~RIGHT~~ CL PAV'T.

           TO            EDGE PAVEMENT

S.L.M.                                 467+88                                 2' E. OF CL OF HENRY ST.

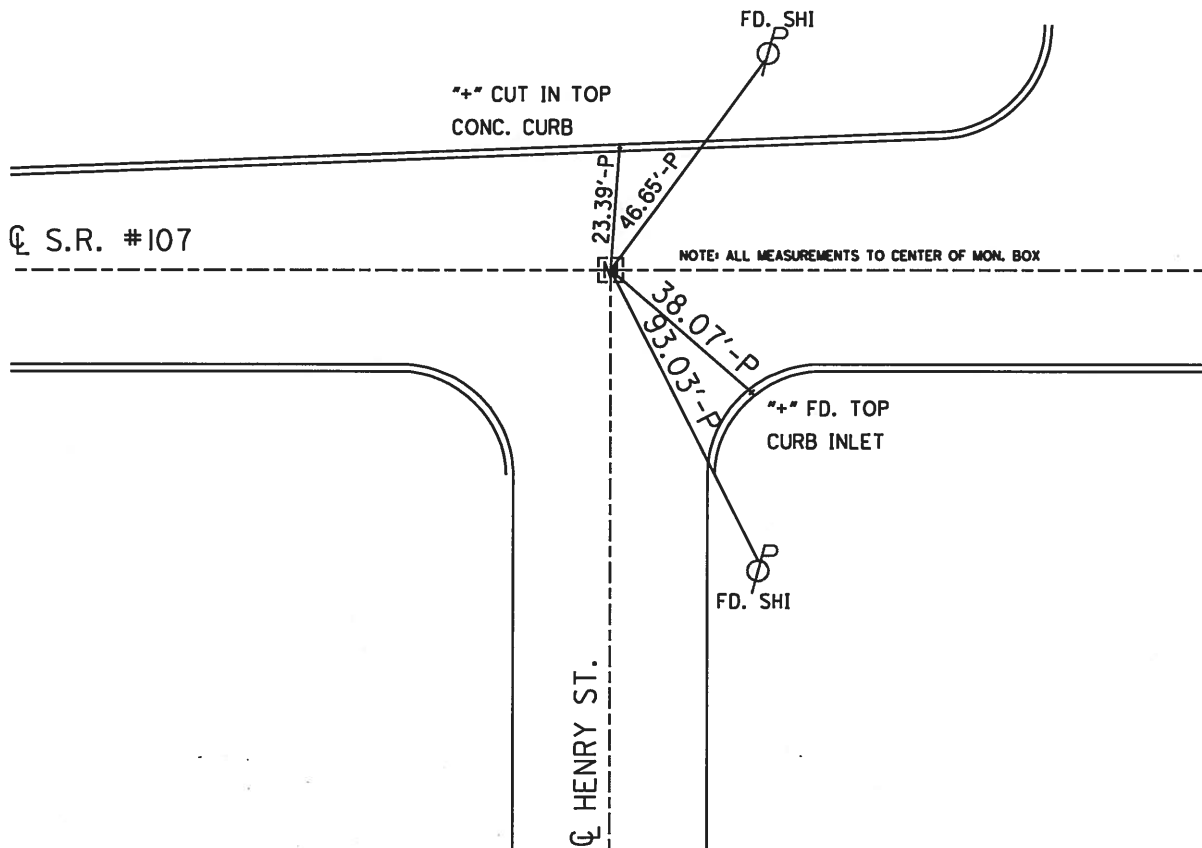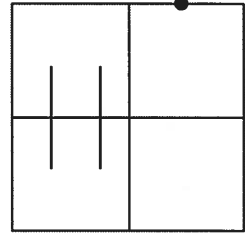

# O.D.O.T. DISTRICT 2 SURVEY OFFICE

PERSONNEL

REFERENCE NO. \_\_\_\_\_

SHEET 1 OF 2

NOTES D. CURTIS

H.C. J. HOUSEHOLDER

DATE 4-20-90

ROUTE 5.12, #107

R.C. B. AHMAD

WEATHER MILD

COUNTY WILLIAMS

TEMP. 60°

TOWNSHIP SUPERIOR

SECTION 11

T \_\_\_\_\_ R \_\_\_\_\_


TYPE MONUMENT MON. BOX

ON SURFACE - BELOW ON SURFACE


LEFT- & PAV'T. - RIGHT & PAV'T

TO \_\_\_\_\_ EDGE PAVEMENT

S.L.M. 467+03 (8.85)

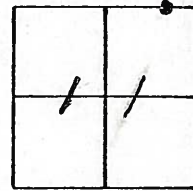

NOTE: ALL MEASUREMENTS TO CENTER OF MON. BOX

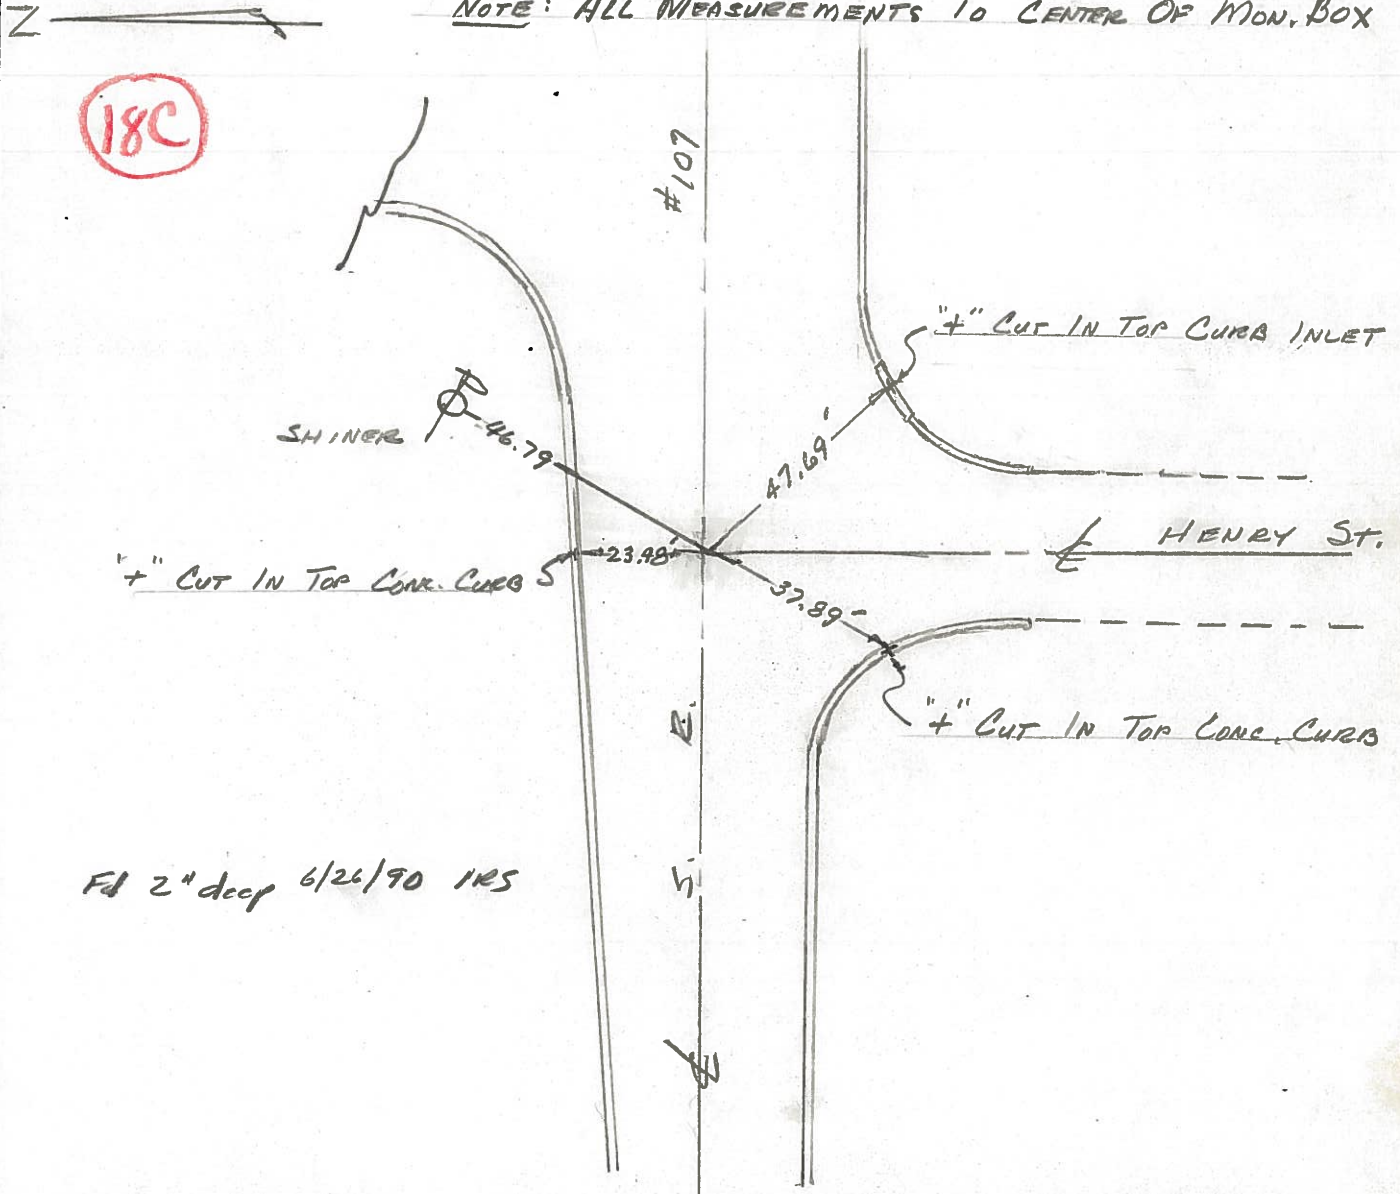

Fd 2" deep 6/26/90 IRS

18C