




PERSONNEL TITLE PERSONNEL TITLE  
 Red Beach \_\_\_\_\_  
 Newcomb \_\_\_\_\_  
 Knape \_\_\_\_\_  
 Wise \_\_\_\_\_

COUNTY Williams DATE Feb 1969  
 S. R. 107 WEATHER \_\_\_\_\_  
 SEC. 8.95 - 11.05 TEMP. \_\_\_\_\_

DESCRIPTION ALIGNMENT JOB NO. 02734

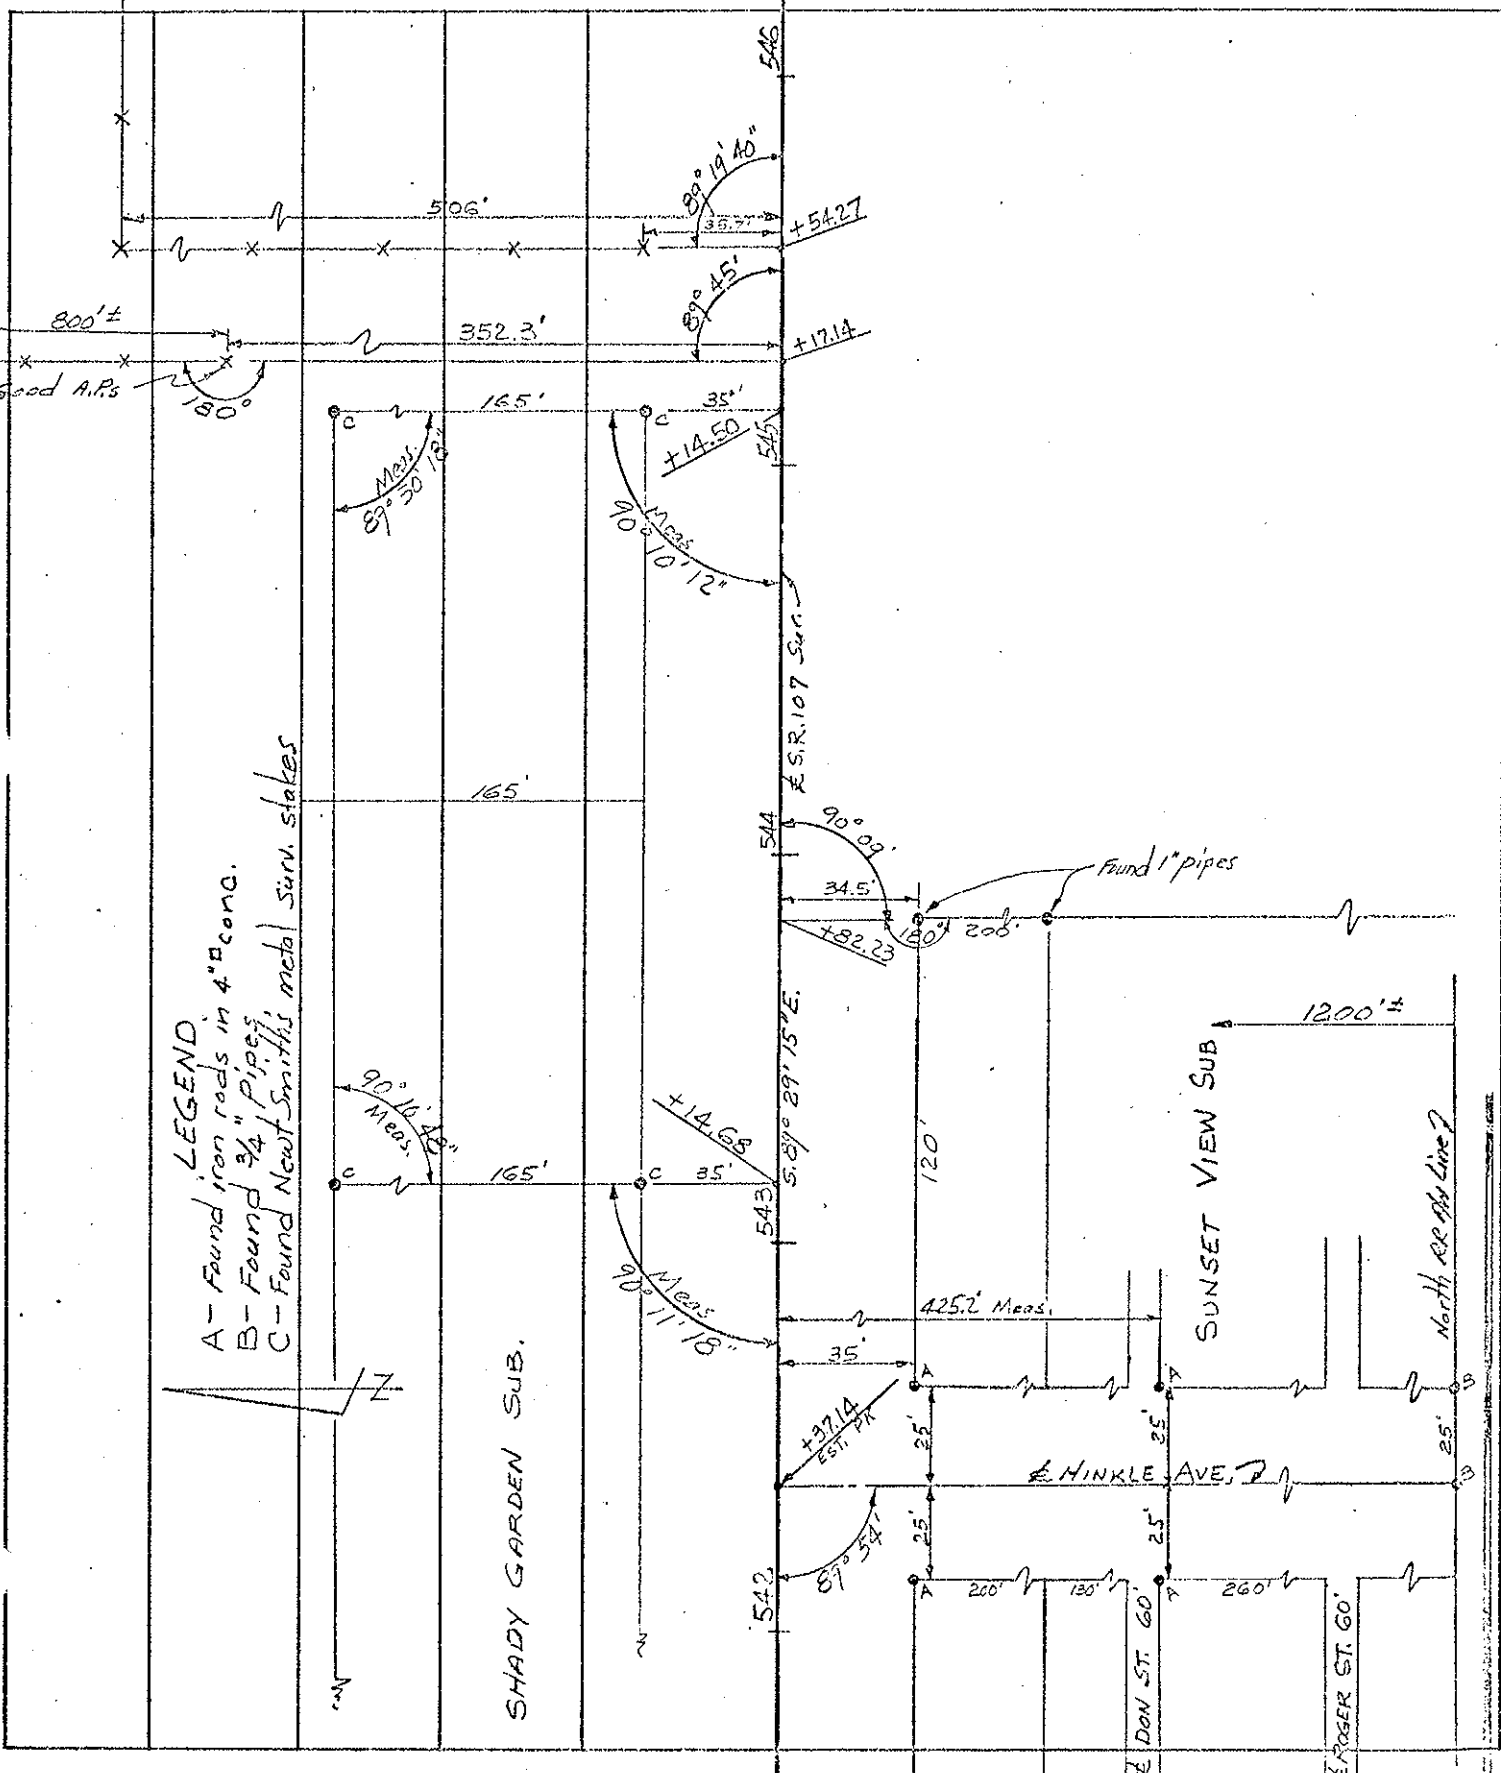

LEGEND  
 A - Found iron rods in 4" conc.  
 B - Found 3/4" pipes  
 C - Found Newt Smith's metal surv. stakes

SHADY GARDEN SUB.

SUNSET VIEW SUB.

HINKLE AVE.


DON ST. GO.

ROGER ST. GO.

North RR Old Line

PERSONNEL	TITLE	PERSONNEL	TITLE	COUNTY	DATE
Red Beach				Williams	Feb '69
Newcomb				S. R. 107	WEATHER
Knappe				SEC. 8.95-11.05	TEMP.
Wise					

DESCRIPTION ALIGNMENT JOB NO. 02734

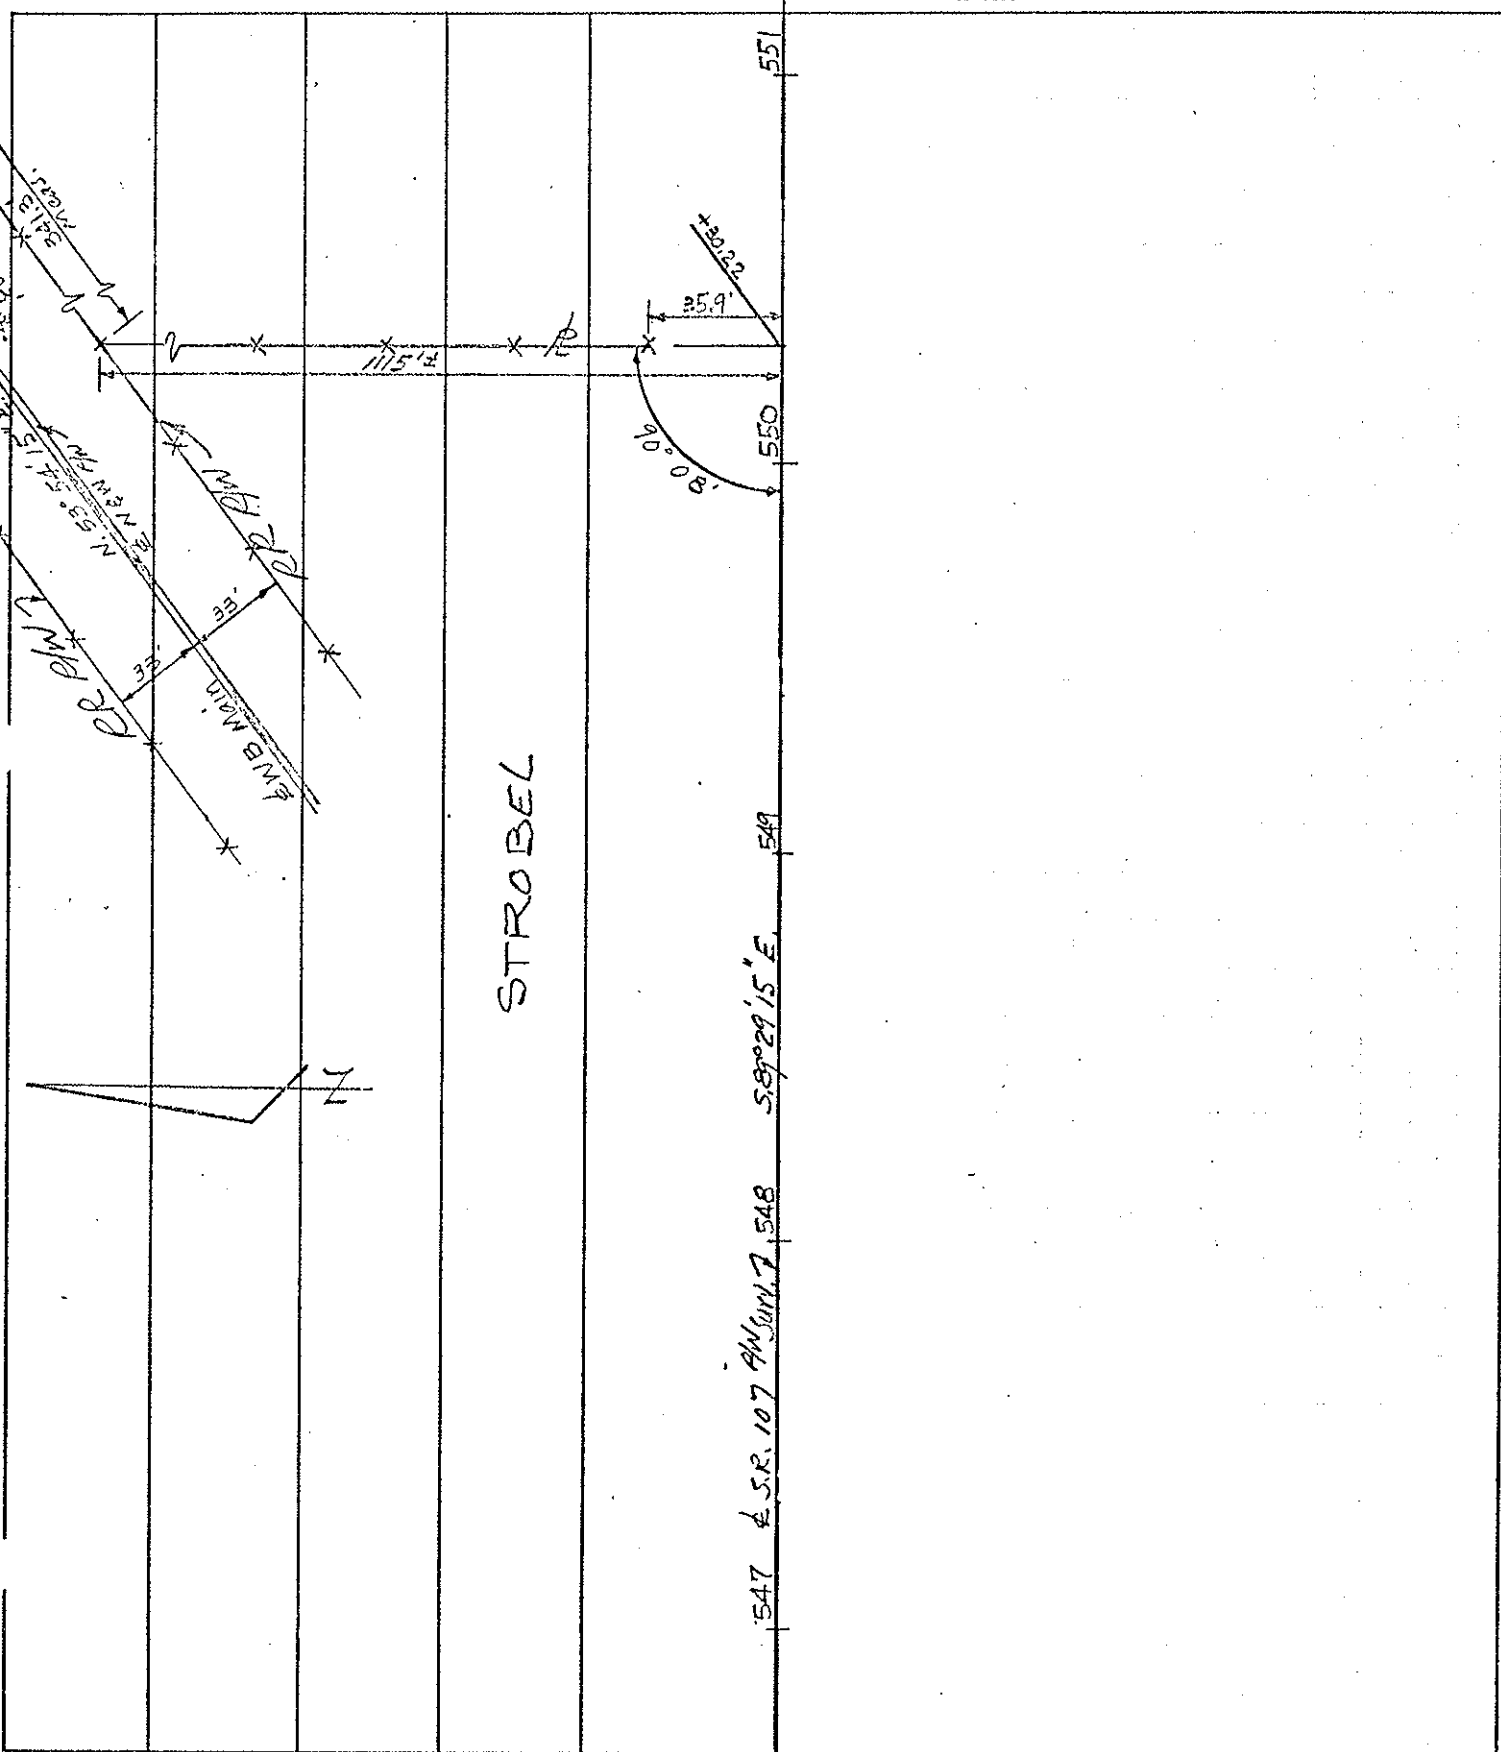

PERSONNEL TITLE PERSONNEL TITLE  
 Red Beach /  
 Newcomer  
 Knape  
 Wise

COUNTY Williams DATE Feb '69  
 S. R. 107 WEATHER \_\_\_\_\_  
 SEC. 8.95-11.05 TEMP. \_\_\_\_\_

DESCRIPTION ALIGNMENT JOB NO. 02734

