

O.D.O.T. DISTRICT 2 SURVEY OFFICE (USE ONLY)

PERSONNEL

REFERENCE NO. 22

SHEET 31 OF 31

NOTES JAMES
 H.C. LEU
 R.C. JAMES

DATE 3/5/19
 WEATHER CLOUDY
 TEMP. 14°

ROUTE SR 107
 COUNTY WILLIAMS
 TOWNSHIP JEFFERSON
 SECTION 6
 T 7 N R 3 E

DWG BY NIESE PID 101346

TYPE MONUMENT MAG/WASHER

ON SURFACE - ~~BELOW~~ ON

OFFSET C PAVEMENT ON LT : RT
10.5' TO LT EDGE PAVEMENT


STATION: 557+00.20

HORZ. DATUM: NAD83(2011)


GEOID: 2012A

GRID: NORTHING: 706196.052

EASTING: 1403477.413

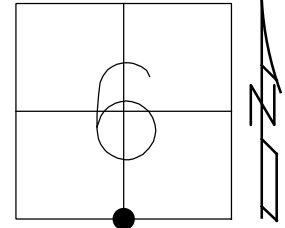

RECORD:
 FD SM.R.R.SPIKE
 10/21/02, MB
 SET MAG/WASHER
 8/25/03, MB
 SET MAG/WASHER
 11/13/19, JLL

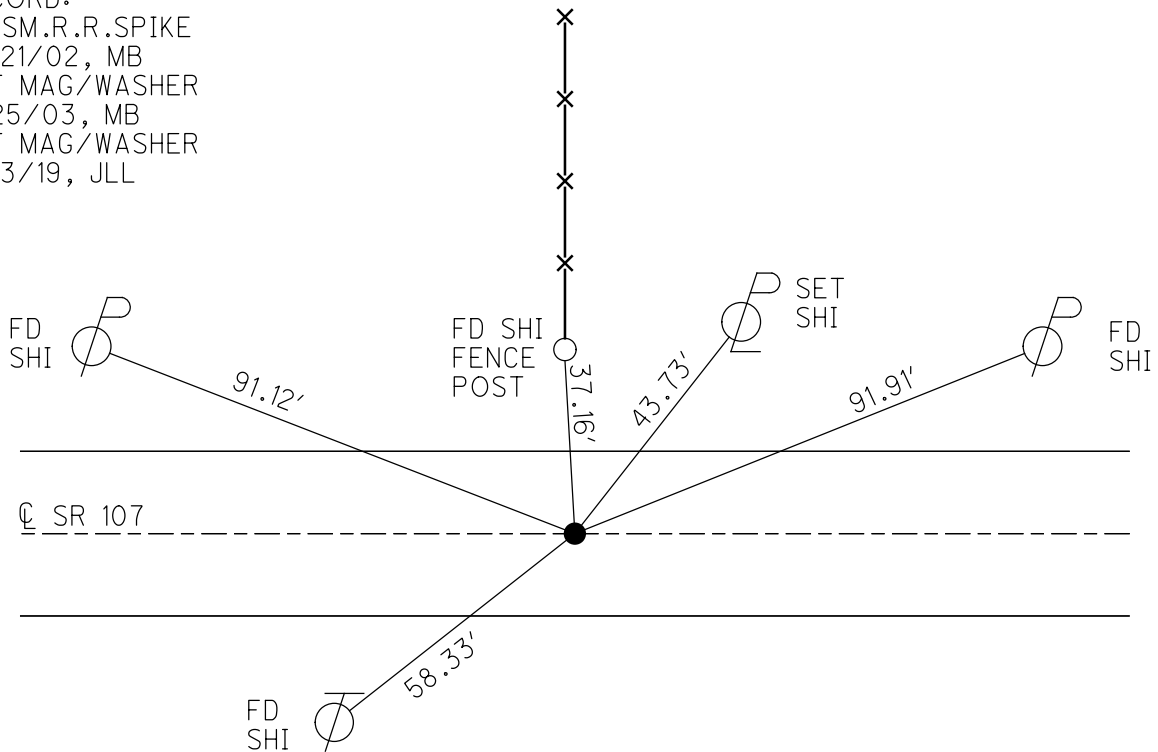

O.D.O.T. DISTRICT 2 SURVEY OFFICE

PERSONNEL _____

REFERENCE NO. 22 SHEET _____ OF _____

NOTES BARNHISEL

H.C. CANTERBURY

R.C. BRUMBAUGH

DATE 10-21-02

WEATHER SUN

TEMP. +37°

ROUTE S.R. # 107

COUNTY WILLIAMS

TOWNSHIP JEFFERSON

SECTION 6

T 7 N R 3 E



TYPE MONUMENT Sm. R.R. SPK.

ON SURFACE - BELOW SURFACE

LEFT - ♀ PAV'T. - RIGHT ♀

10.5 TO LT. EDGE PAVEMENT

S.L.M. 557+00.20

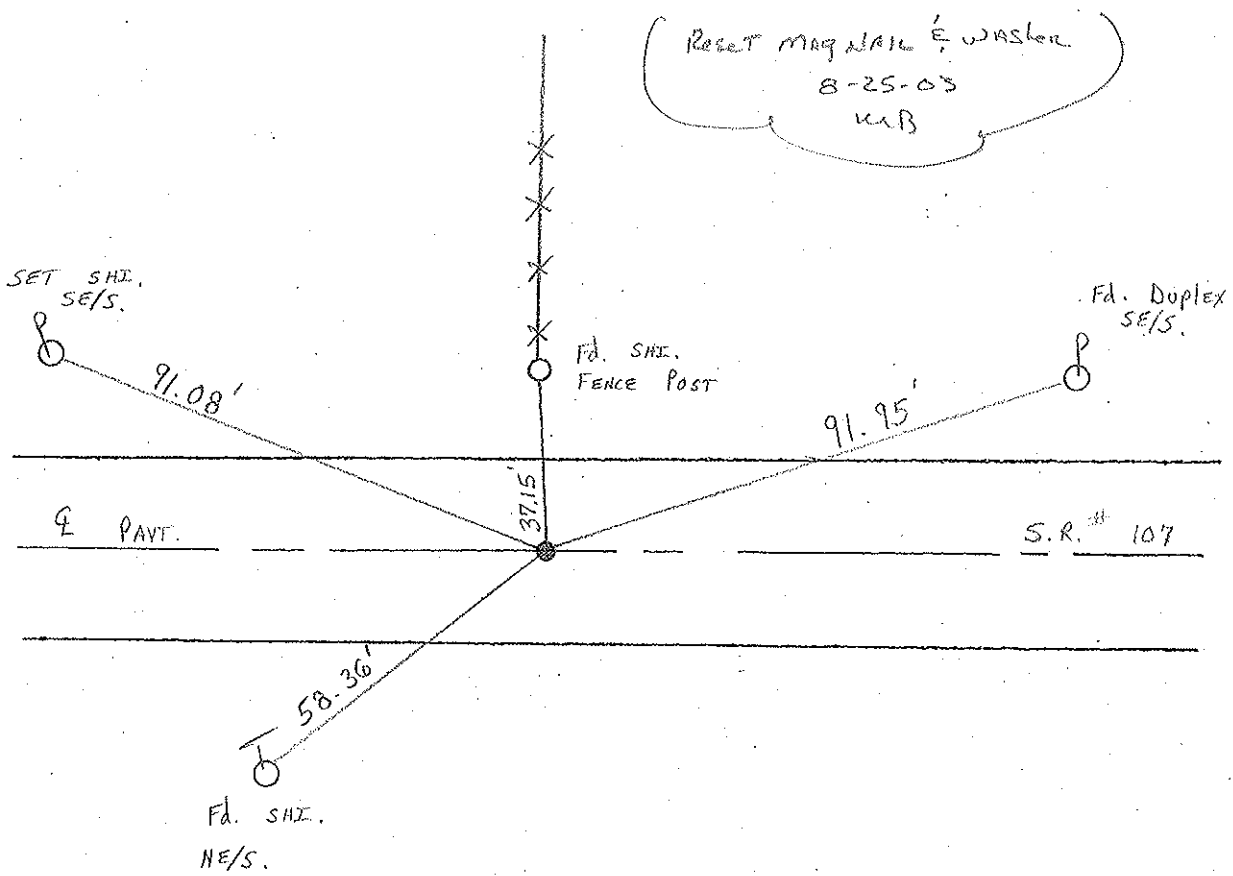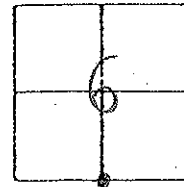

O.D.O.T. DISTRICT 2 SURVEY OFFICE

PERSONNEL

REFERENCE NO. 22

SHEET 7 OF 7

NOTES BARNHISEL

H.C. VAN DUSEN

R.C. CORDES

DATE 12-6-93

WEATHER RAIN

TEMP. +40°

ROUTE 107

COUNTY WILLIAMS

TOWNSHIP JEFFERSON

SECTION 6

T 7 N R 3 E



TYPE MONUMENT Sm RR Spk

ON SURFACE - ~~BELOW~~ yes

~~LEFT - & PAV'T. - RIGHT~~ yes

10.5 TO LT EDGE PAVEMENT

S.L.M. 557+00.20

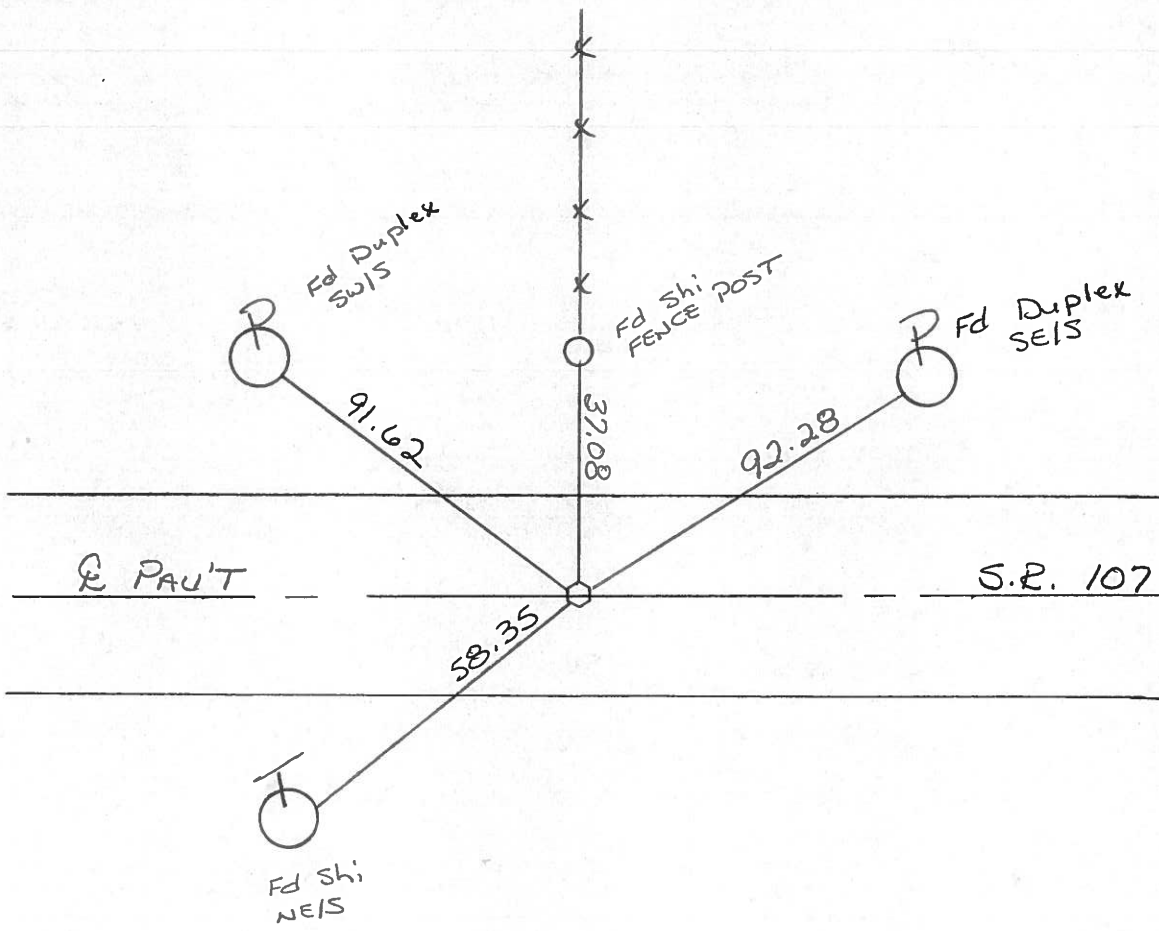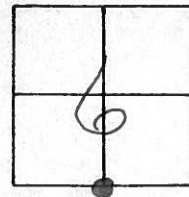

O.D.O.T. DISTRICT 2 SURVEY OFFICE

PERSONNEL _____

REFERENCE NO. 22

SHEET 2 OF 2

NOTES STONE

H.C. §

R.C. CREW

DATE 5-7-90

WEATHER MILD

TEMP. 70°

ROUTE SR #107

COUNTY WILLIAMS

TOWNSHIP _____

SECTION _____

T _____ R _____



TYPE MONUMENT SM. R.R. SPK.

ON SURFACE - ~~BELOW~~ ON SURFACE

LEFT- & PAV'T. - RIGHT & PAV'T

TO _____ EDGE PAVEMENT

S.L.M. 556 + 32

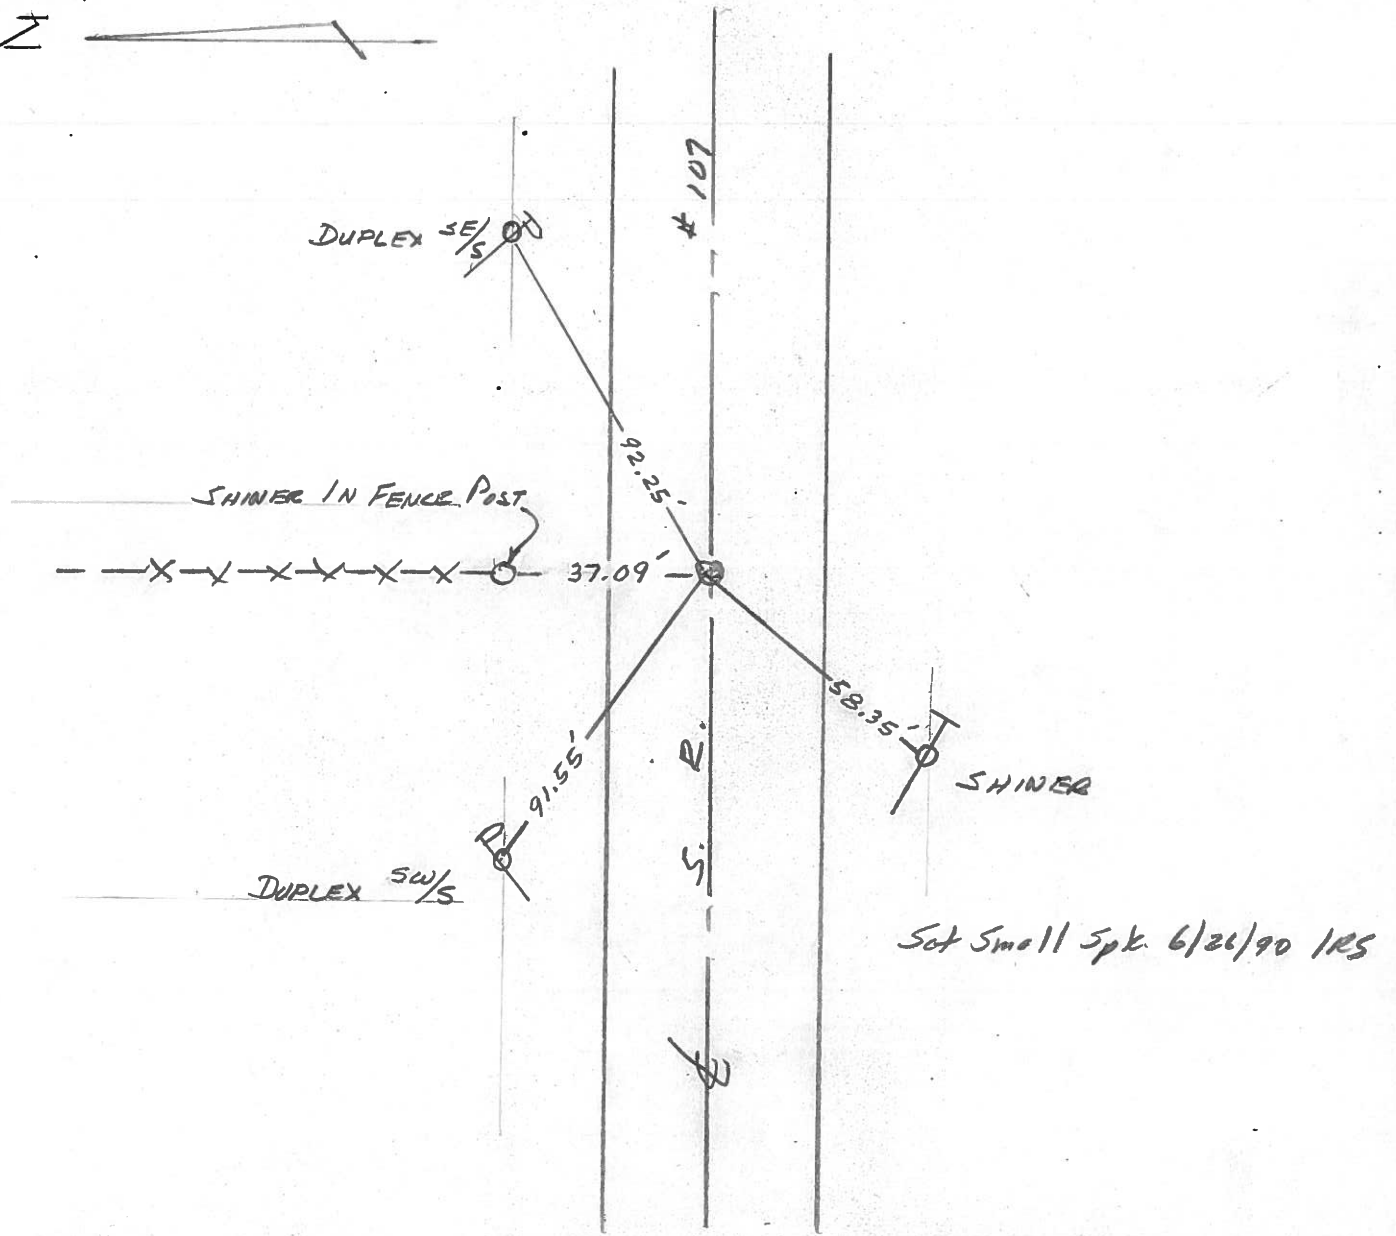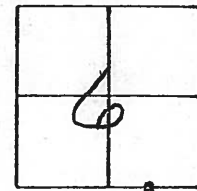

ODOT. DISTRICT 2 SURVEY OFFICE

SHEET 6 OF

County Williams S.R. 107

Date 14 Oct. 80

Township Jefferson

Weather Cloudy

Section N¹/₄ Cor. Sec. 7

Temp. 58°


T N, R E

Personnel L. Stone


R. Michalok

P. Newser

D. Curtis

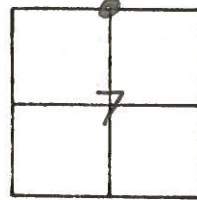

REF. NO. 22




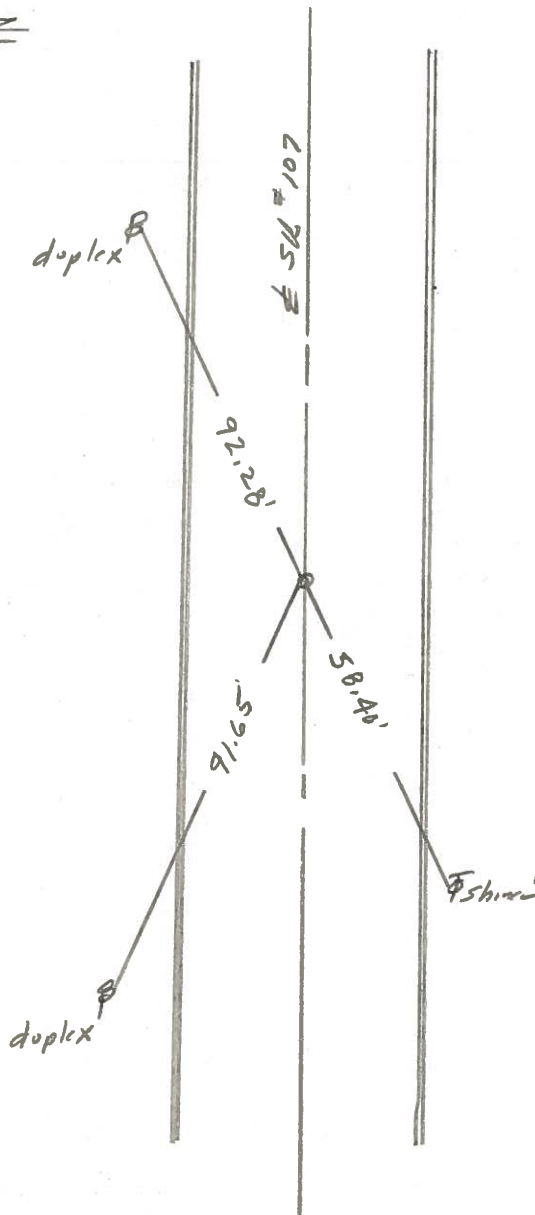


Fd. 1" I. P. pi To Surface
11.0' to N. edge put.
11.2' to S. edge put.

PERSONNEL	TITLE	PERSONNEL	TITLE
Red Beach			
Newcomb			
Knappe			
Wise			

COUNTY Williams DATE 17 Mar '69
 S. R. 107 WEATHER _____
 SEC. 8.95-11.05 TEMP. _____


DESCRIPTION CONTROL POINTS JOB NO. 02734

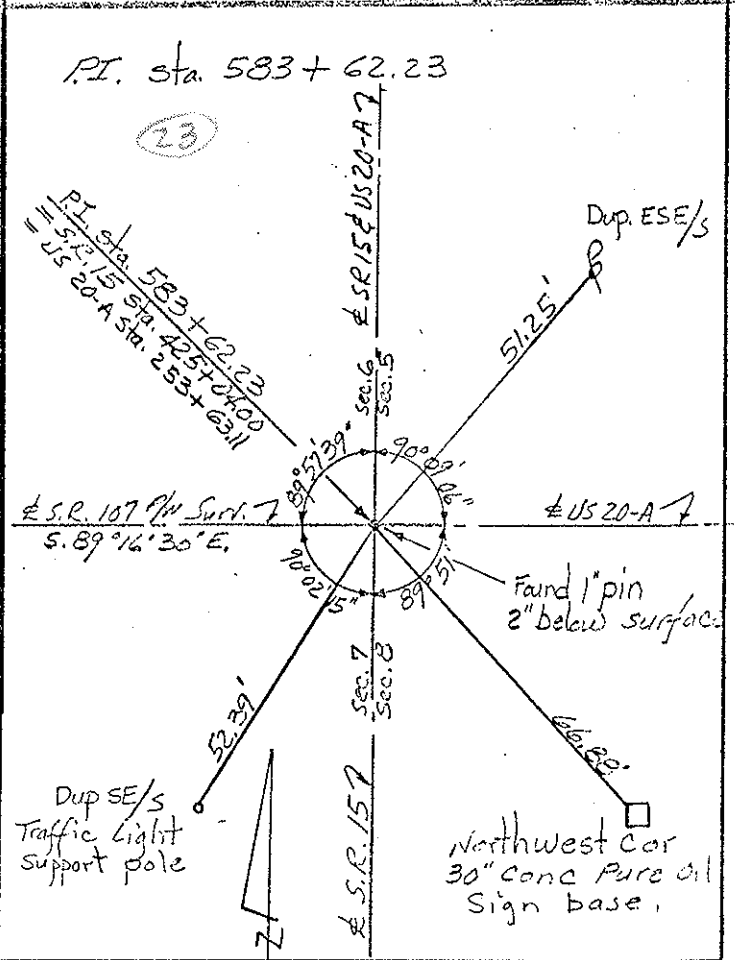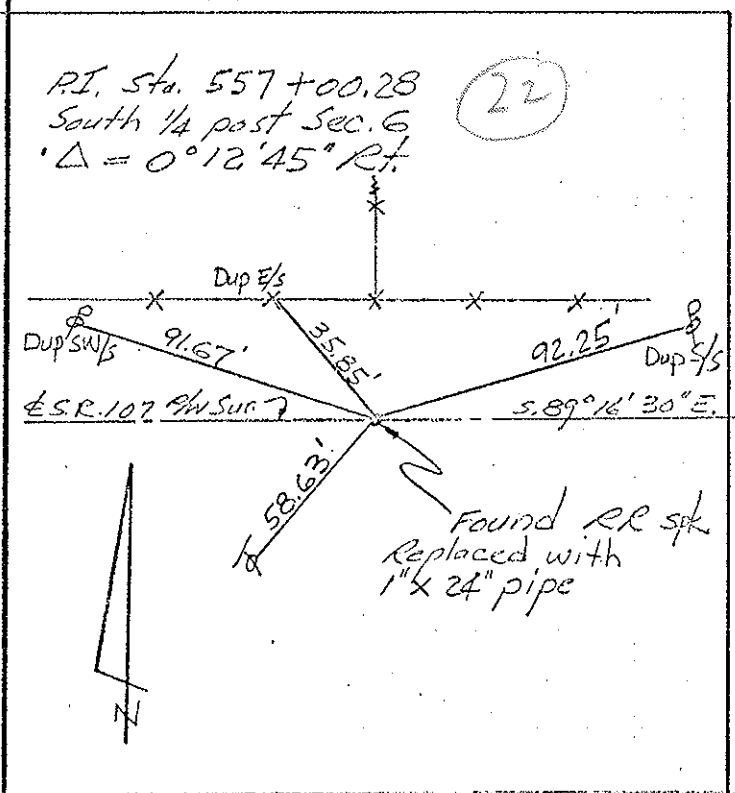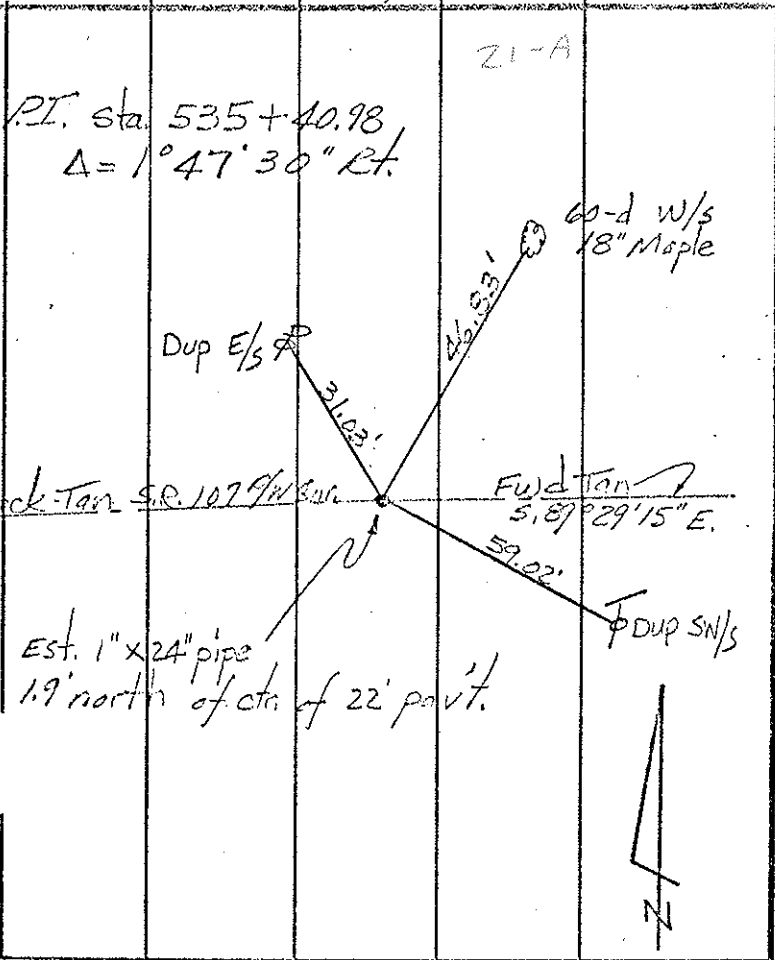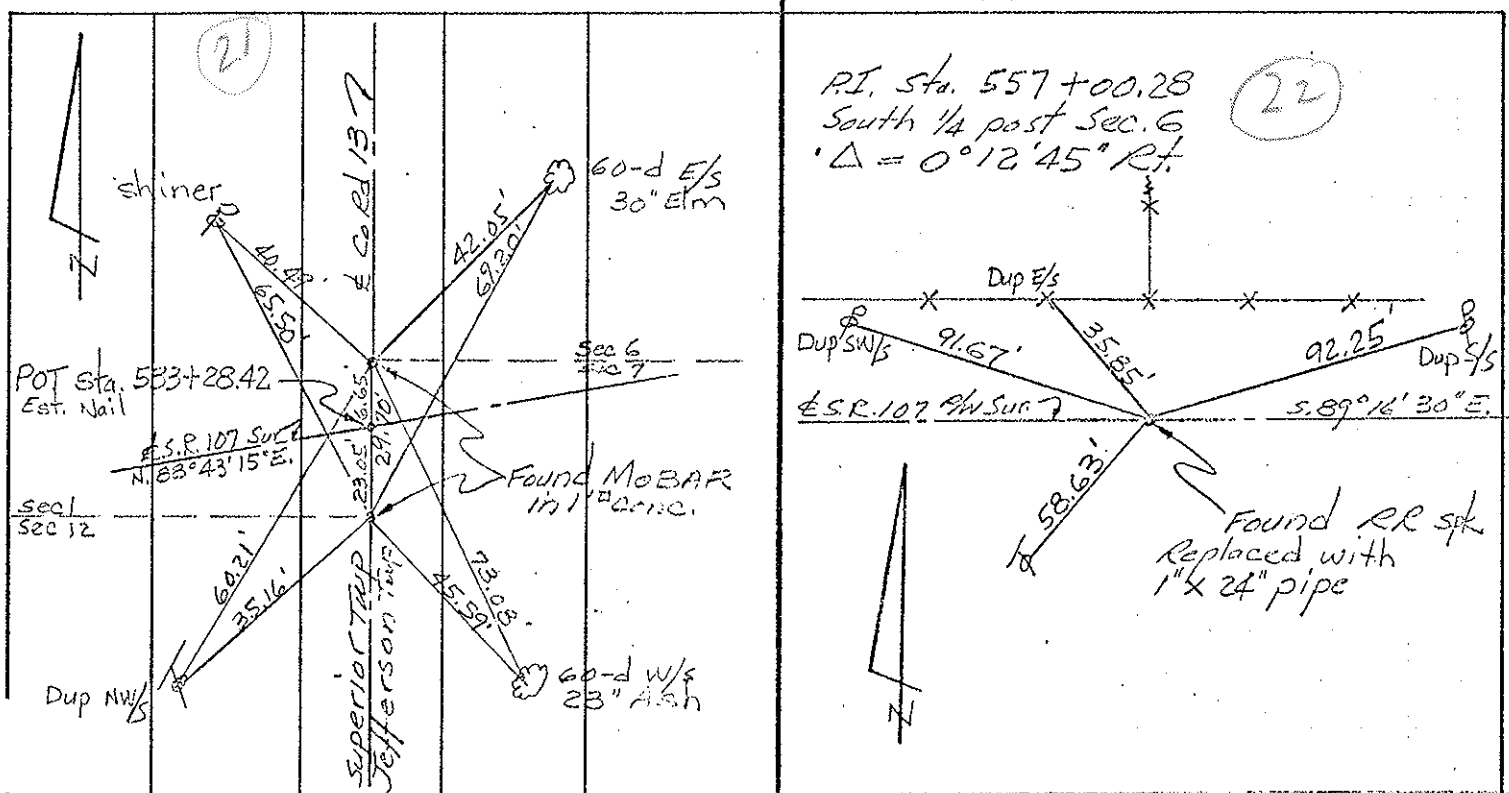

PERSONNEL TITLE PERSONNEL TITLE
Red Beach _____
Newcomb _____
Knape _____
Wise _____

COUNTY Williams DATE Feb. '69
 S. R. 107 WEATHER _____
 SEC. 8.95-11.05 TEMP. _____

DESCRIPTION ALIGNMENT JOB NO. 02734

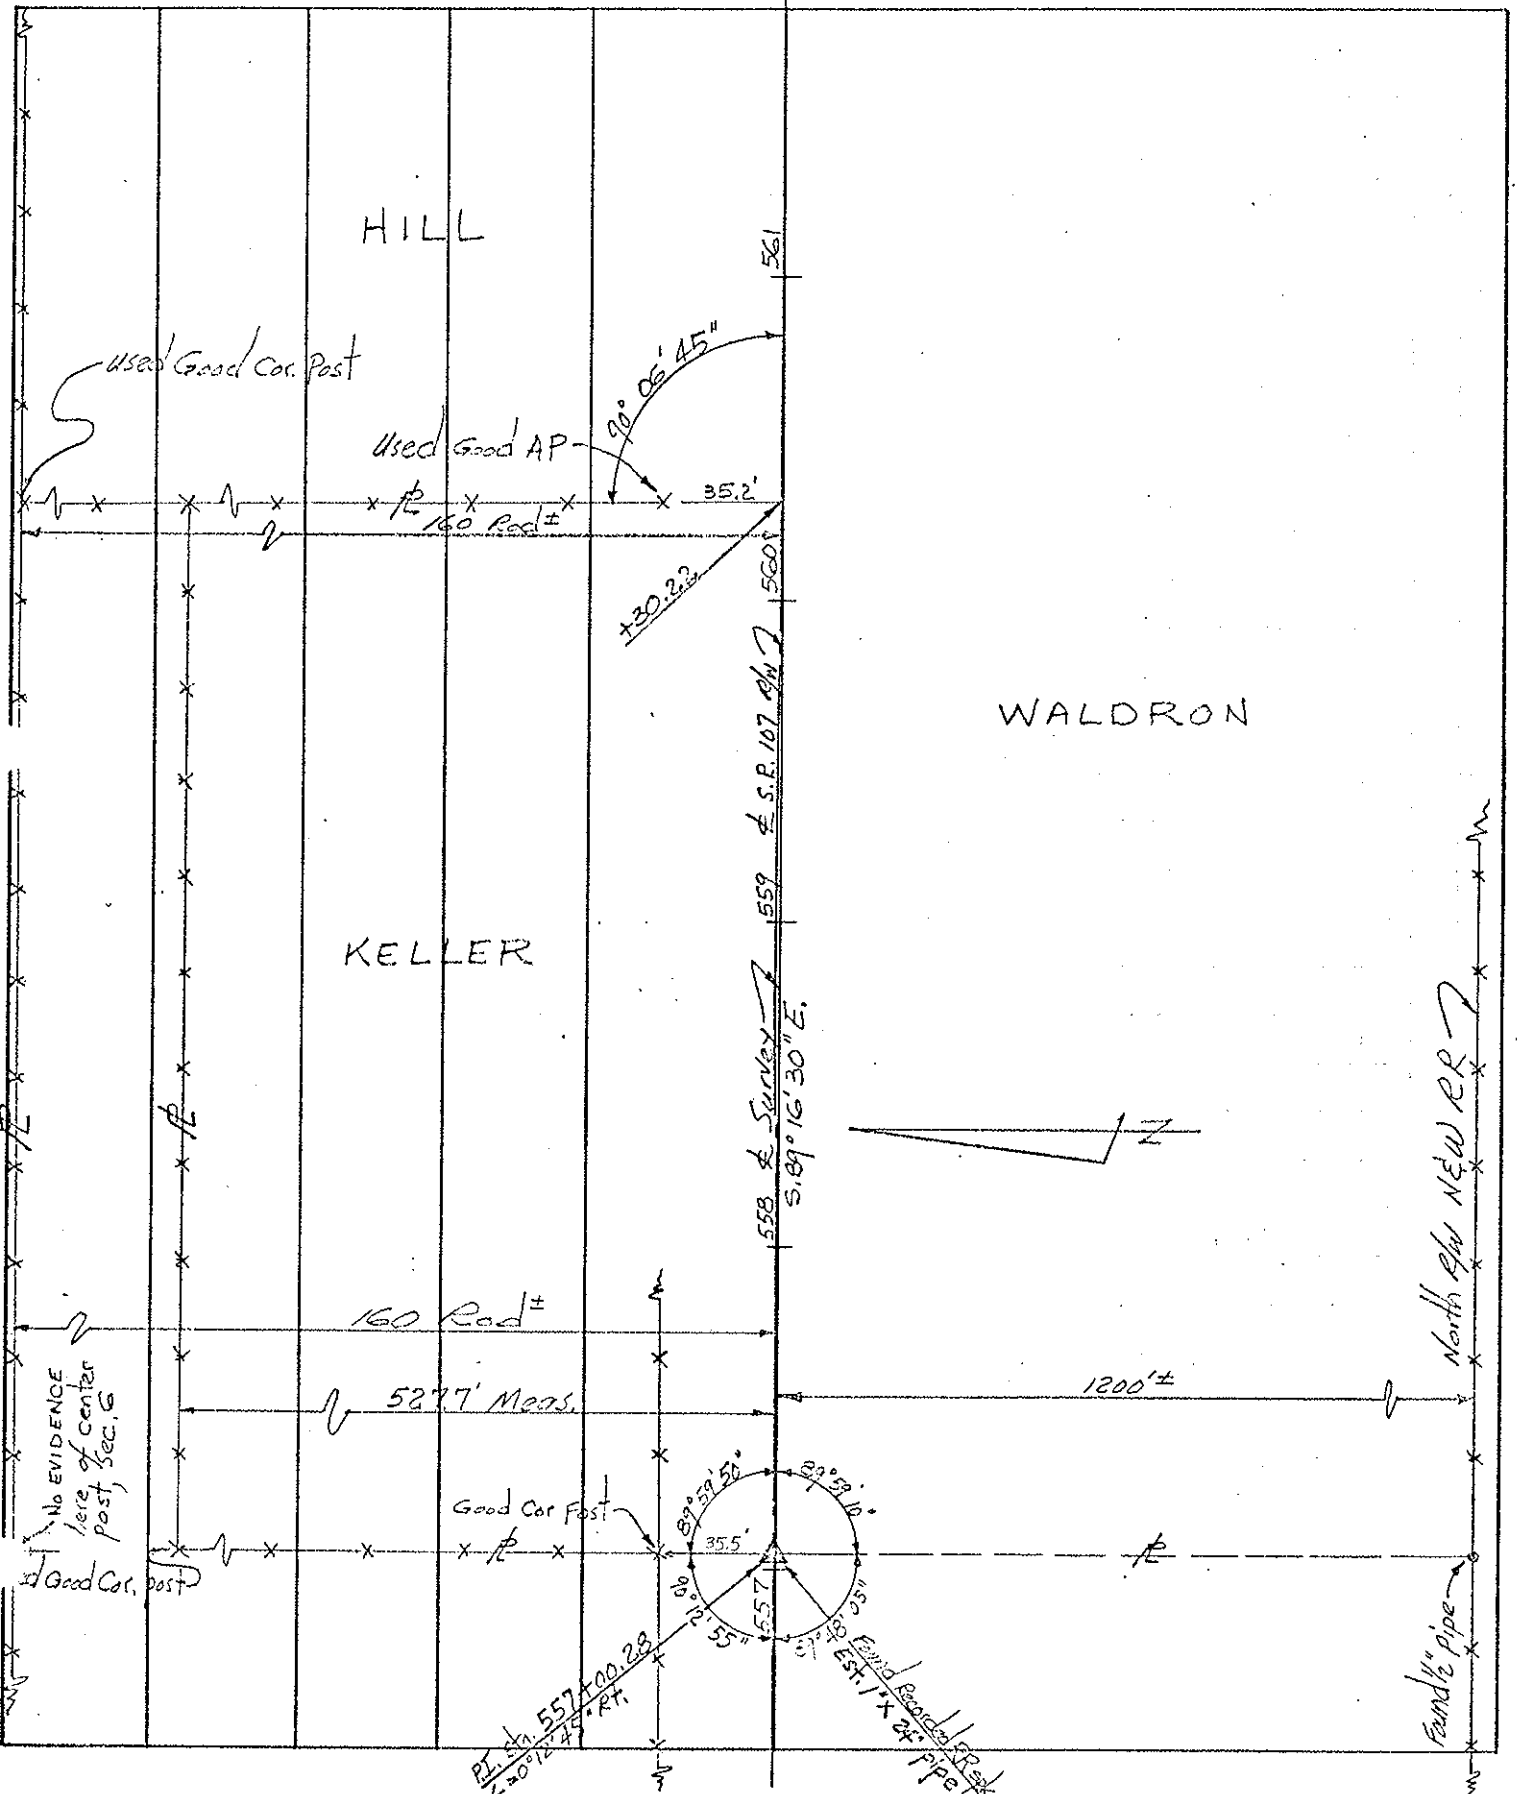

PERSONNEL TITLE PERSONNEL TITLE
 Red Beach _____ COUNTY Williams DATE Feb '69
 Newscomb _____ S. R. 107 WEATHER _____
 Knape _____ SEC. 875-11.05 TEMP. _____
 Wise _____

DESCRIPTION ALIGNMENT JOB NO. 02734

