


SHEET NO. 10
DATE 3-28-1980
WEATHER Rainy-Cloudy
TEMP. 44°

COUNTY Williams
S. R. 15 & US 127
SEC. _____

PERSONNEL _____ TITLE _____
PERSONNEL _____ TITLE _____
PERSONNEL _____ TITLE _____
PERSONNEL _____ TITLE _____

DESCRIPTION 1980 Black Top Program JOB NO. _____
LEFT CENTER LINE RIGHT

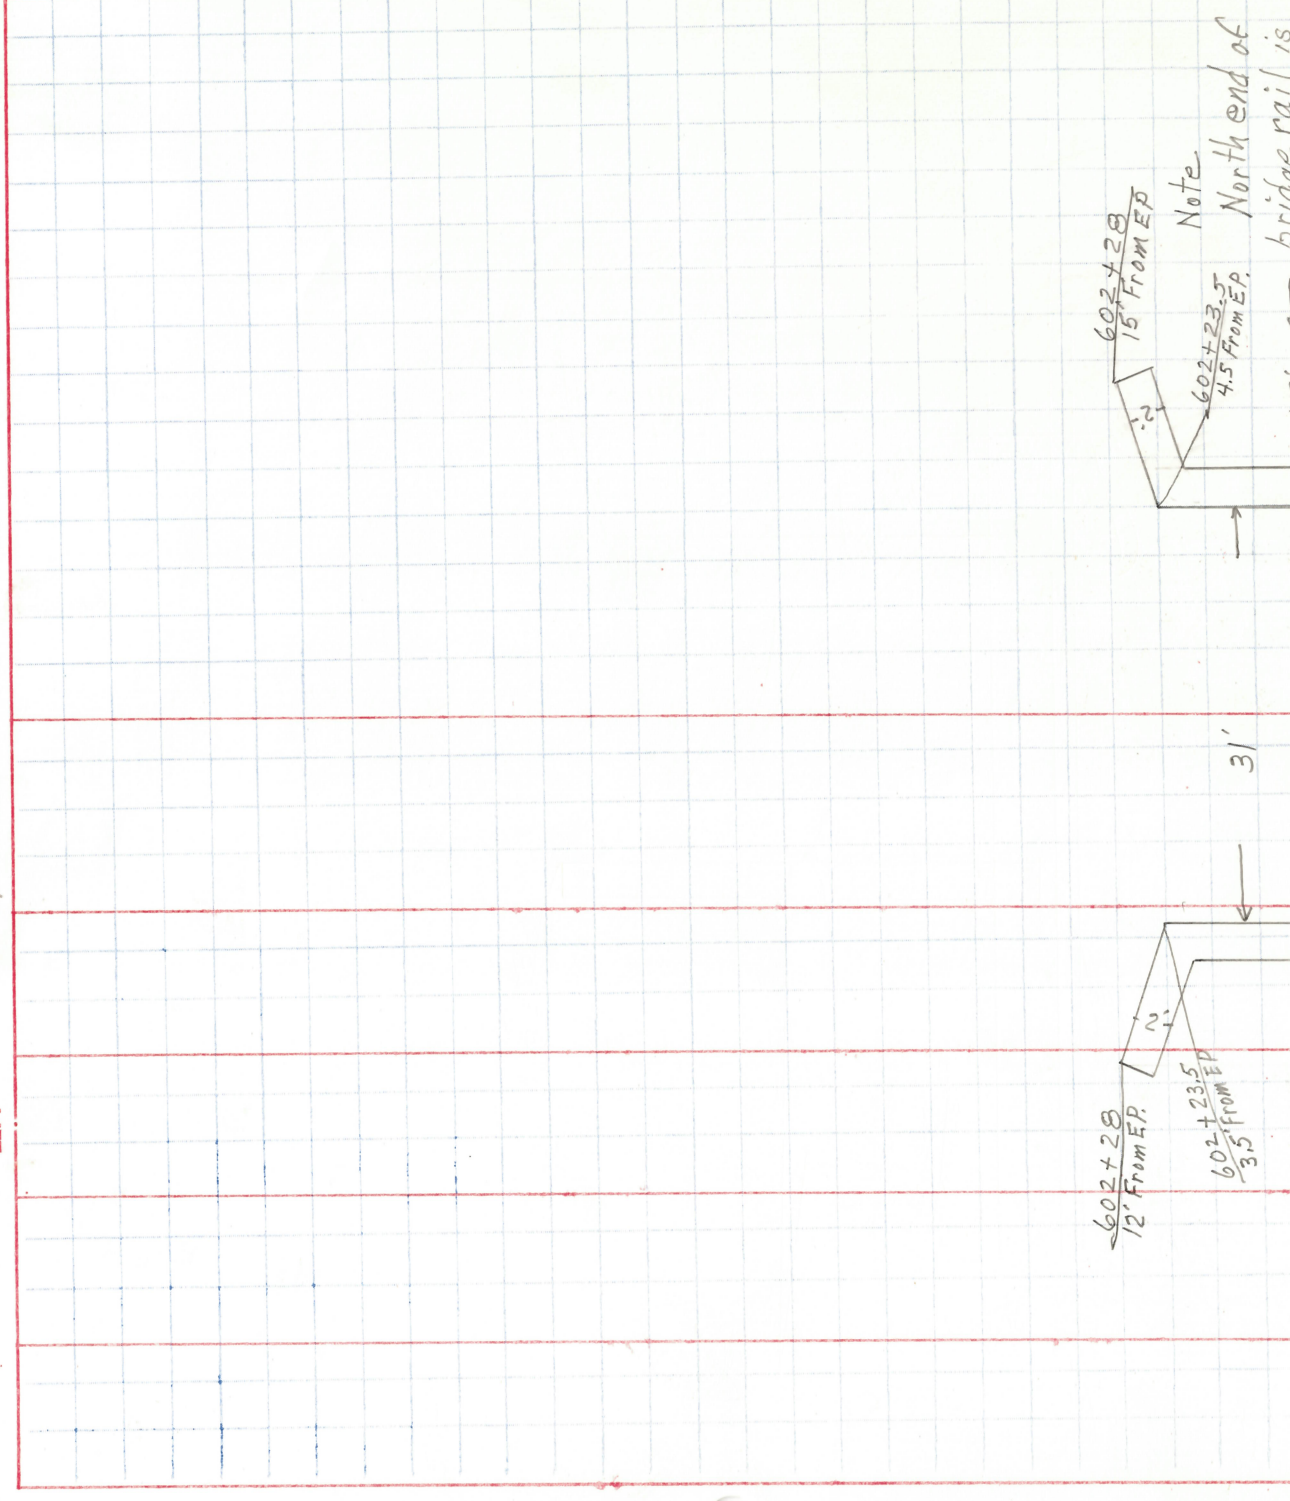

SHEET NO. 11
DATE 4-2-1980
WEATHER Rainy
TEMP. 44°

COUNTY Williams
S. R. 15 & US 127
SEC. _____

PERSONNEL TITLE PERSONNEL TITLE
Smith _____
Bowers _____
Mead _____

DESCRIPTION 1980 Black Top Program JOB NO. _____

