



PERSONNEL TITLE PERSONNEL TITLE  
 Smith \_\_\_\_\_  
 Mead \_\_\_\_\_

COUNTY Williams DATE 4-7-1980



S. R. 15 & US 127 WEATHER Cloudy-Rainy

SEC. \_\_\_\_\_ TEMP. 52°

DESCRIPTION 1980 Black Top Program LEFT CENTER LINE RIGHT JOB NO. \_\_\_\_\_

STATION	OUT Rt-Lt	CB	TYPE 1,2,3	MH	TYPE San. Storm	MONU	TYPE Box Other	WV	CASTING		Remarks
									Raise	Feather	
206+40	On $\Phi$					✓	Box		✓		
206+46	14.5 Rt							✓	✓		
206+52	38 Rt	Curb Inlet			Storm						
206+52	37 Lt	Curb Inlet			Storm						
206+57	34 Rt			✓					✓		
206+80	29 Lt			✓					✓		
206+87	40 Rt	Curb Inlet			Storm						
206+92	36.5 Lt	Curb Inlet			Storm						
206+93	26 Lt			✓					✓		Bell Telephone Top Broken
208+78	26 Rt	Curb Inlet			Storm						
208+80	26 Lt	Curb Inlet			Storm						
211+53	26 Rt	Curb Inlet			Storm						
211+53	26 Lt	Curb Inlet			Storm						
215+95.2	On $\Phi$					✓			✓		

PERSONNEL TITLE PERSONNEL TITLE COUNTY Williams DATE 4-8-1980  
Smith \_\_\_\_\_ \_\_\_\_\_ \_\_\_\_\_  
Mead \_\_\_\_\_ \_\_\_\_\_ \_\_\_\_\_  
 \_\_\_\_\_ \_\_\_\_\_ \_\_\_\_\_  
 \_\_\_\_\_ \_\_\_\_\_ \_\_\_\_\_  
 S. R. 15 & US 127 WEATHER Cloudy  
 \_\_\_\_\_ \_\_\_\_\_ \_\_\_\_\_  
 SEC. \_\_\_\_\_ TEMP. +60°  
 DESCRIPTION 1980 Black Top Program JOB NO. \_\_\_\_\_  
 LEFT CENTER LINE RIGHT

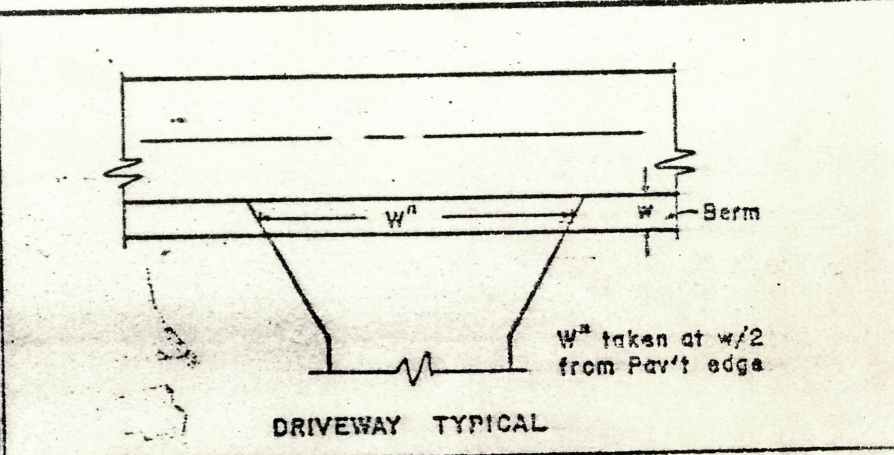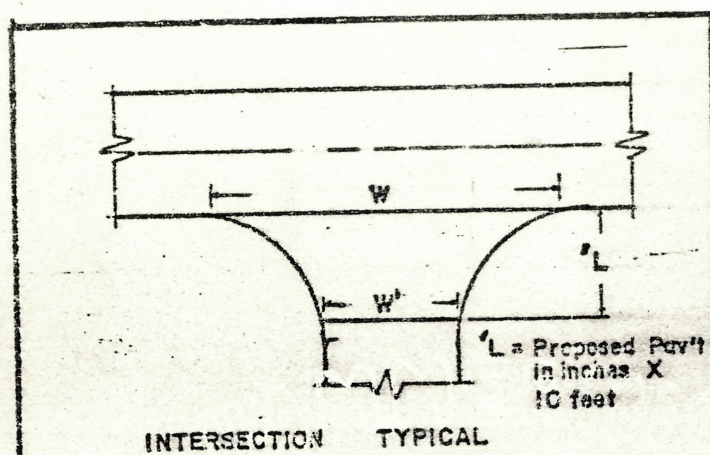

STATION	RT. LT.	L	W	W'	Asph	Conc	STATION	RT. LT.	w	W'	Asph	Conc	Aggr	Dropped Curb Feather NOT Reqt
206+70	RT	15'	74'	31'	✓		207+37	LT		28'	✓			✓
206+70	LT	15'	76'	30'	✓		207+90	LT		16'			✓	✓
							208+00	RT		35'	✓			✓
							208+50	RT		35'	✓			✓
							208+50	LT		32'	✓			✓
							209+07	LT		28'	✓			✓
							210+00	LT		20'			✓	
							210+35	LT		45'		✓		
							211+24	LT		46'			✓	
							211+80	RT		40'	✓			
							211+93	LT		35'	✓			
							212+90	LT		35'	✓			
							213+10	RT		50'	✓			
							213+36	LT		46'		✓		
							214+44	LT		40'		✓		

PERSONNEL TITLE PERSONNEL TITLE  
 Smith \_\_\_\_\_  
 Mead \_\_\_\_\_

COUNTY Williams DATE 4-8-1980  
 S. R. 15 & US127 WEATHER Cloudy  
 SEC. \_\_\_\_\_ TEMP. +60°

DESCRIPTION 1980 Black Top Program JOB NO. \_\_\_\_\_

