


O.D.O.T. DISTRICT 2 SURVEY OFFICE (USE ONLY)


PERSONNEL _____ REFERENCE NO. 2 SHEET 2 OF 9
 NOTES ROUSOS DATE 8/2/11 ROUTE SR 15
 H.C. HARBUAGH WEATHER CLOUDY COUNTY WILLIAMS
 R.C. HOMAN TEMP. 82° F TOWNSHIP PULASKI
 SECTION 32
 T 6 N R 3 E

TYPE MONUMENT 1/2" IPIPE
~~ON SURFACE~~ - BELOW 4"
 LEFT - ☉ PAV'T - ~~RIGHT~~ 0.45
- TO - EDGE PAVEMENT
 S.L.M. 0+00

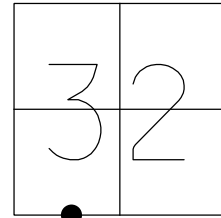

GRID: NORTHING: 647949.490 EASTING: 1406261.070


RECORD: 2/28/79
 FD IPIPE
 1 1/4" DOWN
 0.45 WEST OF LINE OF
 MON BOXES AT PLAN STA.
 13+00 & 27+71.8
 FD 1/2" IPIPE
 4" DOWN
 6/4/92, MB

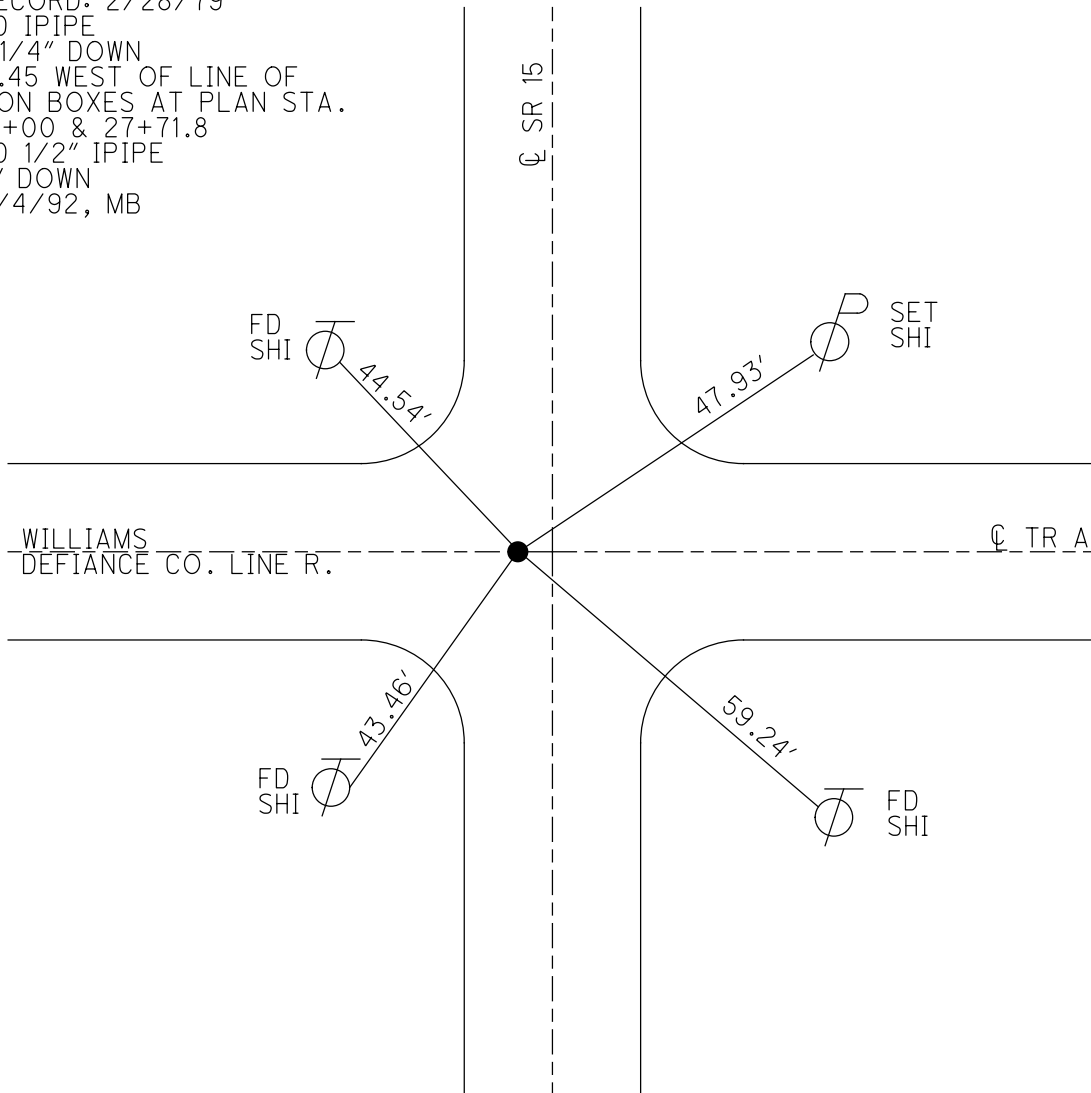

O.D.O.T. DISTRICT 2 SURVEY OFFICE (USE ONLY)

PERSONNEL _____ REFERENCE NO. 2 SHEET 2 OF 9
 NOTES ROUSOS DATE 8/2/11 ROUTE SR 15
 H.C. HARBUAGH WEATHER CLOUDY COUNTY WILLIAMS
 R.C. HOMAN TEMP. 82° F TOWNSHIP PULASKI
 SECTION 32
 T 6 N R 3 E

TYPE MONUMENT 1/2" IPIPE
~~ON SURFACE~~ - BELOW 4"
 LEFT - ℄ PAV'T - ~~RIGHT~~ 0.45
- TO - EDGE PAVEMENT
 S.L.M. 0+00

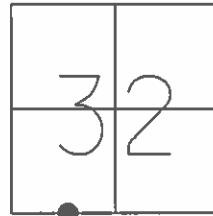

GRID: NORTHING: 647949.490 EASTING: 1406261.070

RECORD: 2/28/79
 FD. IPIPE 1 1/4" BELOW SURFACE
 AND 0.45 WEST OF LINE OF
 MON BOXES AT PLAN STA.
 13+00 & 27+71.8

FD 1/2" IPIPE
 4" BELOW SURFACE
 6/4/92, MB

