

O.D.O.T. DISTRICT 2 SURVEY OFFICE (USE ONLY)

PERSONNEL

REFERENCE NO. 8 A

SHEET 10 OF 19

NOTES BARNHEISEL DATE 6/5/92
 H.C. VAN DUSEN WEATHER CLOUDY
 R.C. BURNETT TEMP. 65°

ROUTE US 127
 COUNTY WILLIAMS
 TOWNSHIP PULASKI
 SECTION 20

DWG BY NIESE PID _____

T 6 N R 3 E

TYPE MONUMENT P.K. NAIL

ON SURFACE - ~~BELOW~~ ON _____


OFFSET \varnothing PAVEMENT 4.7' LT : ~~RT~~

- TO - EDGE PAVEMENT

STATION: 134+27


HORZ. DATUM: _____ GEOID: _____

GRID: NORTHING: _____ EASTING: _____

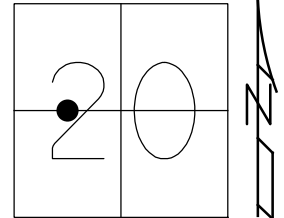

RECORD:
 FD P.K. NAIL
 ORIGIN UNKNOWN
 6/5/92, MB
 SET P.K./WASHER
 9/25/92, MB

NOTE:
 4.3' N. OF \varnothing WEST

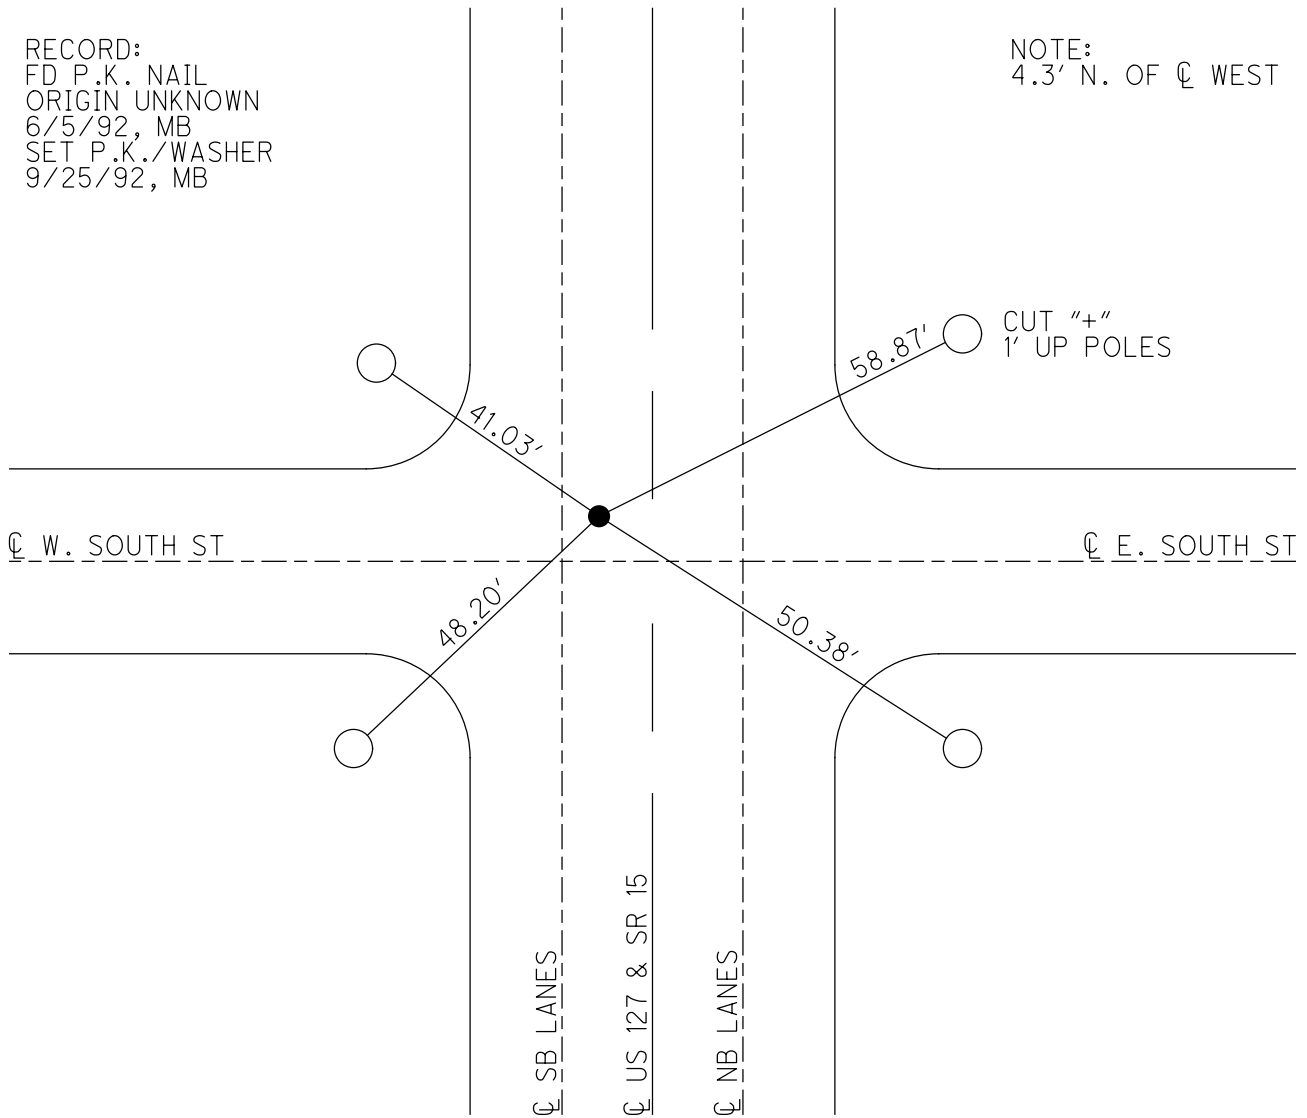

O.D.O.T. DISTRICT 2 SURVEY OFFICE

PERSONNEL

REFERENCE NO. 8A

SHEET 10 OF 23

NOTES BARNHISEL

H.C. VAN DUSEN

R.C. BURNETT

DATE 6-5-92

WEATHER cloudy

TEMP. +65

ROUTE U.S. 127

COUNTY Williams

TOWNSHIP PULASKI

SECTION 20

T 6 N R 3 E

TYPE MONUMENT P.K. NAIL


ORIGIN UNKNOWN

ON SURFACE - BELOW YES

LEFT - & PAV'T. - RIGHT 4.7

— TO — EDGE PAVEMENT

S.L.M. 134+27 4.3 N. OF & WEST

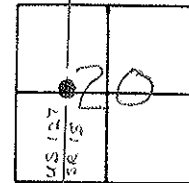

Set PK + WASHER
9-25-92
MB

