

O.D.O.T. DISTRICT 2 SURVEY OFFICE (USE ONLY)

PERSONNEL _____

REFERENCE NO. 8 B

SHEET 11 OF 19

NOTES BARNHISEL

DATE 6/5/92

ROUTE US 127

H.C. VAN DUSEN

WEATHER CLOUDY

COUNTY WILLIAMS

R.C. BURNETT

TEMP. 65°

TOWNSHIP PULASKI

DWG BY NIESE

PID _____

SECTION 20

T 6 N R 3 E

TYPE MONUMENT P.K. NAIL

ON SURFACE - ~~BELOW~~ ON

OFFSET ☐ PAVEMENT ON LT : RT

- TO - EDGE PAVEMENT


STATION: 147+26

HORZ. DATUM: _____

GEOID: _____


GRID: NORTHING: _____

EASTING: _____

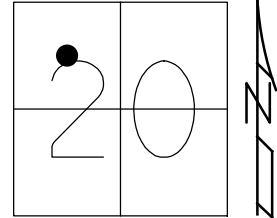

RECORD:
FD P.K. NAIL
ORIGIN UNKNOWN
6/5/92, MB
SET P.K./WASHER
9/25/92, MB

NOTE:
3.5' N OF ☐ WEST
18.0' N OF ☐ EAST

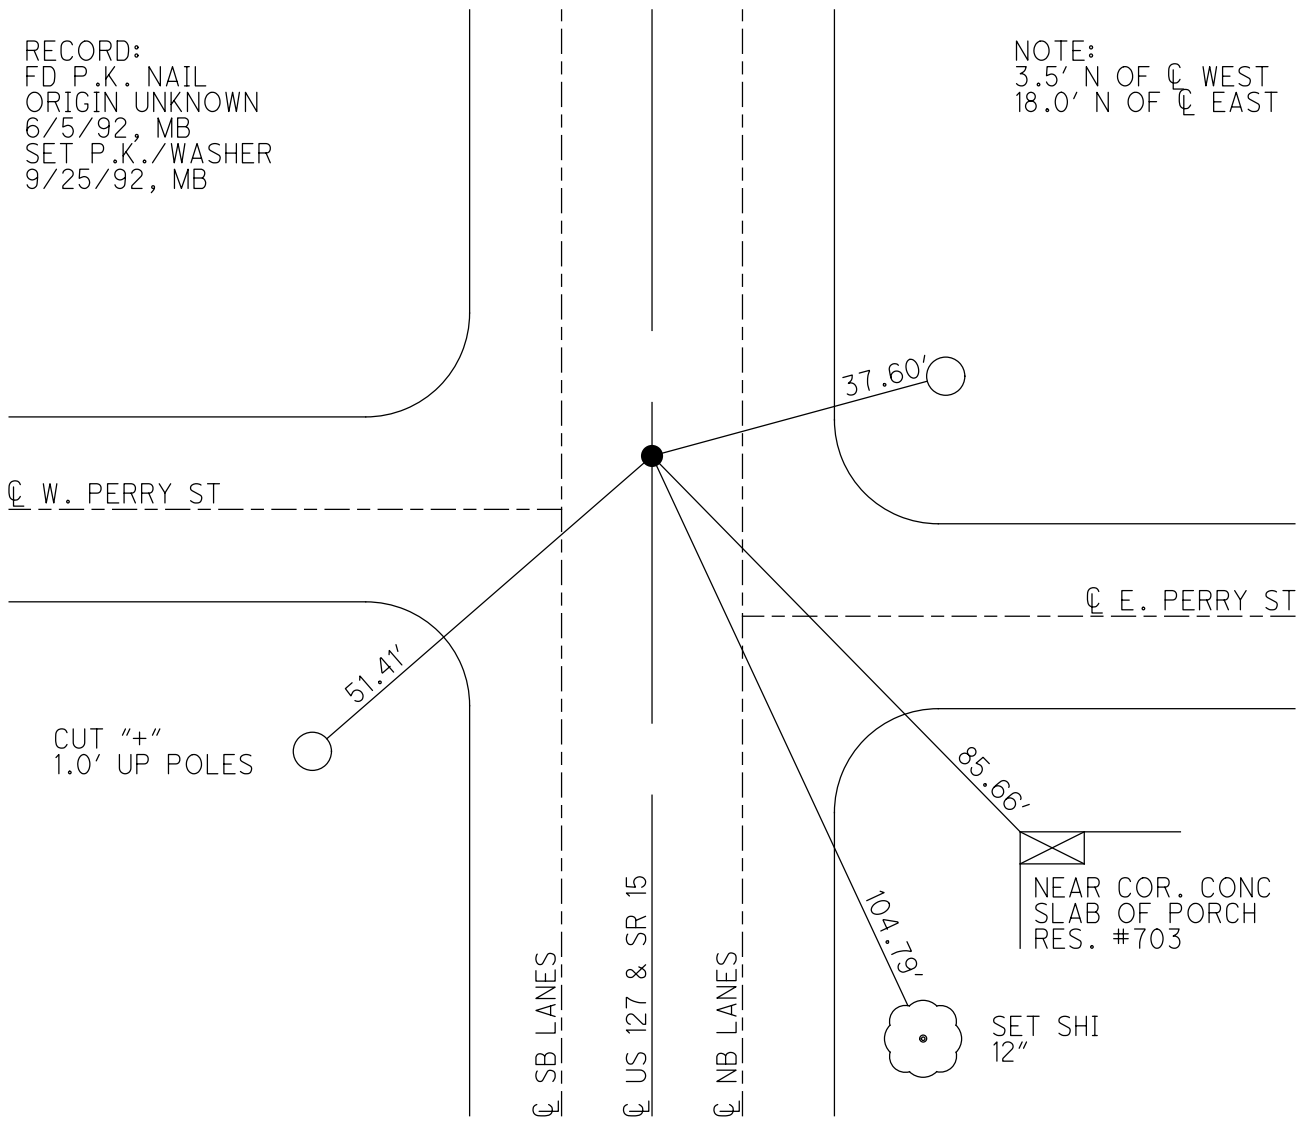

O.D.O.T. DISTRICT 2 SURVEY OFFICE

PERSONNEL

REFERENCE NO. 86

SHEET 11 OF 23

NOTES BARNHISEL

H.C. VAN DUSEN

R.C. BURNETT

DATE 6-5-92

WEATHER cloudy

TEMP. +65°

ROUTE U.S. 127

COUNTY Williams

TOWNSHIP Pulaski

SECTION 20

T. 6 N. R. 3 E.

TYPE MONUMENT P.K. NAIL

ORIGIN UNKNOWN

ON SURFACE - BELOW yes

~~LEFT~~ - ~~PAV'T.~~ - ~~RIGHT~~ yes

TO EDGE PAVEMENT

S.L.M. 147+26

3.5 N. OF & WEST
18.0 N OF & EAST

