

O.D.O.T. DISTRICT 2 SURVEY OFFICE (USE ONLY)

PERSONNEL

REFERENCE NO. 8 D

SHEET 13 OF 19

NOTES BARNHEISEL

DATE 6/5/92

ROUTE US 127

H.C. VAN DUSEN

WEATHER CLOUDY

COUNTY WILLIAMS

R.C. BURNETT

TEMP. 70°

TOWNSHIP PULASKI

SECTION 20

DWG BY NIESE PID _____

T 6 N R 3 E

TYPE MONUMENT P.K. NAIL

ON SURFACE - ~~BELOW~~ ON

OFFSET CL PAVEMENT 1.0' LT : ~~RT~~

- TO - EDGE PAVEMENT


STATION: 156+37

HORZ. DATUM: _____


GEOID: _____

GRID: NORTHING: _____

EASTING: _____

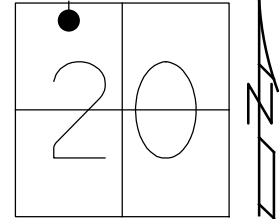

RECORD:
FD P.K. NAIL
ORIGIN UNKNOWN
6/5/92, MB
SET P.K./WASHER
9/25/92, MB

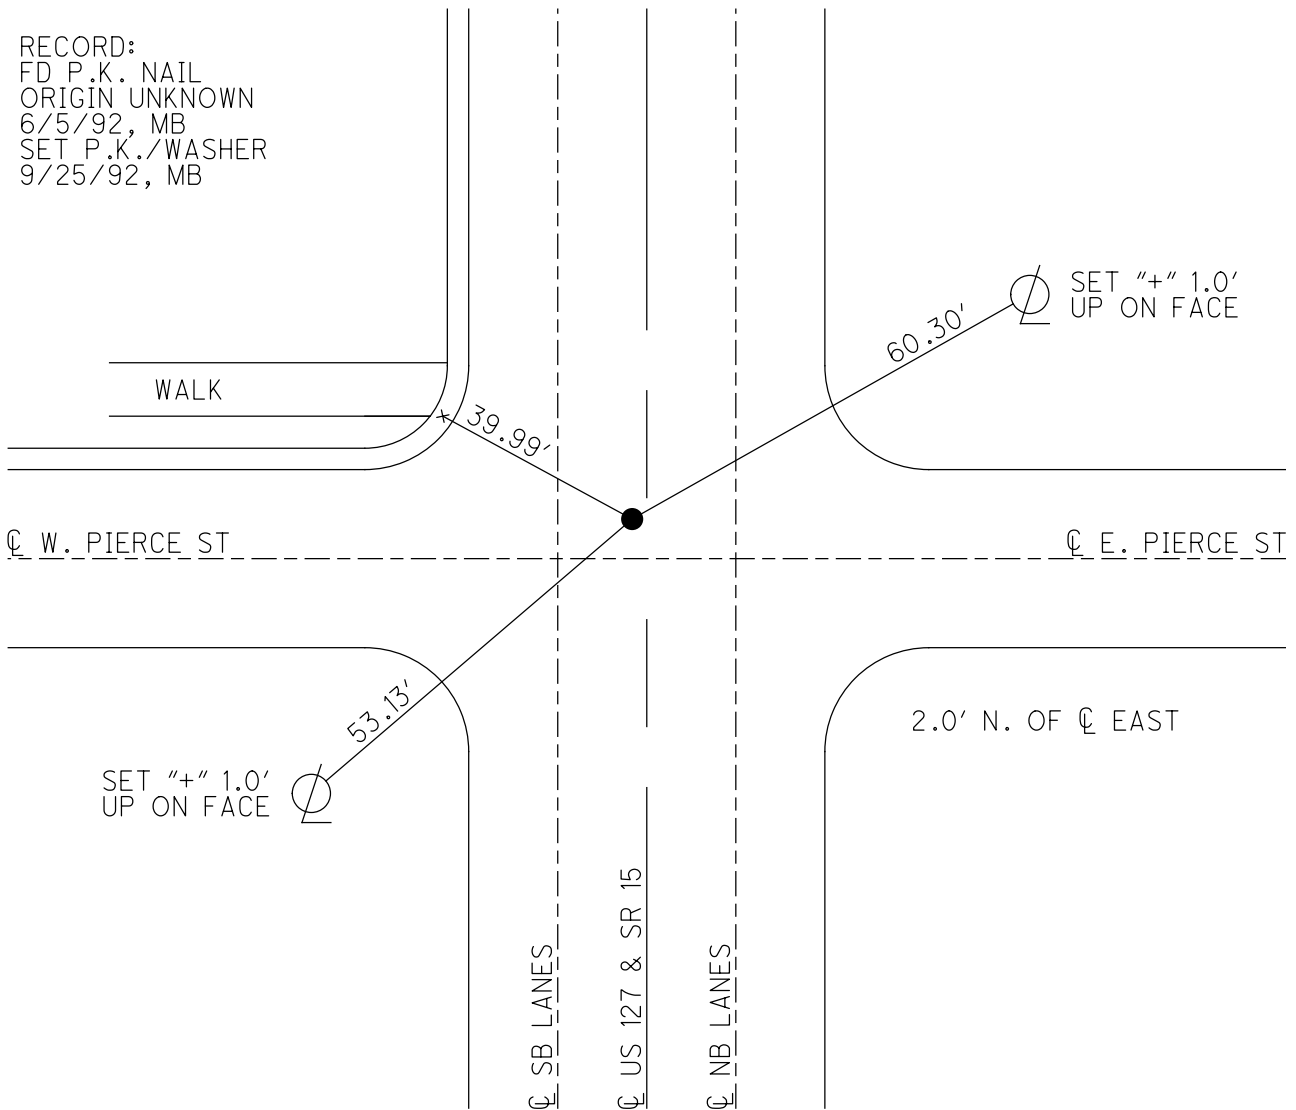

O.D.O.T. DISTRICT 2 SURVEY OFFICE

PERSONNEL

REFERENCE NO. 8 D

SHEET 13 OF 23

NOTES BARNHISEL

H.C. VAN DUSEN

R.C. BURNETT

DATE 6-5-92

WEATHER cloudy

TEMP. +70°

ROUTE U.S. 127

COUNTY Williams

TOWNSHIP Pulaski

SECTION 20

T 6 N R 3 E

TYPE MONUMENT P.K. NAIL

ORIGIN UNKNOWN



ON SURFACE - BELOW yes

LEFT - ℄ PAV'T. - RIGHT 1.0

- TO - EDGE PAVEMENT

S.L.M. 156 + 37

2.0 N. OF ℄ EAST

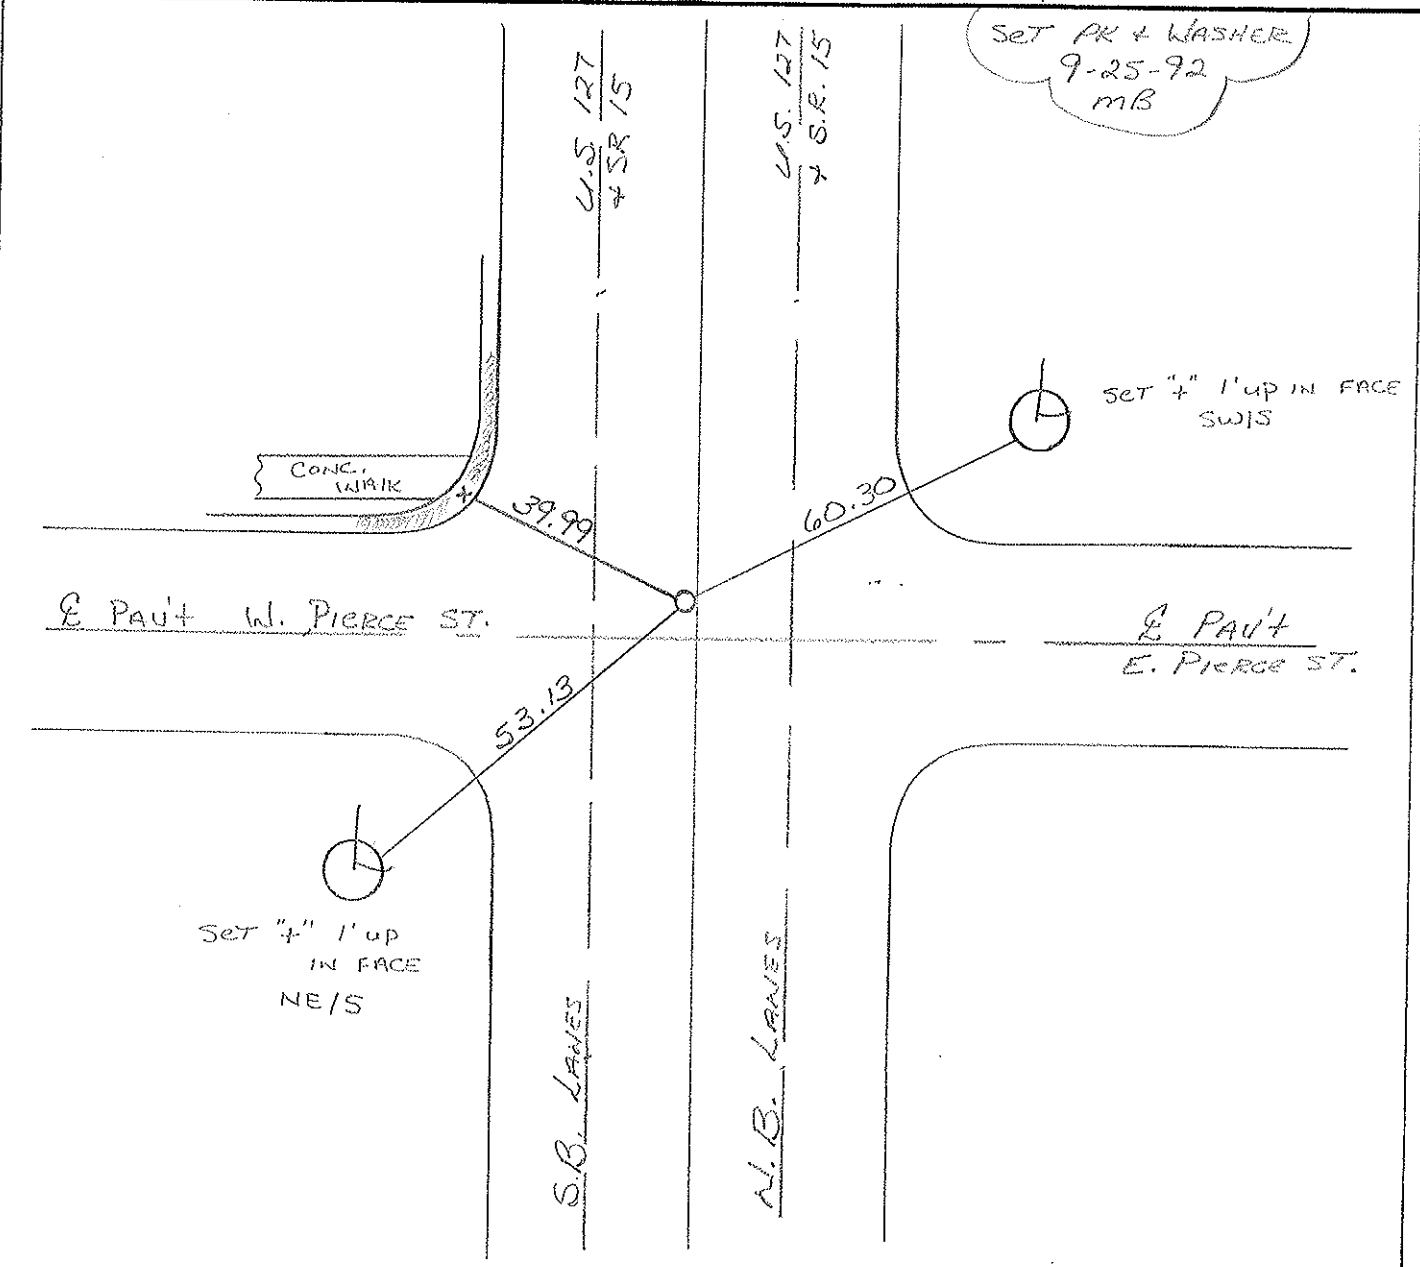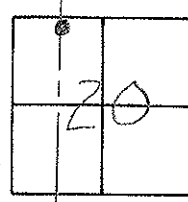

Set PK + WASHER
9-25-92
MB

SET "4" 1' up IN FACE SWIS

SET "4" 1' up IN FACE NE/S