

O.D.O.T. DISTRICT 2 SURVEY OFFICE (USE ONLY)

PERSONNEL

REFERENCE NO. 12

SHEET 4 OF 9

NOTES VAN DUSEN

DATE 04/10/92

ROUTE US 127

H.C. BARNHISEL

WEATHER RAIN

COUNTY WILLIAMS

R.C. CURTIS

TEMP. 45°

TOWNSHIP PULASKI

ROMETO

SECTION 8

DWG BY NASON PID 102821

T 6 N R 3 E

TYPE MONUMENT MONBOX W/ 3/4" IPIN

ON SURFACE - ~~BELOW~~ ON

OFFSET Q PAVEMENT ON LT : RT

25.4 TO LT. EDGE PAVEMENT


STATION: 216+15.36

HORZ.DATUM: NAUD88


GEOID: 2012A

GRID: NORTHING: 669376.461

EASTING: 1406580.140

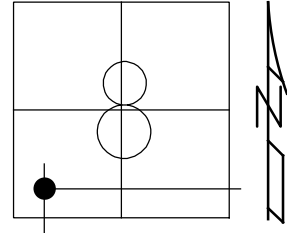

RECORD:
 FD MONBOX
 W/3/4"IPIN
 4/10/92, MB
 FD MONBOX
 W/3/4"IPIN
 REFB9
 9/24/13, SDC
 REF12
 6/5/17, JFO

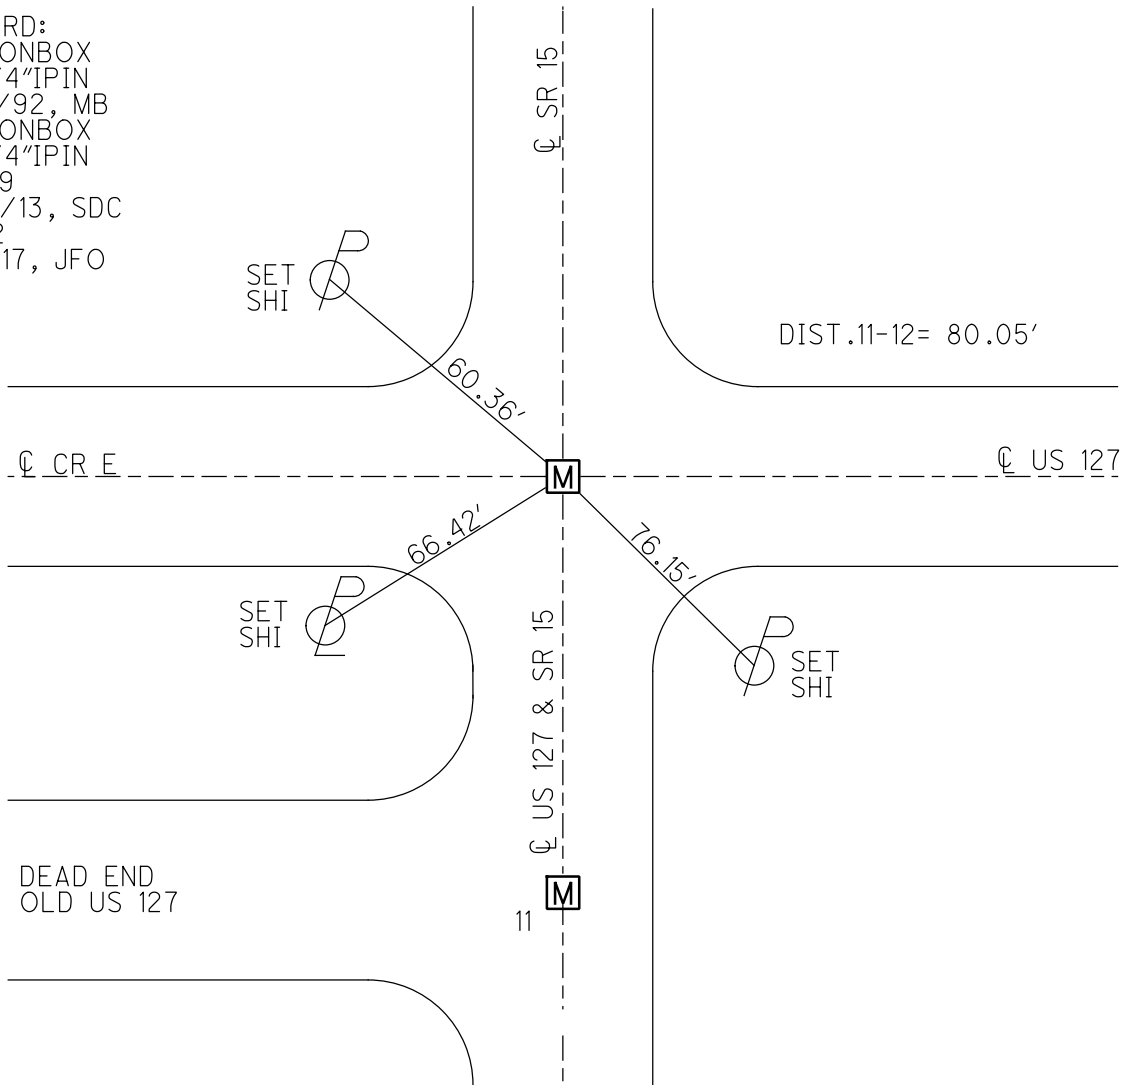

O.D.O.T. DISTRICT 2 SURVEY OFFICE (USE ONLY)

PERSONNEL	REFERENCE NO.	<u>12</u>	SHEET	<u>4</u>	OF	<u>4</u>
NOTES	<u>VAN DUSEN</u>	DATE	<u>4/10/92</u>	ROUTE	<u>US 127 & SR 15</u>	
H.C.	<u>BARNHISEL</u>	WEATHER	<u>RAIN</u>	COUNTY	<u>WILLIAMS</u>	
R.C.	<u>CURTIS</u>	TEMP.	<u>45°</u>	TOWNSHIP	<u>PULASKI</u>	
	<u>ROMETO</u>			SECTION	<u>8</u>	
				T	<u>6</u>	N
				R	<u>3</u>	E

TYPE MONUMENT MON BOX/IRON PIN


ON SURFACE - ~~BELOW~~ ON

~~LEFT~~ - CL PAV'T - ~~RIGHT~~ ON

25.4 TO LT EDGE PAVEMENT


S.L.M. 215+33

Grid: Northing: 669376.492 Easting: 1406580.076

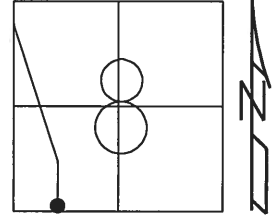

FD MON BOX W/IPIN
4/10/92, MB
FD MONBOX W/IPIN
REFB9
9/24/13, SDC
DID NOT COVER

DIST.
10C-11= 1262.02'
11-12= 80.05'

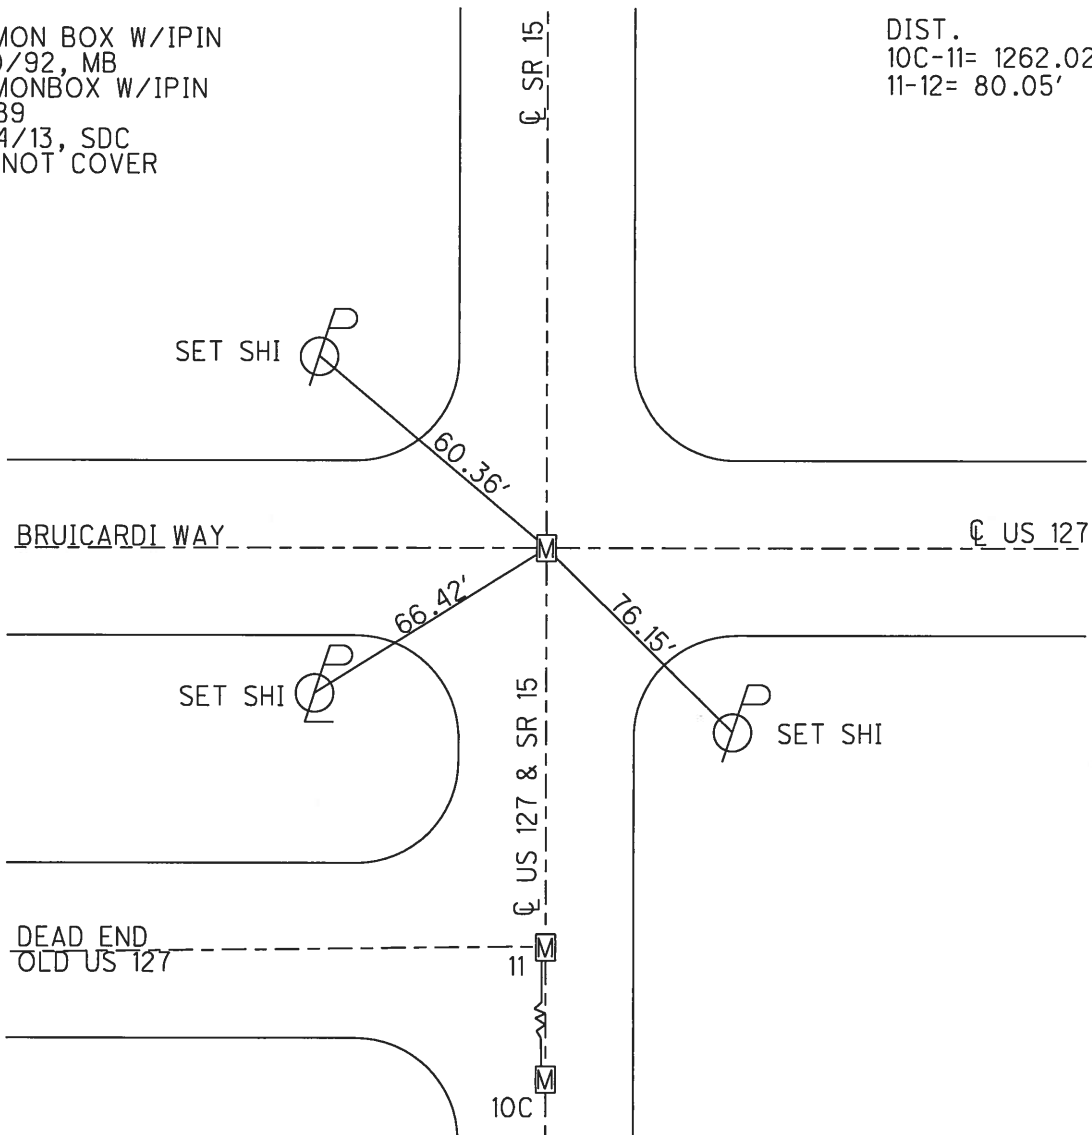

O.D.O.T. DISTRICT 2 SURVEY OFFICE

PERSONNEL

REFERENCE NO. 12

SHEET 23 OF 23

NOTES VAN DUSEN

H.C. BARNHISEL

R.C. CURTIS

ROMETO P

DATE 4-10-02

WEATHER CLOUDY RAIN

TEMP. +45° F

ROUTE US 127 & SR 15

COUNTY WILLIAMS

TOWNSHIP PULASKI

SECTION 8-9

T 6 N R 3 E



TYPE MONUMENT MON. BOX W/ IRON PIN

ON SURFACE - BELOW YES

LEFT - & PAV'T. - RIGHT YES

25.4 TO LT. EDGE PAVEMENT

S.L.M. 215 + 33

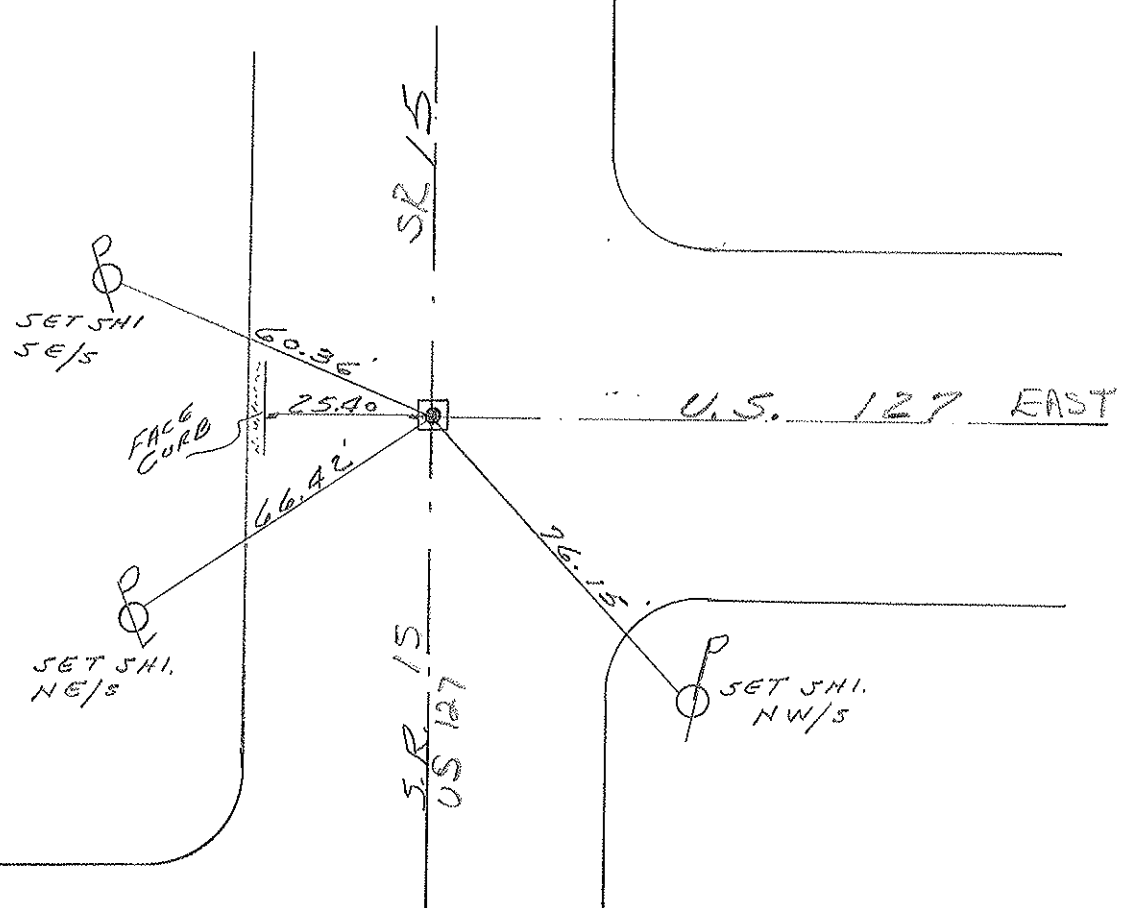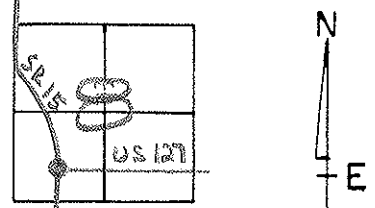

Co. Rd "E"