
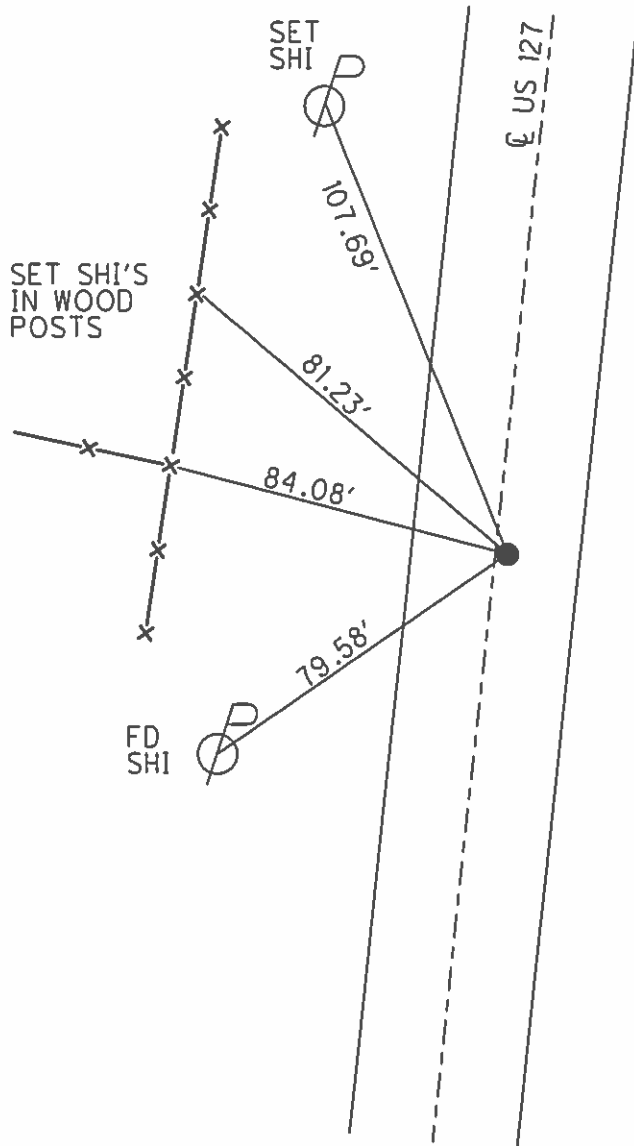


O.D.O.T. DISTRICT 2 SURVEY OFFICE (USE ONLY)

PERSONNEL _____ REFERENCE NO. 16 B SHEET 6 OF 56

NOTES CANTERBURY DATE 5/31/02 ROUTE US 127
 H.C. BARNHISEL WEATHER SUNNY COUNTY WILLIAMS
 R.C. MALINSKY TEMP. 78° TOWNSHIP PULASKI
CHLEBECK SECTION 10
T 6 N R 3 E

TYPE MONUMENT P.K.NAIL
 ON SURFACE - ~~BELOW~~ ON _____
 LEFT - ☉ PAV'T - RIGHT ON _____
12.4' TO RT EDGE PAVEMENT
 S.L.M. 329+87
 Grid: Northing: 672893.655 Easting: 1417612.682

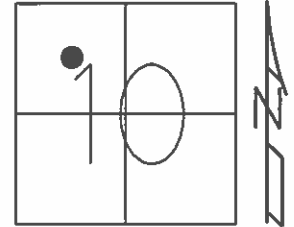

RECORD: T.S.
 STA. 329+00
 (OLD PLAN)
 SET MAG/WASHER
 8/21/03, MDB
 FD MAG/WASHER
 6/13/11
 SET MAG/WASHER
 GPS, FB16
 2/7/12, SAH