
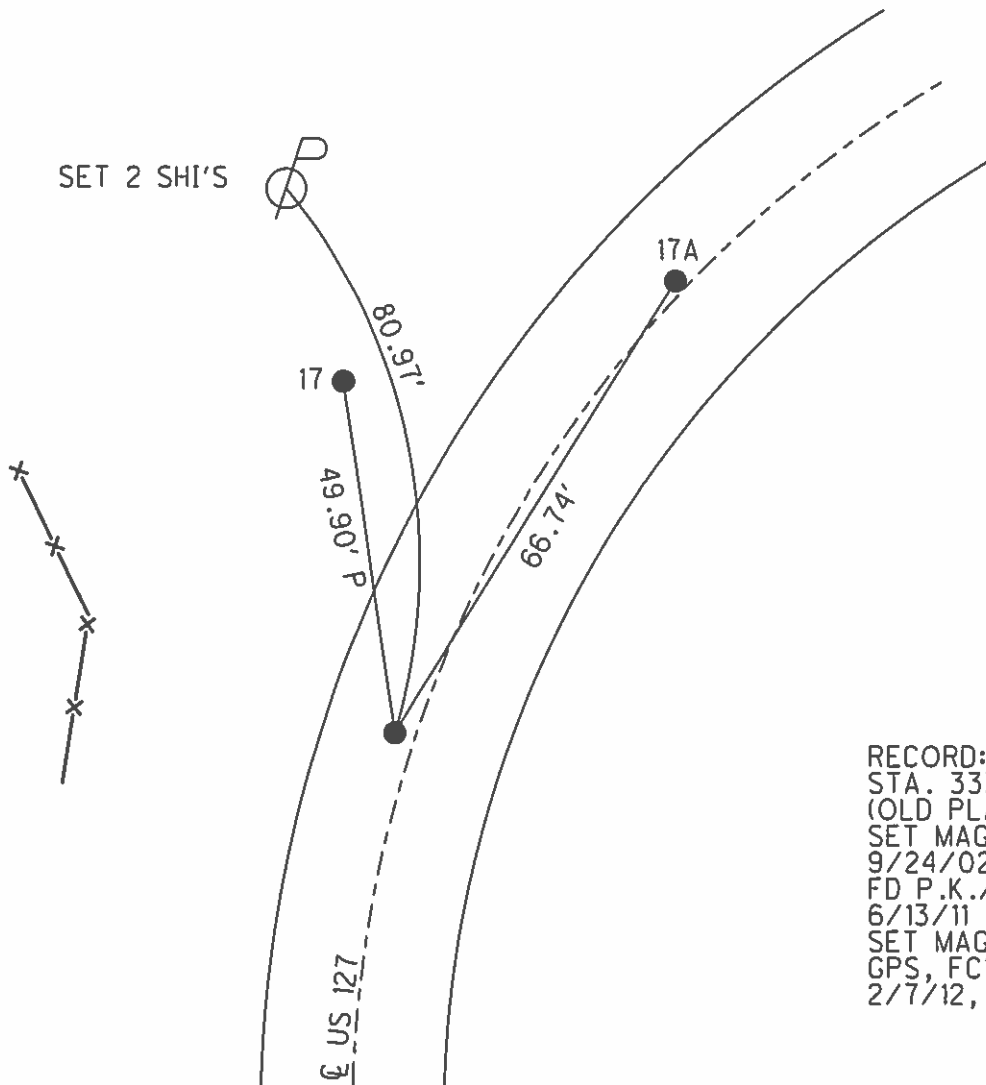


O.D.O.T. DISTRICT 2 SURVEY OFFICE (USE ONLY)

PERSONNEL \_\_\_\_\_ REFERENCE NO. 16 C SHEET 7 OF 56  
 NOTES CANTERBURY DATE 5/13/02 ROUTE US 127  
 H.C. BARNHISEL WEATHER SUNNY COUNTY WILLIAMS  
 R.C. MALINSKY TEMP. 78° TOWNSHIP PULASKI  
 \_\_\_\_\_ SECTION 10  
 \_\_\_\_\_ T 6 N R 3 E

TYPE MONUMENT P.K.NAIL  
 ON SURFACE - ~~BELOW~~ ON  
 LEFT - ☉ PAV'T - ~~RIGHT~~ 0.5'  
12.5' TO LT EDGE PAVEMENT  
 S.L.M. 333+87  
 Grid: Northing: 673280.648 Easting: 1417709.444

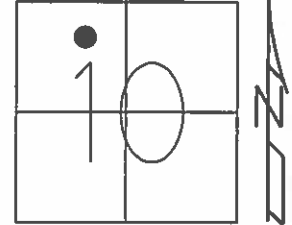

RECORD: S.C.  
 STA. 333+00  
 (OLD PLAN)  
 SET MAG/WASHER  
 9/24/02, MRC  
 FD P.K./WASHER  
 6/13/11  
 SET MAG/WASHER  
 GPS, FC16  
 2/7/12, SAH