
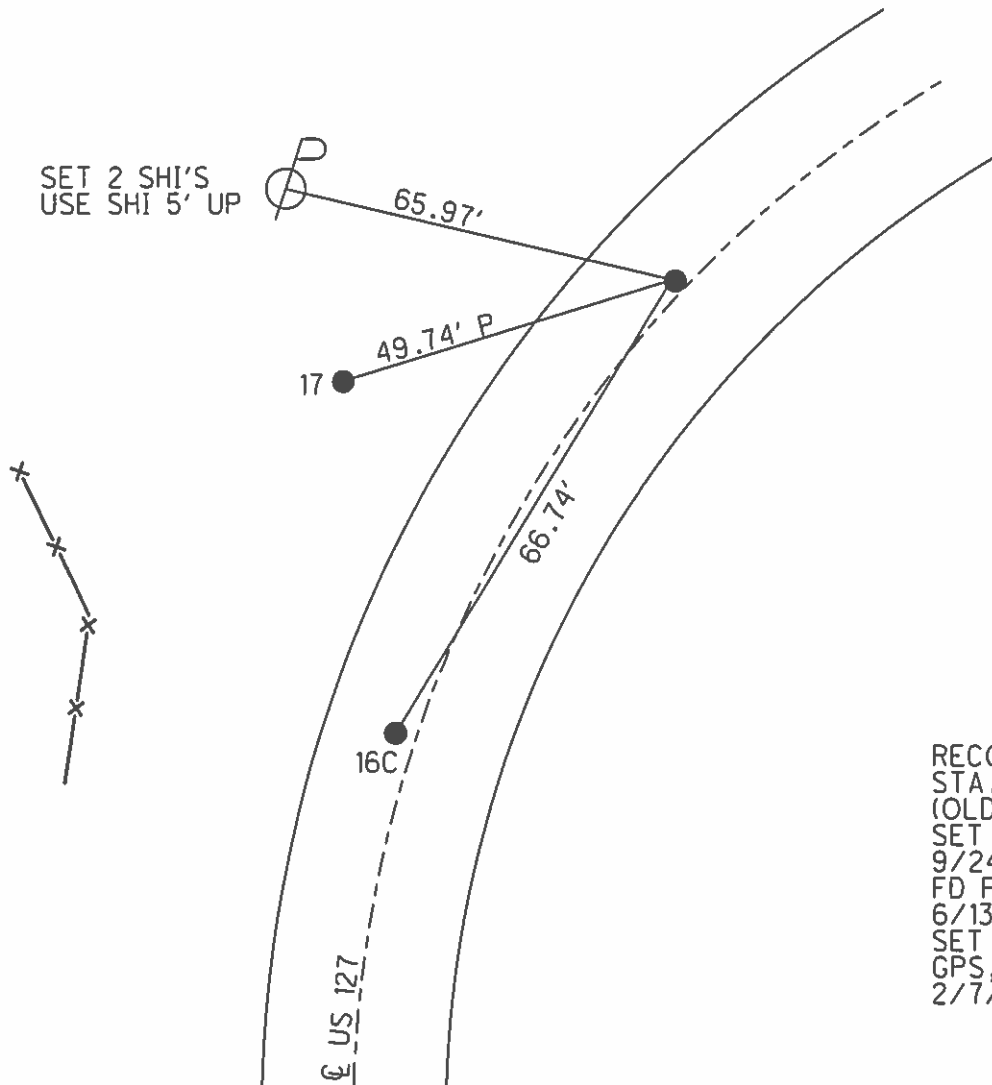


O.D.O.T. DISTRICT 2 SURVEY OFFICE (USE ONLY)

PERSONNEL	REFERENCE NO.	<u>17 A</u>	SHEET	<u>9</u>	OF	<u>56</u>
NOTES	<u>CANTERBURY</u>	DATE	<u>5/31/02</u>	ROUTE	<u>US 127</u>	
H.C.	<u>BARNHISEL</u>	WEATHER	<u>SUNNY</u>	COUNTY	<u>WILLIAMS</u>	
R.C.	<u>MALINSKY</u>	TEMP.	<u>78°</u>	TOWNSHIP	<u>PULASKI</u>	
	<u>CHLEBECK</u>			SECTION	<u>10</u>	
				T	<u>6</u>	R
					<u>N</u>	<u>3</u>
					<u>E</u>	

TYPE MONUMENT SM.R.R.SPIKE
 ON SURFACE - ~~BELOW~~ ON
 LEFT - ☉ PAV'T - RIGHT ON
12.8' TO LT EDGE PAVEMENT
 S.L.M. 334+54
 Grid: Northing: 673341.465 Easting: 1417737.012

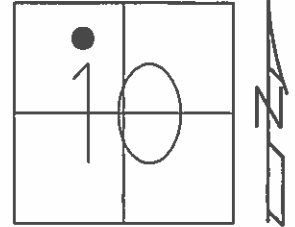

RECORD: C.S.
 STA. 333+66.67
 (OLD PLAN)
 SET MAG/WASHER
 9/24/02, MRC
 FD P.K./WASHER
 6/13/11
 SET MAG/WASHER
 GPS, FA17
 2/7/12, SAH