



O.D.O.T. DISTRICT 2 SURVEY OFFICE (USE ONLY)

PERSONNEL \_\_\_\_\_ REFERENCE NO. 20 SHEET 16 OF 56  
 NOTES CANTERBURY DATE 6/4/02 ROUTE US 127  
 H.C. BARNHISEL WEATHER CLOUDY COUNTY WILLIAMS  
 R.C. MALINSKY TEMP. 68° TOWNSHIP PULASKI  
 \_\_\_\_\_ SECTION 3  
 \_\_\_\_\_ T 6 N R 3 E

TYPE MONUMENT P.K.NAIL  
 ON SURFACE - ~~BELOW~~ ON \_\_\_\_\_  
~~LEFT~~ - CL PAV'T - RIGHT 0.4'  
9.9' TO RT EDGE PAVEMENT  
 S.L.M. 364+70

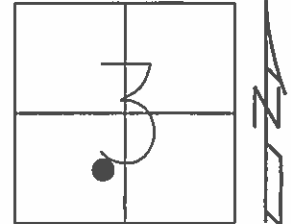

Grid: Northing: 676134.241 Easting: 1418626.973

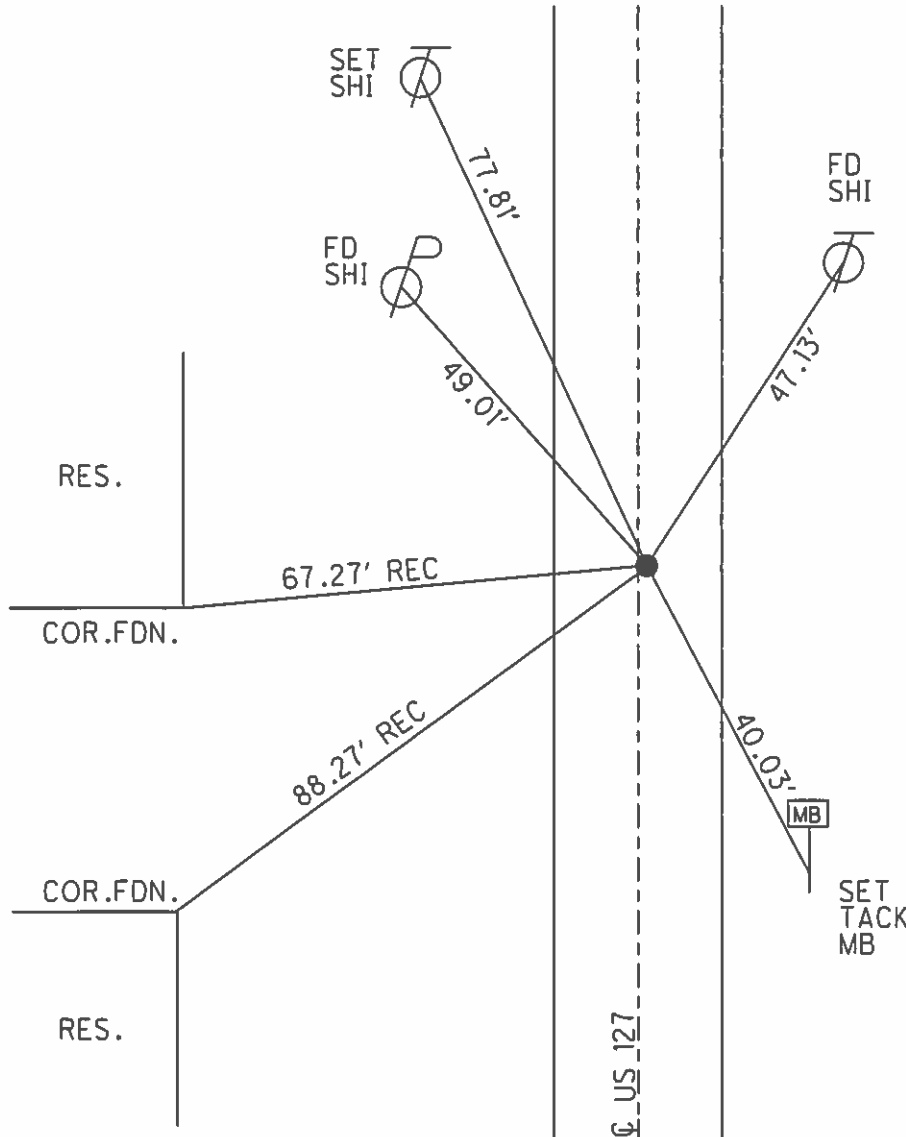

RECORD: P.I.  
 STA. 363+82.12  
 (OLD PLAN)  
 SET MAG/WASHER  
 8/21/03, MDB  
 FD MAG/WASHER  
 6/14/11  
 SET MAG/WASHER  
 GPS, F20  
 2/7/12, SAH