



O.D.O.T. DISTRICT 2 SURVEY OFFICE (USE ONLY)

PERSONNEL \_\_\_\_\_ REFERENCE NO. 21 SHEET 17 OF 56  
 NOTES CANTERBURY DATE 6/4/02 ROUTE US 127  
 H.C. BARNHISEL WEATHER CLOUDY COUNTY WILLIAMS  
 R.C. MALINSKY TEMP. 68° TOWNSHIP PULASKI  
MACHALAK SECTION 3  
 T 6 N R 3 E

TYPE MONUMENT SM.R.R.SPIKE  
 ON SURFACE - ~~BELOW~~ ON \_\_\_\_\_  
~~LEFT~~ - CL PAV'T - RIGHT 4.8'  
6.3' TO RT EDGE PAVEMENT  
 S.L.M. 373+04

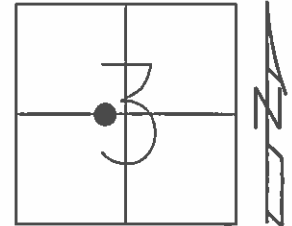

Grid: Northing: 676968.935 Easting: 1418653.560

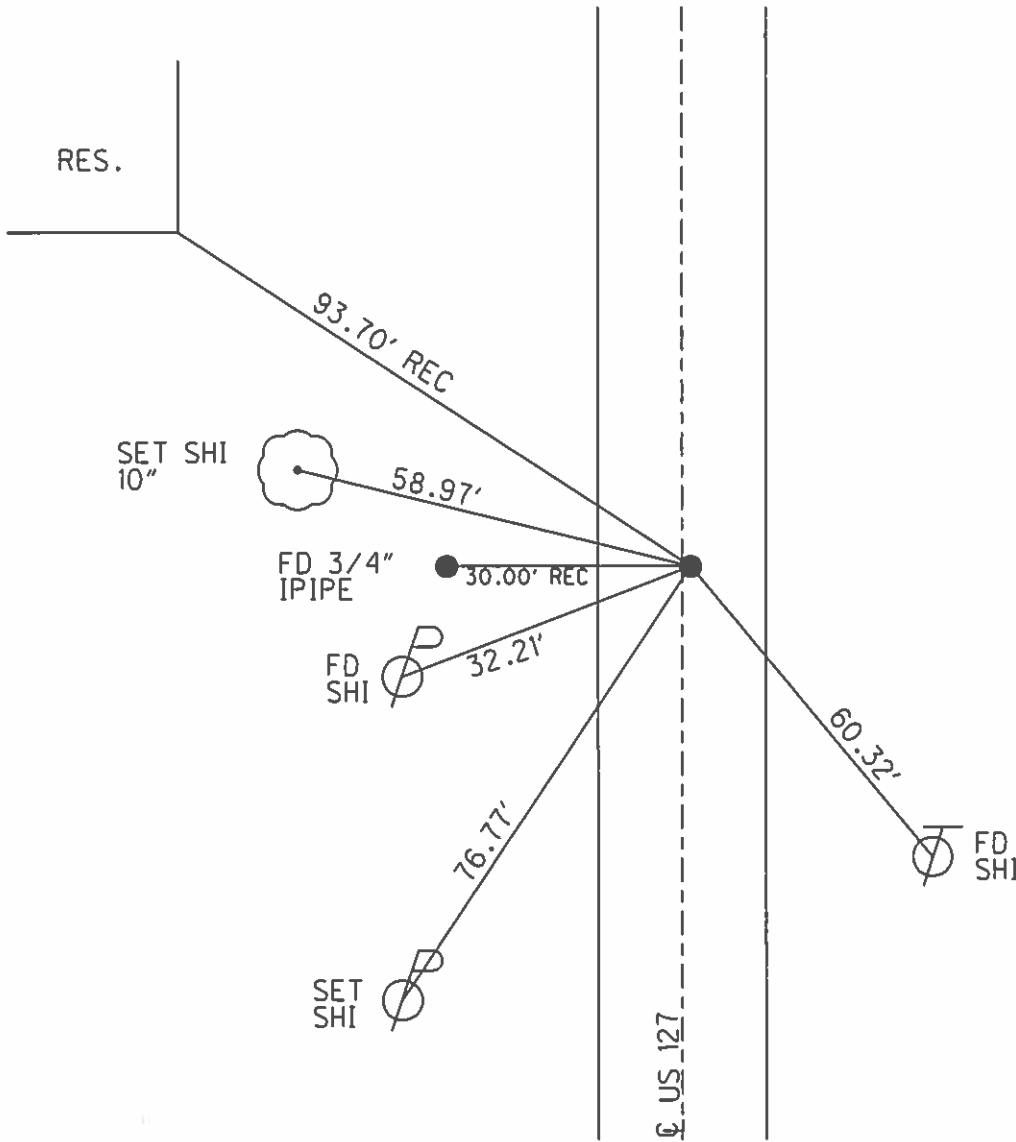

RECORD: P.I.  
 STA. 372+17.57  
 (OLD PLAN)  
 SET MAG/WASHER  
 8/21/03, MDB  
 FD MAG/WASHER  
 6/14/11  
 SET MAG/WASHER  
 GPS, F21  
 2/10/12, SAH