
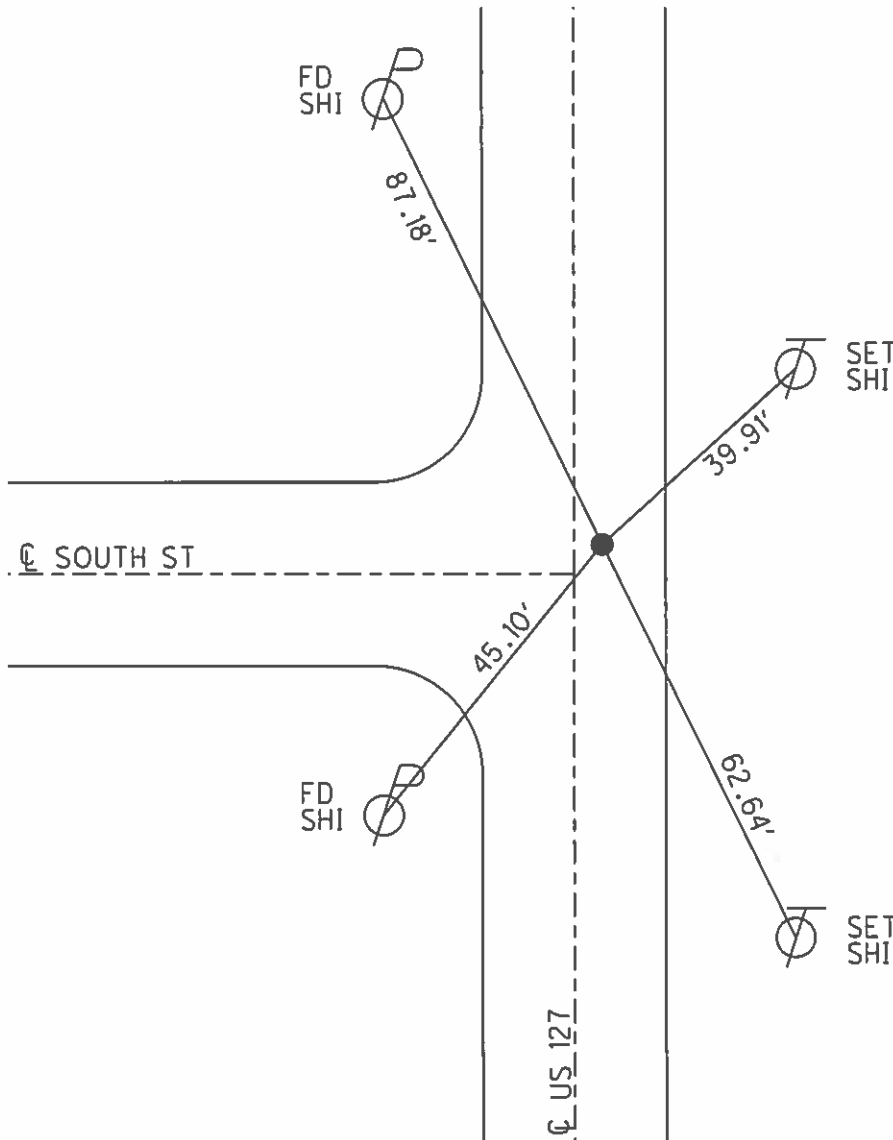


O.D.O.T. DISTRICT 2 SURVEY OFFICE (USE ONLY)

PERSONNEL _____ REFERENCE NO. 21 A SHEET 18 OF 56
 NOTES CANTERBURY DATE 6/4/02 ROUTE US 127
 H.C. BARNHEISEL WEATHER CLOUDY COUNTY WILLIAMS
 R.C. MALINSKY TEMP. 68° TOWNSHIP PULASKI
MACHALAK SECTION 3
T 6 N R 3 E

TYPE MONUMENT P.K.NAIL
 ON SURFACE - ~~BELOW~~ ON _____
~~LEFT~~ - CL PAV'T - RIGHT 3.3', 3' N. CL WEST
7.0' TO RT EDGE PAVEMENT
 S.L.M. 374+65
 Grid: Northing: 677129.577 Easting: 1418654.189

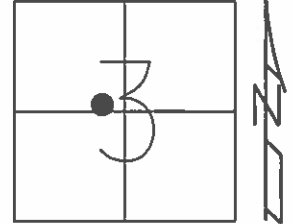

RECORD:
 SET MAG/WASHER
 8/21/03, MDB
 FD MAG/WASHER
 6/14/11
 SET MAG/WASHER
 GPS, FA21
 2/10/12, SAH