
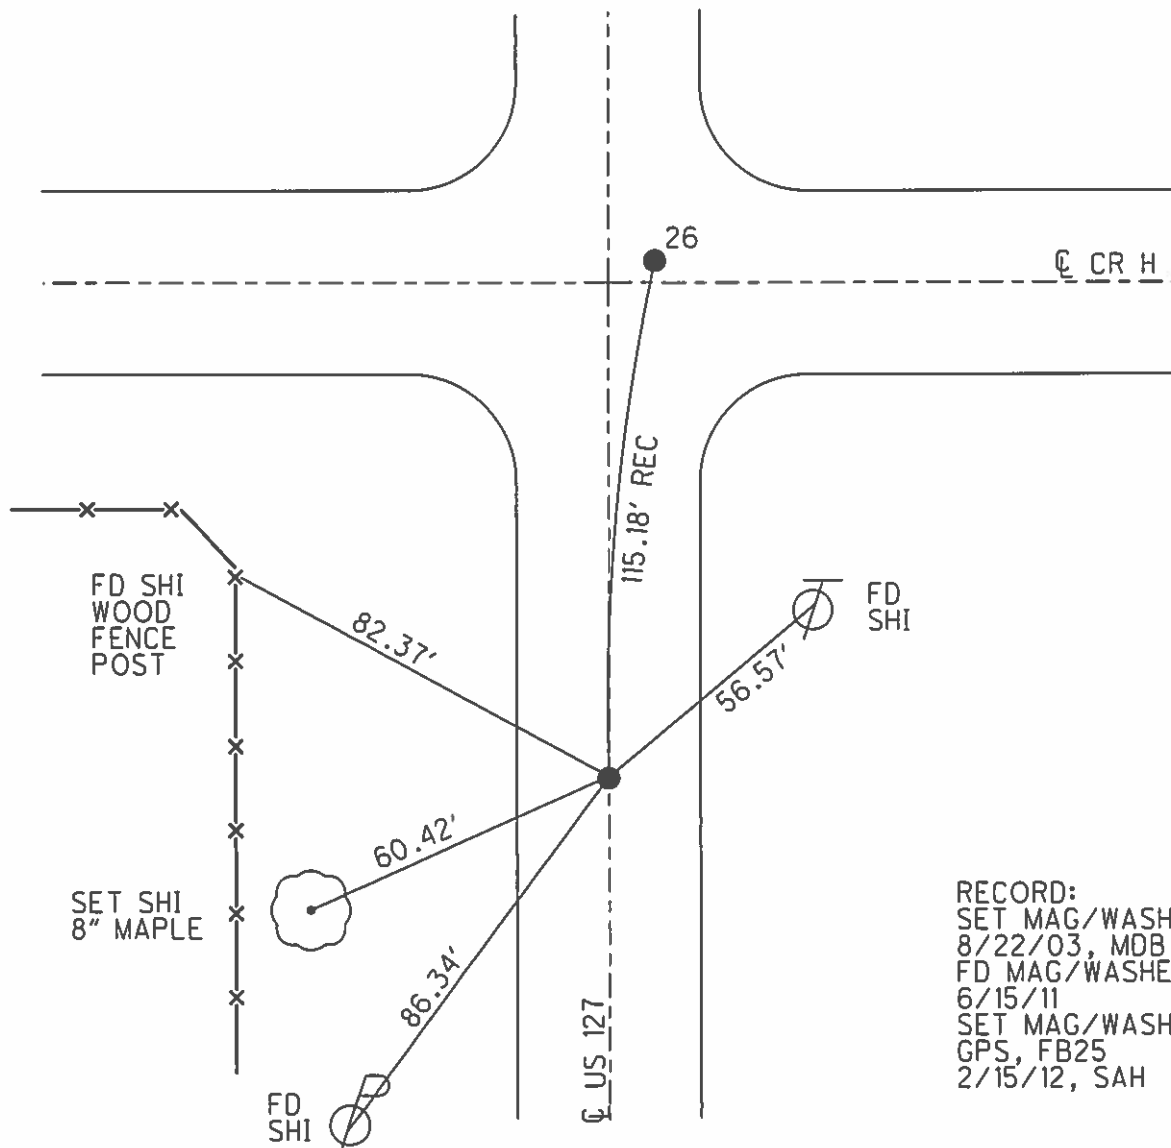


O.D.O.T. DISTRICT 2 SURVEY OFFICE (USE ONLY)

PERSONNEL _____ REFERENCE NO. 25 B SHEET 25 OF 56
 NOTES CHELBECK DATE 6/6/02 ROUTE US 127
 H.C. BARNHISEL WEATHER CLOUDY COUNTY WILLIAMS
 R.C. SIEFRING TEMP. 65° TOWNSHIP JEFFERSON
 _____ SECTION 34
 _____ T 7 N R 3 E

TYPE MONUMENT P.K.NAIL
 ON SURFACE - ~~BELOW~~ ON _____
~~LEFT~~ - Q PAV'T - RIGHT 0.3'
11.0' TO RT EDGE PAVEMENT
 S.L.M. 449+62
 Grid: Northing: 684593.520 Easting: 1418940.950

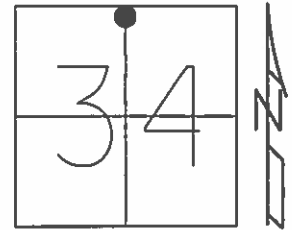

RECORD:
 SET MAG/WASHER
 8/22/03, MDB
 FD MAG/WASHER
 6/15/11
 SET MAG/WASHER
 GPS, FB25
 2/15/12, SAH