


O.D.O.T. DISTRICT 2 SURVEY OFFICE (USE ONLY)


PERSONNEL _____ REFERENCE NO. 45 SHEET 6 OF 12
 NOTES RHOADES DATE 11/21/17 ROUTE US 127
 H.C. O'DONNELL WEATHER FAIR COUNTY WILLIAMS
 R.C. FARKAS TEMP. 42° TOWNSHIP BRADY
 SECTION 5
 T 7 N R 4 E

TYPE MONUMENT MAG/WASHER
 ON SURFACE - ~~BELOW~~ ON _____
 LEFT - ☉ PAV'T - RIGHT ON _____
 - TO - EDGE PAVEMENT
 S.L.M. 768+24

Grid: Northing: 705299.336 Easting: 1440101.102

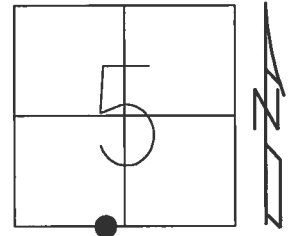

NOTE: REF 20 US 20A

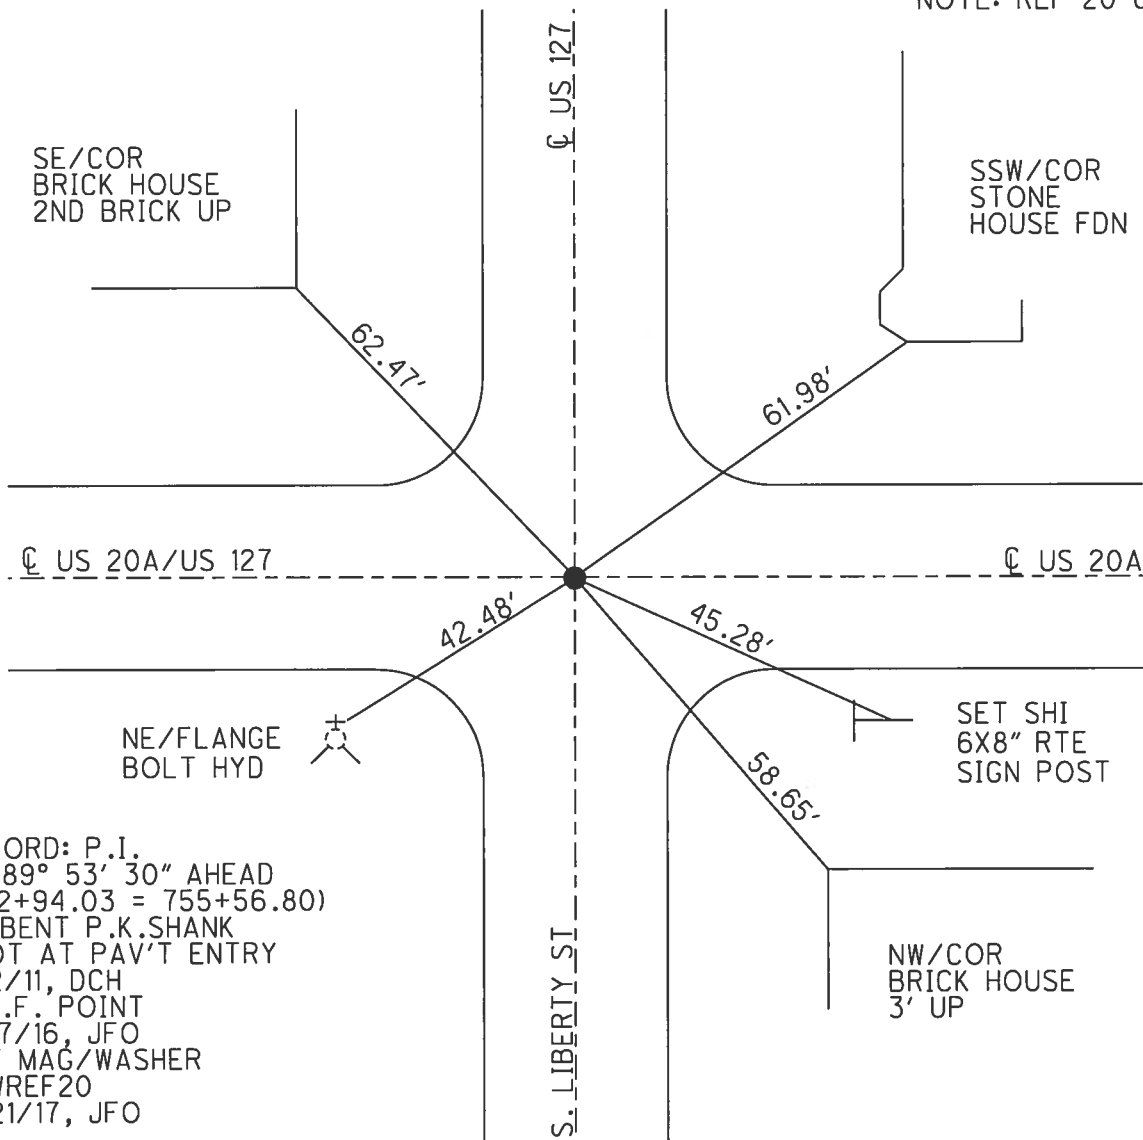



RECORD: P.I.
 $\Delta = 89^\circ 53' 30''$ AHEAD
 (702+94.03 = 755+56.80)
 FD BENT P.K.SHANK
 SHOT AT PAV'T ENTRY
 8/2/11, DCH
 D.N.F. POINT
 5/17/16, JFO
 SET MAG/WASHER
 NEWREF20
 11/21/17, JFO

O.D.O.T. DISTRICT 2 SURVEY OFFICE (USE ONLY)

PERSONNEL _____ REFERENCE NO. 45 SHEET _____ OF _____

NOTES ROUSOS DATE 8/2/11 ROUTE US 127
 H.C. HARBAUGH WEATHER CLOUDY COUNTY WILLIAMS
 R.C. HOMAN TEMP. 82° TOWNSHIP BRADY
 _____ SECTION 5
 _____ T 7 N R 4 E

TYPE MONUMENT P.K. SHANK
 ON SURFACE - ~~BELOW~~ ON _____
 LEFT - Q PAV'T - RIGHT ON _____
 - TO - EDGE PAVEMENT
 S.L.M. 768+24
 Grid: Northing: 705299.410 Easting: 1440101.162

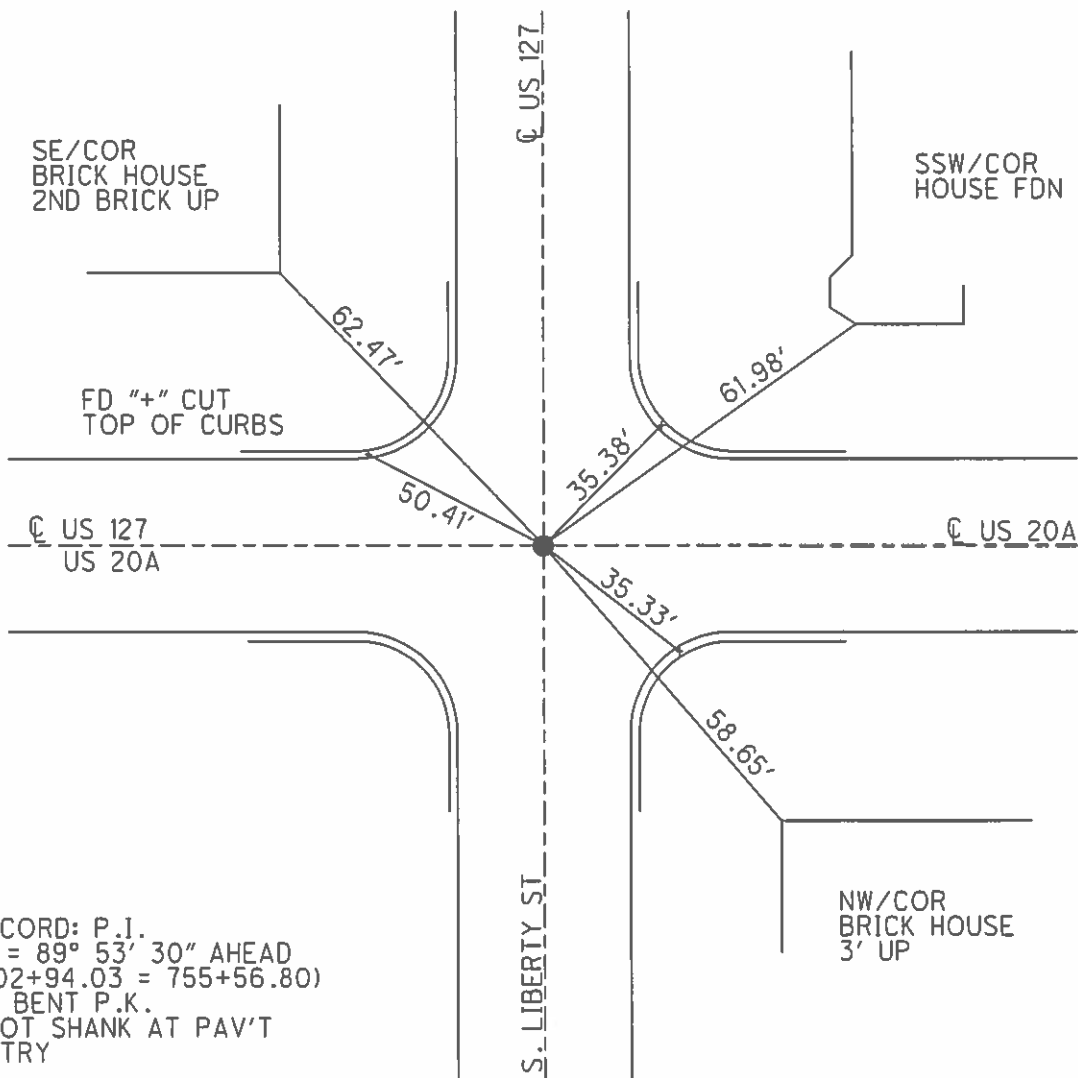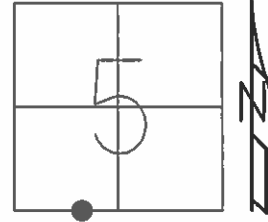

RECORD: P.I.
 $\Delta = 89^\circ 53' 30''$ AHEAD
 (702+94.03 = 755+56.80)
 FD BENT P.K.
 SHOT SHANK AT PAV'T
 ENTRY

O.D.O.T. DISTRICT 2 SURVEY OFFICE 21 of 28

PERSONNEL

REFERENCE NO. 20

SHEET 21 OF 21

NOTES ^{MB} J. CURTIS

5-28-02

H.C. MC J. HOUSEHOLDER

DATE 3-2-90

ROUTE U.S. 20-A

R.C. CB

WEATHER MILD cloudy

COUNTY WILLIAMS

Bm

TEMP. 35° +70°

TOWNSHIP BRADY

SECTION 5

T14R4E


TYPE MONUMENT SN. R.R. SPK.

ON SURFACE - BELOW ON SURFACE


LEFT - PAV'T. - RIGHT 3'± LEFT & PAV'T

TO EDGE PAVEMENT

S.L.M. 702+56

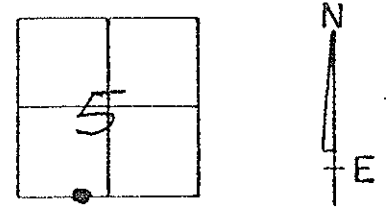

OK 8-07-90 IRS

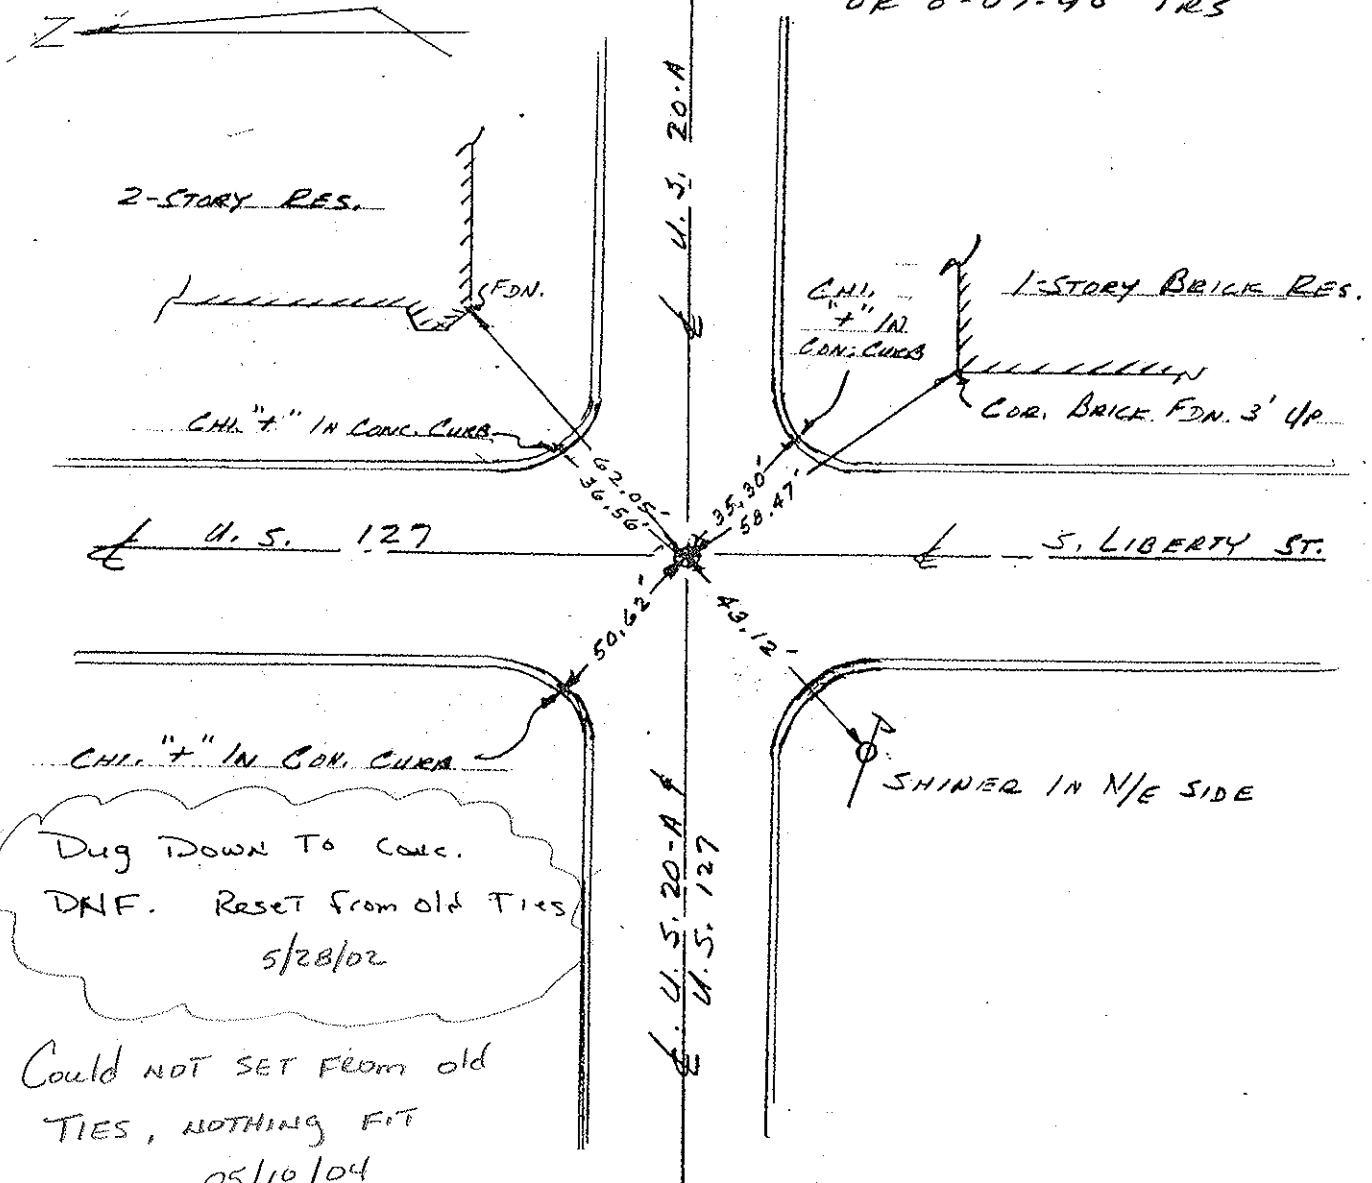

Dug Down To Conc.
DNF. Reset From old TIES
5/28/02

Could NOT SET FROM old
TIES, NOTHING FIT
05/10/04
MB

NOTE: