



O.D.O.T. DISTRICT 2 SURVEY OFFICE (USE ONLY)

PERSONNEL _____ REFERENCE NO. 28 B SHEET 8 OF 12
 NOTES RHOADES DATE 5/2/13 ROUTE US 127
 H.C. CODER WEATHER FAIR COUNTY WILLIAMS
 R.C. LAU TEMP. 75° TOWNSHIP BRADY
 _____ SECTION 5
 _____ T 7 N R 4 E

TYPE MONUMENT DRILL HOLE
 ON SURFACE - ~~BELOW~~ ON _____
 LEFT - ☉ PAV'T - ~~RIGHT~~ - _____
 _____ TO _____ EDGE PAVEMENT
 S.L.M. 778+91.14

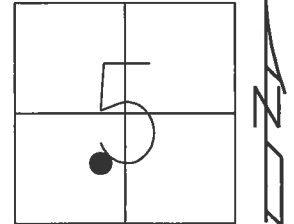

Grid: Northing: 706366.386 Easting: 1440121.539

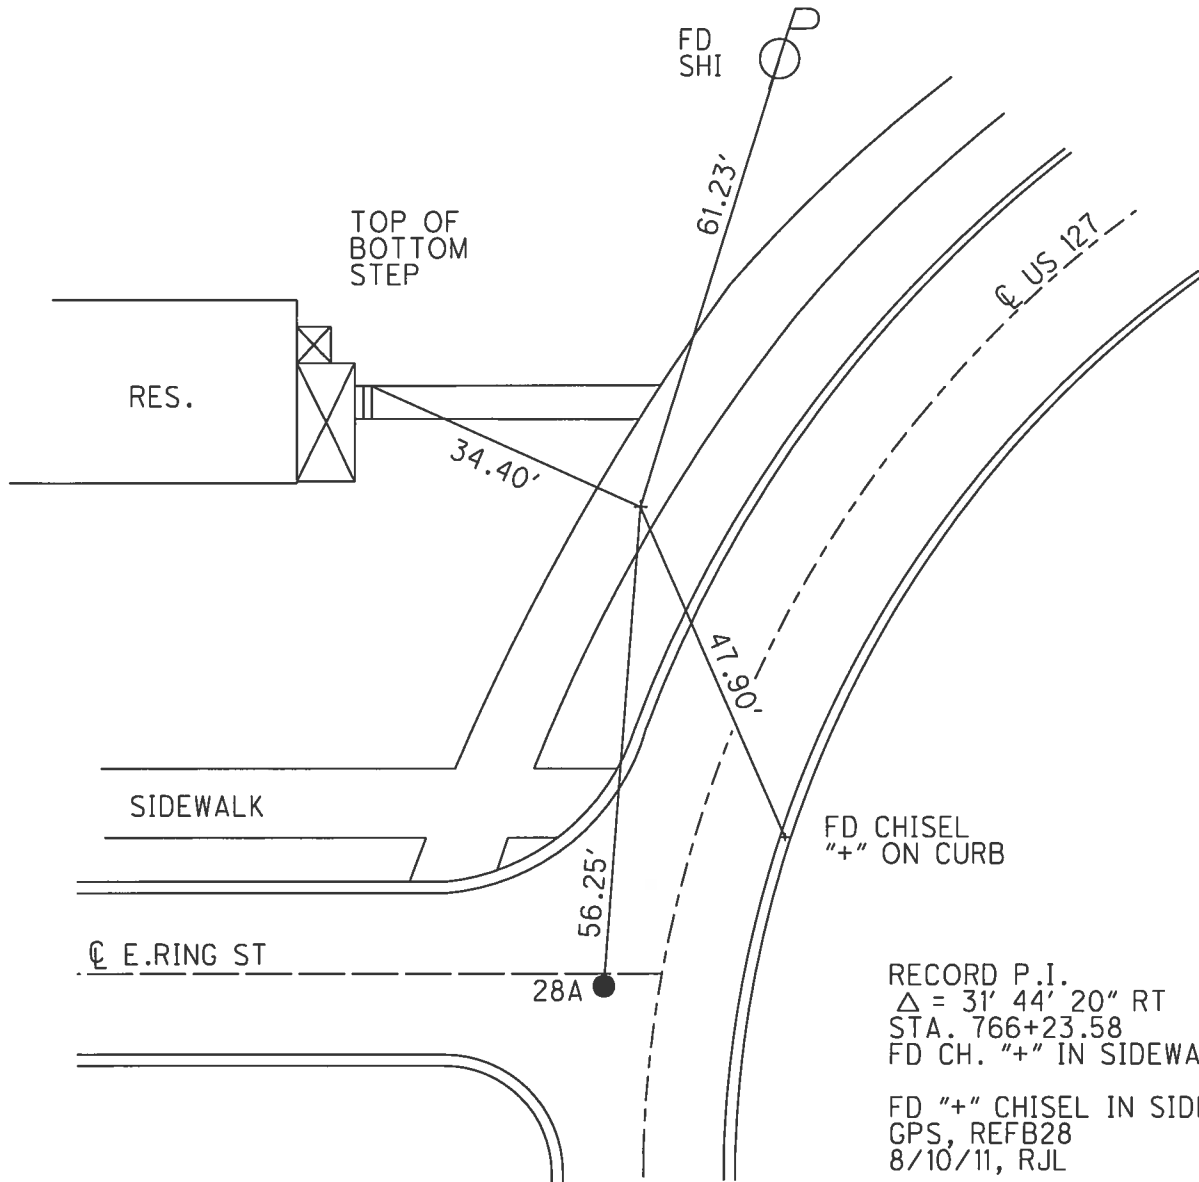

RECORD P.I.
 $\Delta = 31' 44' 20''$ RT
 STA. 766+23.58
 FD CH. "+" IN SIDEWALK
 FD "+" CHISEL IN SIDEWALK
 GPS, REFB28
 8/10/11, RJL