

O.D.O.T. DISTRICT 2 SURVEY OFFICE (USE ONLY)

PERSONNEL

REFERENCE NO. 32 AA

SHEET 5 OF 32

NOTES ROUSOS
 H.C. HARBUAGH
 R.C. HOMAN

DATE 10/24/16
 WEATHER CLOUDY
 TEMP. 46°

ROUTE US 127
 COUNTY WILLIAMS
 TOWNSHIP BRADY
 SECTION 32

DWG BY MILLER PID 95864

T 8 N R 4 E

TYPE MONUMENT 1" IPIN

~~ON SURFACE~~ - BELOW 4.5"

OFFSET \varnothing PAVEMENT 1' LT : ~~RT~~

- TO - EDGE PAVEMENT



STATION: 840+59.24

HORIZ.DATUM: NAD83 (2011)

GEOID: GEOID 2012A

GRID: NORTHING: 711854.768

EASTING: 1443108.958

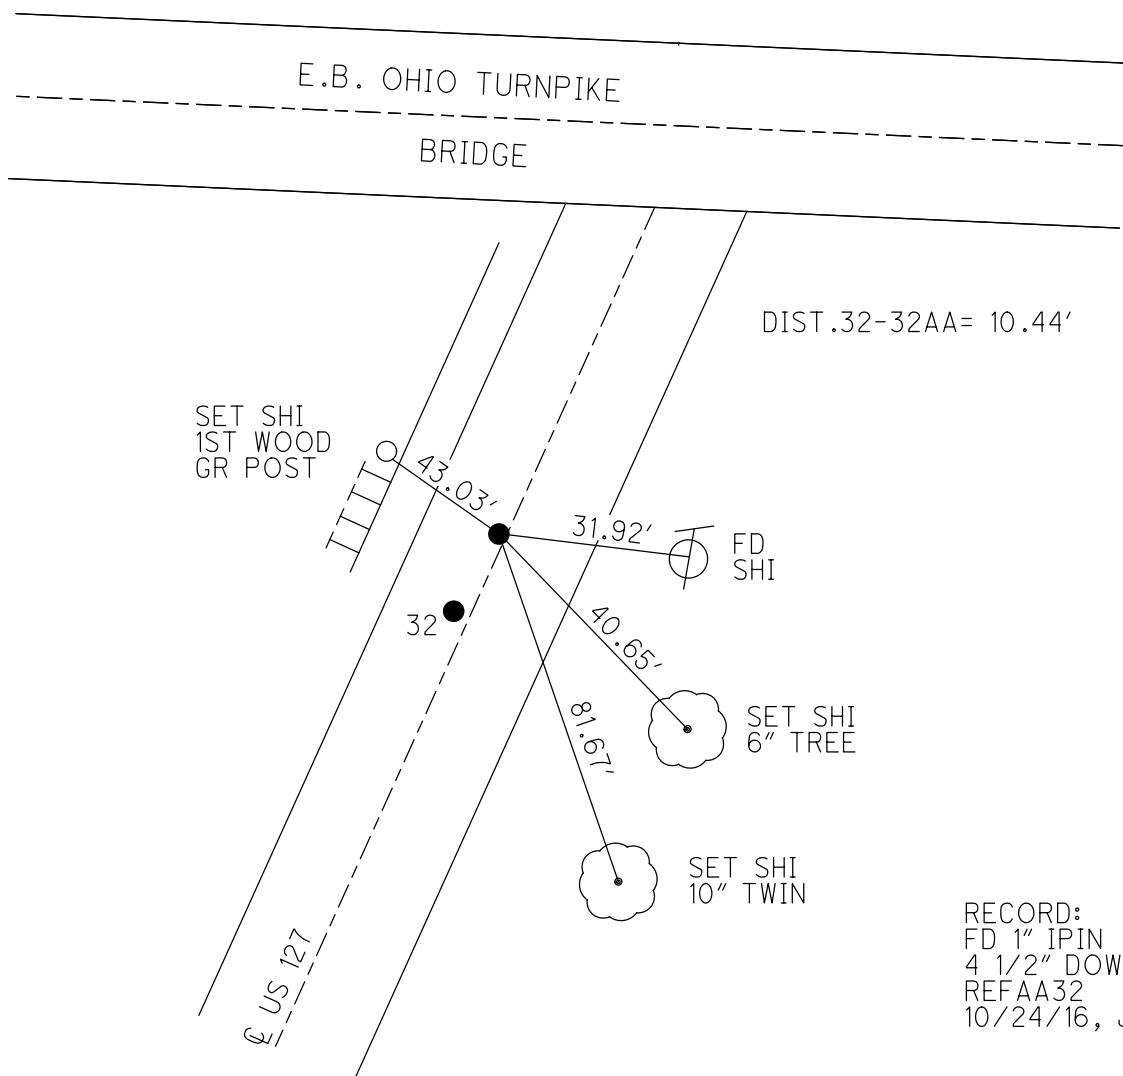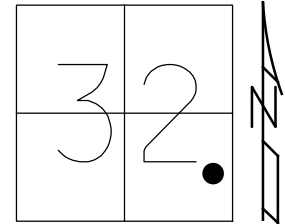

RECORD:
 FD 1" IPIN
 4 1/2" DOWN
 REFAA32
 10/24/16, JLL