



O.D.O.T. DISTRICT 2 SURVEY OFFICE (USE ONLY)

PERSONNEL _____ REFERENCE NO. 37 A SHEET 16 OF 31
 NOTES HARBAUGH DATE 6/22/11 ROUTE US 127
 H.C. ROUSOS WEATHER CLOUDY COUNTY WILLIAMS
 R.C. HOMAN TEMP. 58° F TOWNSHIP MILLCREEK
 _____ SECTION 3
 _____ T 10 S R 1 W

TYPE MONUMENT P.K.SHANK
 ON SURFACE - ~~BELOW~~ ON _____
~~LEFT~~ - Q PAV'T - RIGHT 4.7'
 - TO - EDGE PAVEMENT
 S.L.M. 928+64.78

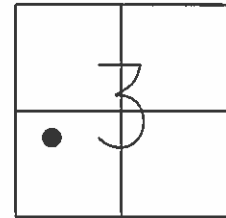

GRID: NORTHING: 720391.524 EASTING: 1444917.789

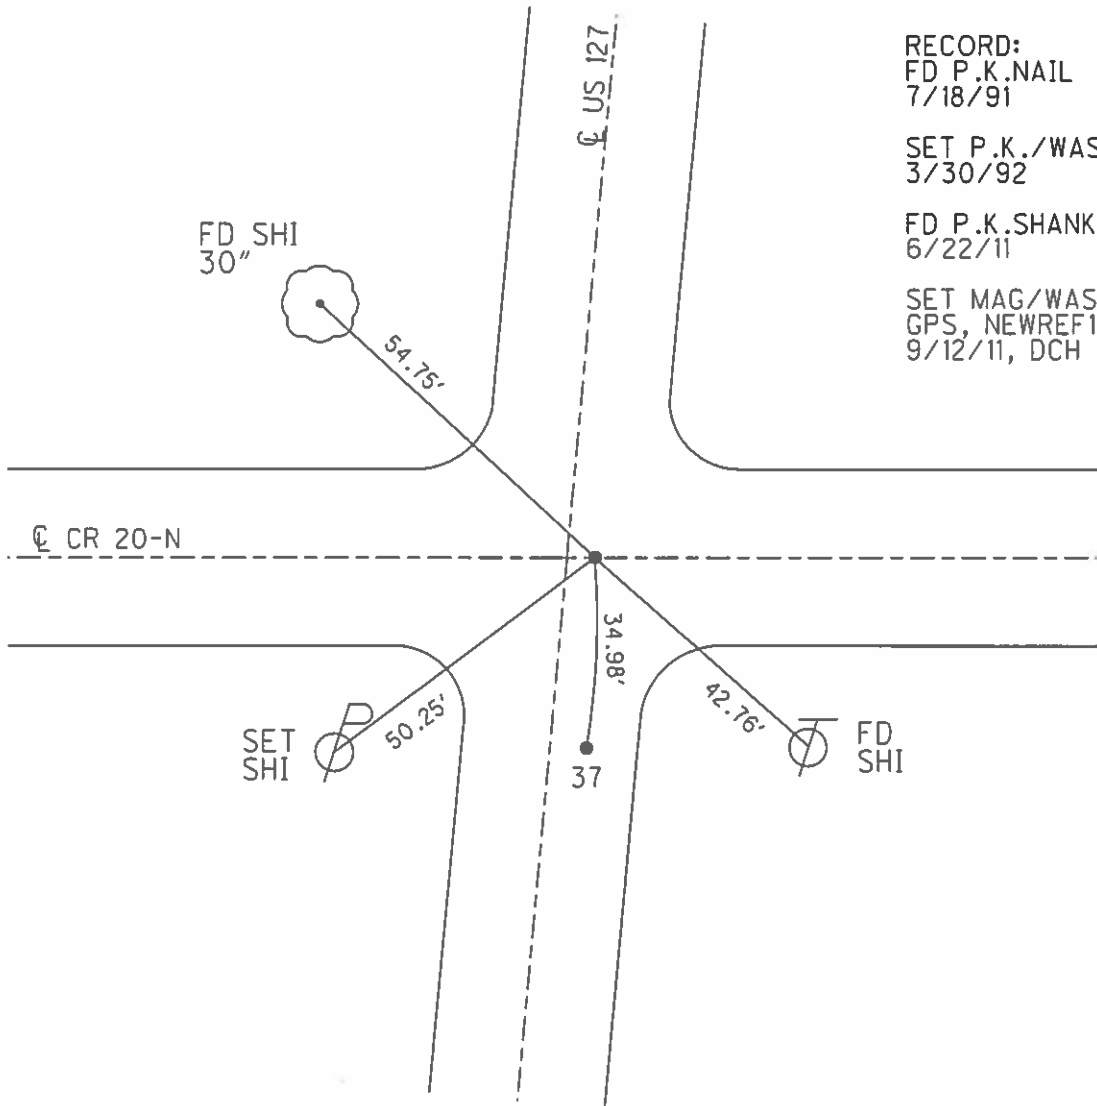

RECORD:
 FD P.K.NAIL
 7/18/91
 SET P.K./WASHER
 3/30/92
 FD P.K.SHANK
 6/22/11
 SET MAG/WASHER
 GPS, NEWREF122
 9/12/11, DCH