


O.D.O.T. DISTRICT 2 SURVEY OFFICE (USE ONLY)

PERSONNEL	REFERENCE NO.	<u>37 D</u>	SHEET	<u>19</u>	OF	<u>31</u>
NOTES	<u>ROUSOS</u>	DATE	<u>6/23/11</u>	ROUTE	<u>US 127</u>	
H.C.	<u>HARBUAGH</u>	WEATHER	<u>CLEAR</u>	COUNTY	<u>WILLIAMS</u>	
R.C.	<u>HOMAN</u>	TEMP.	<u>80 F</u>	TOWNSHIP	<u>MILLCREEK</u>	
				SECTION	<u>3</u>	
				T	<u>10</u>	R
				S		W

TYPE MONUMENT P.K.NAIL
 ON SURFACE - ~~BELOW~~ ON _____
~~LEFT~~ - Q PAV'T - RIGHT 2.7'
 - TO - EDGE PAVEMENT
 S.L.M. 948+99.93

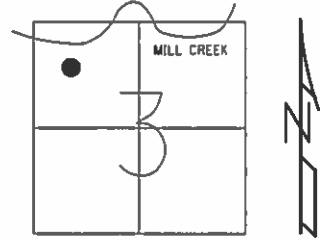

GRID: NORTHING: 722387.922 EASTING: 1445302.519

RECORD: P.I.
 STA. 152+50±
 = BRIDGE PLAN
 (1948) OF 15+19.56

FD P.K.NAIL
 7/18/91

SET P.K./WASHER
 3/30/92

FD P.K.NAIL
 6/23/11

SET MAG/WASHER
 GPS, NEWREF125
 9/12/11, DCH

