
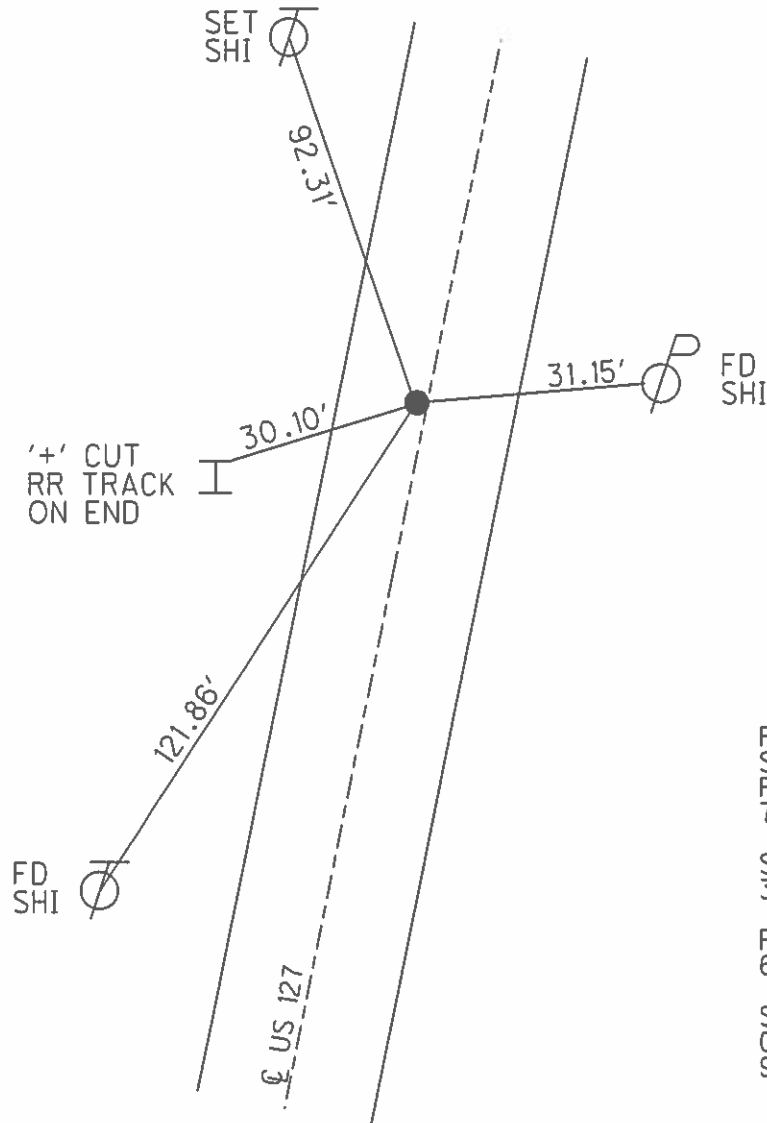


O.D.O.T. DISTRICT 2 SURVEY OFFICE (USE ONLY)

PERSONNEL _____ REFERENCE NO. 38 B SHEET 22 OF 31
 NOTES ROUSOS DATE 6/23/11 ROUTE US 127
 H.C. HARBUAGH WEATHER OVERCAST COUNTY WILLIAMS
 R.C. HOMAN TEMP. 70° F TOWNSHIP MILLCREEK
 _____ SECTION 34
 _____ T 10 S R 1 W

TYPE MONUMENT _____ PK NAIL _____
 ON SURFACE - ~~BELOW~~ ON _____
 LEFT - ☉ PAV'T - ~~RIGHT~~ 1.5' _____
 _____ TO _____ EDGE PAVEMENT
 S.L.M. 974+07.63
 GRID: NORTHING: 724847.774 EASTING: 1445789.699

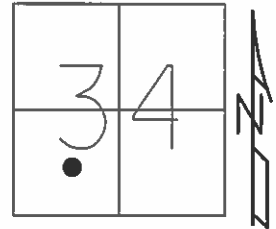

RECORD: P.I.
 STA. 177+62.25
 FD P.K.NAIL
 7/18/91

SET P.K./WASHER
 3/30/92

FD P.K.NAIL
 6/23/11

SET MAG/WASHER
 GPS, NEWREF128
 9/23/11, DCH