


O.D.O.T. DISTRICT 2 SURVEY OFFICE (USE ONLY)


PERSONNEL _____ REFERENCE NO. 40 A SHEET 25 OF 31
 NOTES ROUSOS DATE 6/23/11 ROUTE US 127
 H.C. HARBUAGH WEATHER OVERCAST COUNTY WILLIAMS
 R.C. HOMAN TEMP. 70 TOWNSHIP MILLCREEK
 _____ SECTION 27
 _____ T 10 S R 1 W

TYPE MONUMENT P.K./WASHER
 ON SURFACE - ~~BELOW~~ ON
 LEFT - ☉ PAV'T - ~~RIGHT~~ 4.4'
 _____ TO _____ EDGE PAVEMENT
 S.L.M. 1020+27.94

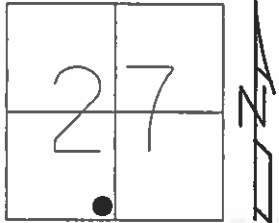

GRID: NORTHING: 729385.573 EASTING: 1446659.094

- RECORD:
 FD 3/4" IPIPE
 1/2" BELOW SURFACE
 ORIGIN UNKNOWN
 FD SM.R.R.SPIKE
 7/18/91
 SET P.K./WASHER
 3/30/92
 FD P.K.NAIL
 6/23/11
 SET MAG/WASHER
 GPS, NEWREF131
 9/26/11, DCH

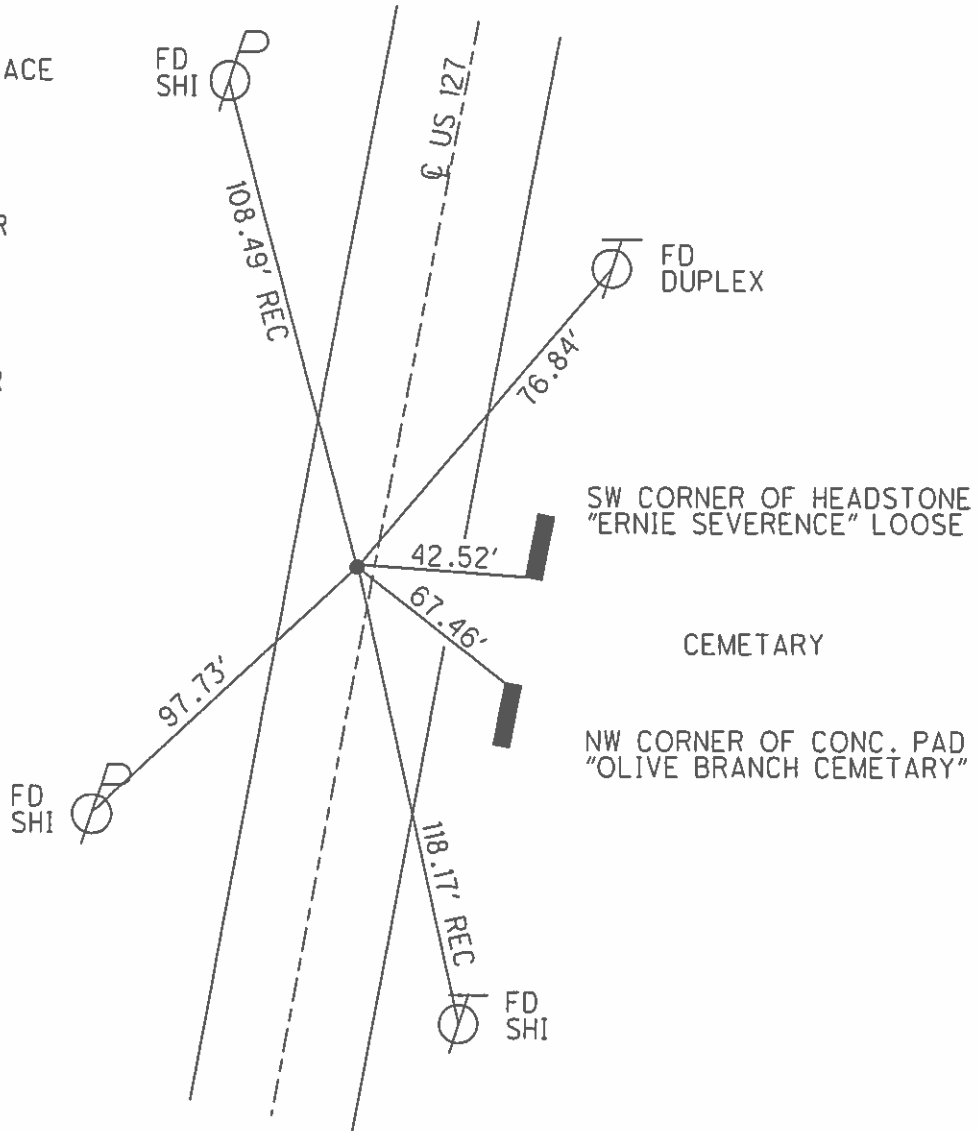


O.D.O.T. DISTRICT 2 SURVEY OFFICE (USE ONLY)

PERSONNEL _____ REFERENCE NO. 40 A SHEET 25 OF 31
 NOTES ROUSOS DATE 6/23/11 ROUTE US 127
 H.C. HARBUAGH WEATHER OVERCAST COUNTY WILLIAMS
 R.C. HOMAN TEMP. 70° F TOWNSHIP MILLCREEK
 _____ SECTION 27
 _____ T 10 S R 1 W

TYPE MONUMENT P.K./WASHER
 ON SURFACE - ~~BELOW~~ ON
 LEFT - Q PAV'T - ~~RIGHT~~ 4.4'
 _____ TO _____ EDGE PAVEMENT
 S.L.M. 1020.27.94

GRID: NORTHING: 729385.573 EASTING: 1446659.094

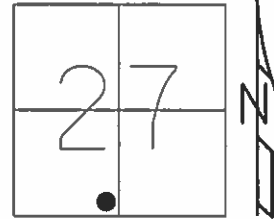

RECORD:
 FD 3/4" IPIPE
 1/2" BELOW SURFACE
 ORIGIN UNKNOWN

FD SM.R.R.SPIKE
 7/18/91

SET P.K./WASHER
 3/30/92

FD P.K.NAIL
 6/23/11

SET MAG/WASHER
 GPS, NEWREF131
 9/26/11, DCH

