

ODOT (D-2) 701
Field Notes
J.H. 3-5-98

1999 TWO-LANE RESURFACING PROGRAM

DATE 2/98
PERSONNEL CANTERBURY
ROUSOS
WATSON

PRIORITY NO. _____ PART 1 OF 2 SHEET 1 OF 17
COUNTY WILLIAMS ROUTE US 6 SECTION 33.618
BEGIN LOG (SLM) 33.618 TERMINII SR 191
END LOG (SLM) 39.042 TERMINII HENRY COUNTY
TOTAL LENGTH 5.424 Km. ~~MILES~~
MUNICIPALITY — BEGIN LOG (SLM) _____ END LOG (SLM) _____
MUNICIPALITY — BEGIN LOG (SLM) _____ END LOG (SLM) _____

PROPOSED WORK: 0.038m of Bituminous Pavement Planing and Resurface
PAVEMENT 0.038m Surface/0.044m Intermediate SHOULDER Same - 617

OTHER _____

STATION ESTABLISHED FROM: August 86 REF. POINT #23 BY I. STONE
P.K. NAIL Fd. @ SURFACE STA = 34 + 193.98 (SLK)
OLD STA = 1121 + 85 (SLM)

STRUCTURES:

NUMBER	STATION	WIDTH	LENGTH	PROPOSED WORK
WIL-6-2173	34 + 979.58	10.36 ^m	40.53 ^m	APPROACH SLABS 5.00 ^m IN LENGTH

RAILROAD CROSSING:

(NO WORK)

1999 ² TWO-LANE RESURFACING PROGRAM
PAVEMENT DATA

199*7
9

NOTE: LOCATE ALL
CHANGES IN PVMT WIDTH

COUNTY WILLIAMS

ROUTE U.S. 6 SECTION 33.618 SK

[illegible]

33.618 SLK

[illegible]

1999 TWO-LANE RESURFACING PROGRAM
PAVEMENT DATA

NOTE: LOCATE ALL CHANGES IN PVMT WIDTH

COUNTY WILLIAMS

ROUTE

V.S. #6

SECTION

33.618 SLK

* - STATION LOCATION

PAVEMENT MARKINGS:

[illegible]

**1999 TWO-LANE RESURFACING PROGRAM
DEFECTIVE PAVEMENT AREAS**

COUNTY _____ WILLIAMS _____ ROUTE _____ U.S. # 6 _____ SECTION _____ 33.618 54K _____

[illegible]

1945WH

OHIO DEPARTMENT OF TRANSPORTATION

SHEET NO. 6 OF 17

PERSONNEL CANTERBURY TITLE MP COUNTY WILLIAMS DATE 2-11-98
ROUSOS A S.R. U.S. #6 WEATHER RAIN
WATSON Φ SEC. 33.618 SLK TEMP. +45° F

DESCRIPTION U.S. #6 XSX'S TO CHECK CROWN JOB NO. _____
 LEFT CENTER LINE RIGHT

STA	LT. BERM	WHITE LINE	♀ PAVT.	WHITE LINE	RT. BERM
33 + 650	1.160	1.131	1.072 0	1.152	1.171
34 + 450	1.345	1.300	1.220	1.304	1.338
35 + 300	1.114	1.083	1.012	1.082	1.117
36 + 160	1.238	1.200	1.147	1.227	1.260
36 + 900	1.362	1.317	1.262	1.331	1.367
37 + 700	1.347	1.305	1.228	1.305	1.334
38 + 500	1.235	1.204	1.128	1.213	1.250
39 + 020	1.287	1.270	1.204	1.274	1.290

SHEET NO. 1 OF 1 DATE 2/17/98

PERSONNEL TITLE COUNTY WILLIAMS WEATHER CLOUDY

CANTERBURY ON S.R. U.S. # 6 + 45° F

ROUSOS WHEEL SEC. 33.618 SLK JOB NO.

WATSON RIGHT

OHIO DEPARTMENT OF TRANSPORTATION

PERSONNEL TITLE

CANTERBURY ON

ROUSOS WHEEL

WATSON


1945WH

PERSONNEL TITLE

CANTERBURY ON

ROUSOS WHEEL

WATSON

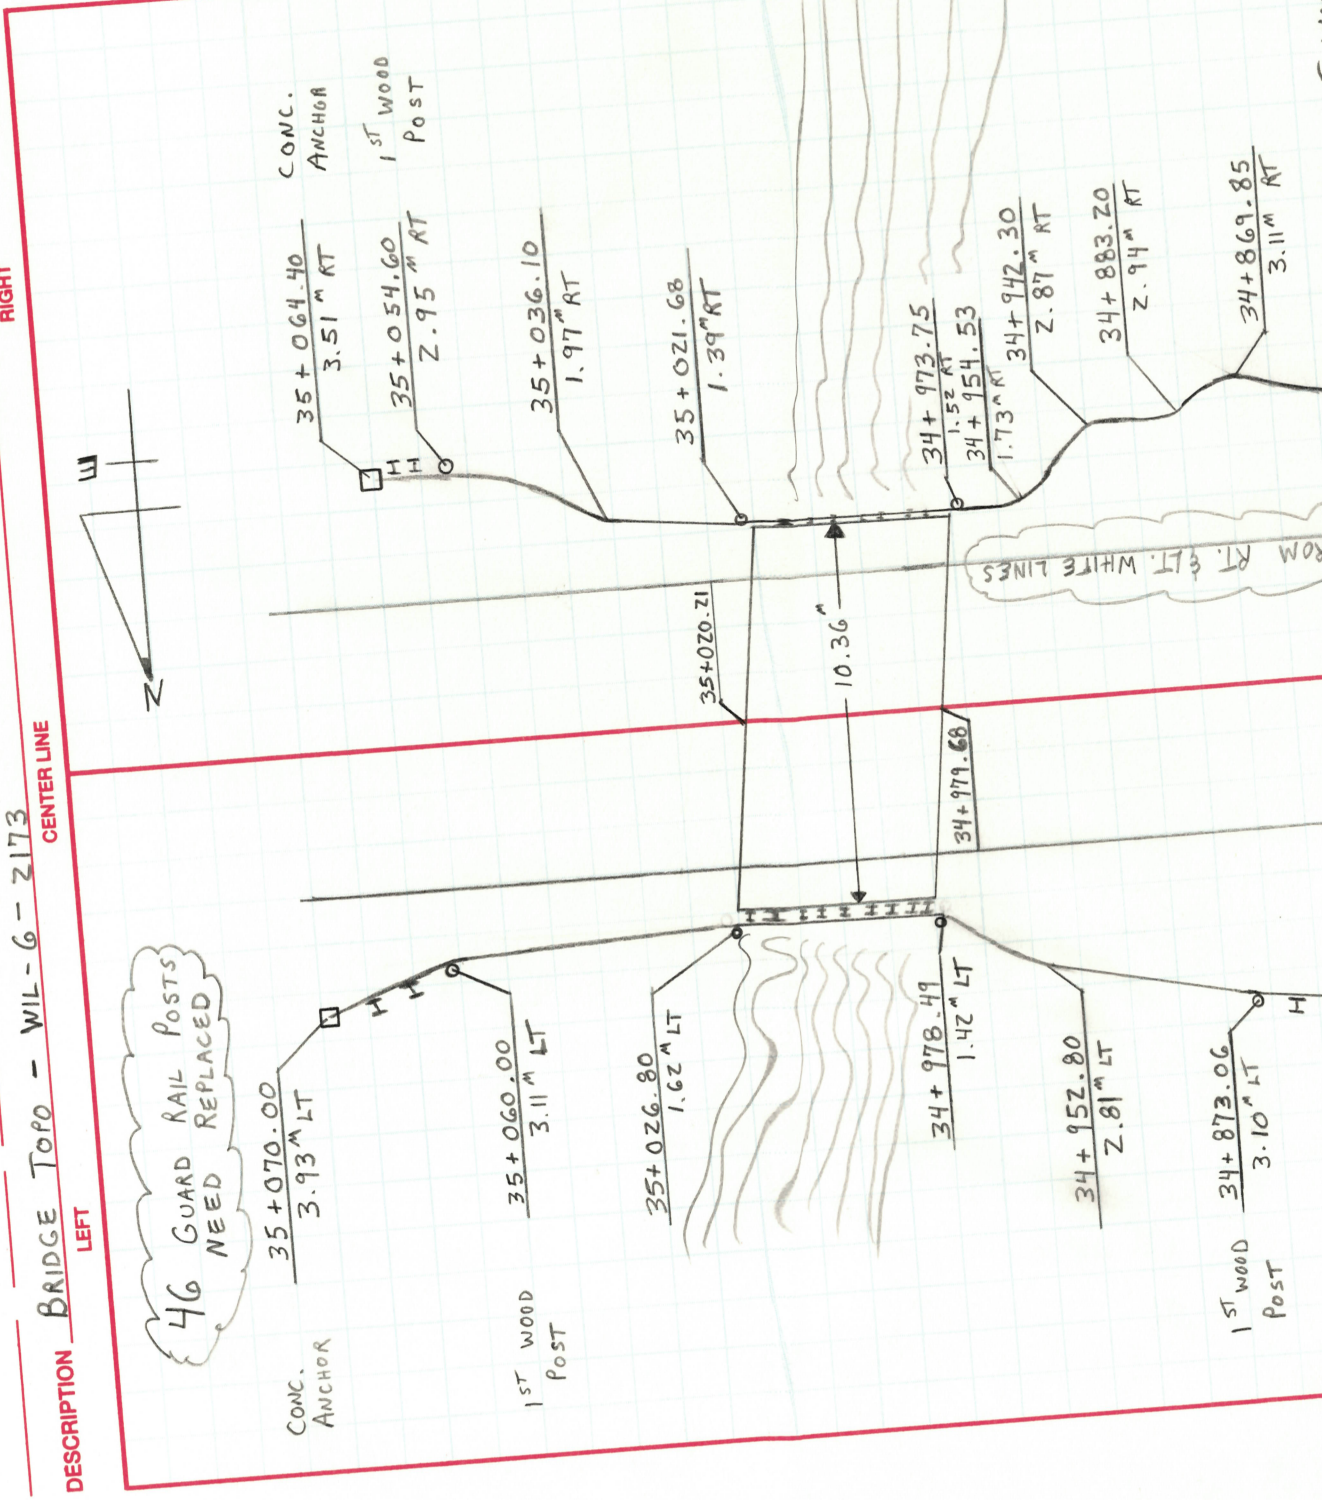

OHIO DEPARTMENT OF TRANSPORTATION

1945WH

PERSONNEL	TITLE	PERSONNEL	TITLE	COUNTY	WILLIAMS	DATE	2-10-98
CANTERBURY	π			S.R.	U.S. # 6	WEATHER	SUN
ROUSOS	α			SEC.	33.618	TEMP.	+45° F
WATSON	φ					JOB NO.	

DESCRIPTION		GUARDRAIL X-SECTIONS		FOR BRIDGE (WIL-6-2173)		RIGHT	
		LEFT		CENTER LINE			
				F.S.		ELEV.	
STA	B.M.	B.S.		101.236		100.000	
		1.236				Top N.W. Bolt of G-RAIL ANCHOR ASSEMBLY @ STA 34+838.90, 5.8" RT.	
34+815						WHITE BERM	
						0.545 0.581 0.39 0.12	
						0 1.25 5.7 11.4	
34+830						WHITE BERM	
						0.692 0.708 0.76 1.20 0.51	
						0 0.80 2.0 5.0 6.8 9.8	
34+845						WHITE BERM	
						0.847 0.868 1.01 1.00	
						0 0.76 1.9 3.0	
34+860						WHITE BERM	
						0.950 0.970 1.20 1.33	
						0 0.76 2.1 3.03	
34+875						WHITE BERM	
						1.040 1.050 1.36 1.48	
						0 0.75 2.4 3.03	
						4.52 12.2	

OHIO DEPARTMENT OF TRANSPORTATION

194SWH

PERSONNEL	TITLE	PERSONNEL	TITLE	COUNTY	WILLIAMS	DATE	2-10-98
CANTERBURY	K III			S.R.	U.S. #6	WEATHER	SUN
ROUSOS	OR			SEC.	33.618	TEMP.	+45° F
WATSON	Φ					JOB NO.	

DESCRIPTION		GUARDRAIL X-SECTIONS FOR BRIDGE (WIL-6-2173)		CENTER LINE		LEFT		RIGHT	
STA		B.S.	π	F.S.		WHITE LINE	BERM	WHITE LINE	BERM
34+905		2.67 6.2	1.63 4.1	1.42 3.18	1.29 1.9	1.202 0.81	1.172 0	1.207 0	1.230 0.79
		4.53 10.2	4.43 14.0	1.42 3.18	1.29 1.9	1.202 0.81	1.172 0	1.207 0	1.230 0.79
34+920		2.87 6.3	1.85 4.2	1.52 3.15	1.48 2.4	1.289 0.83	1.259 0	1.257 0	1.271 0.75
		4.88 10.3	4.67 15.2	1.46 3.26	1.42 2.3	1.209 0.90	1.191 0	1.191 0	1.205 0.81
T.P.		B.S.	π	F.S.					
		1.600	101.036	1.800					
34+935		2.80 6.3	1.91 4.6	1.46 3.26	1.42 2.3	1.209 0.90	1.191 0	1.191 0	1.205 0.81
		5.02 11.3	4.75 14.7	1.50 3.02	1.50 3.02	1.279 0.83	1.257 0	1.242 0	1.255 0.82
34+950		4.98 15.4	5.16 11.9	1.72 4.1	1.50 3.02	1.279 0.83	1.257 0	1.242 0	1.255 0.82

OHIO DEPARTMENT OF TRANSPORTATION

194SWH


PERSONNEL	TITLE	PERSONNEL	TITLE	COUNTY	WILLIAMS	DATE	Z-20-98
CANTERBURY				S.R.	U.S. #6	WEATHER	CLOUDY
ROUSOS				SEC.	33.618	TEMP.	+42° F
WATSON							

JOB NO. _____

RIGHT

CENTER LINE

LEFT

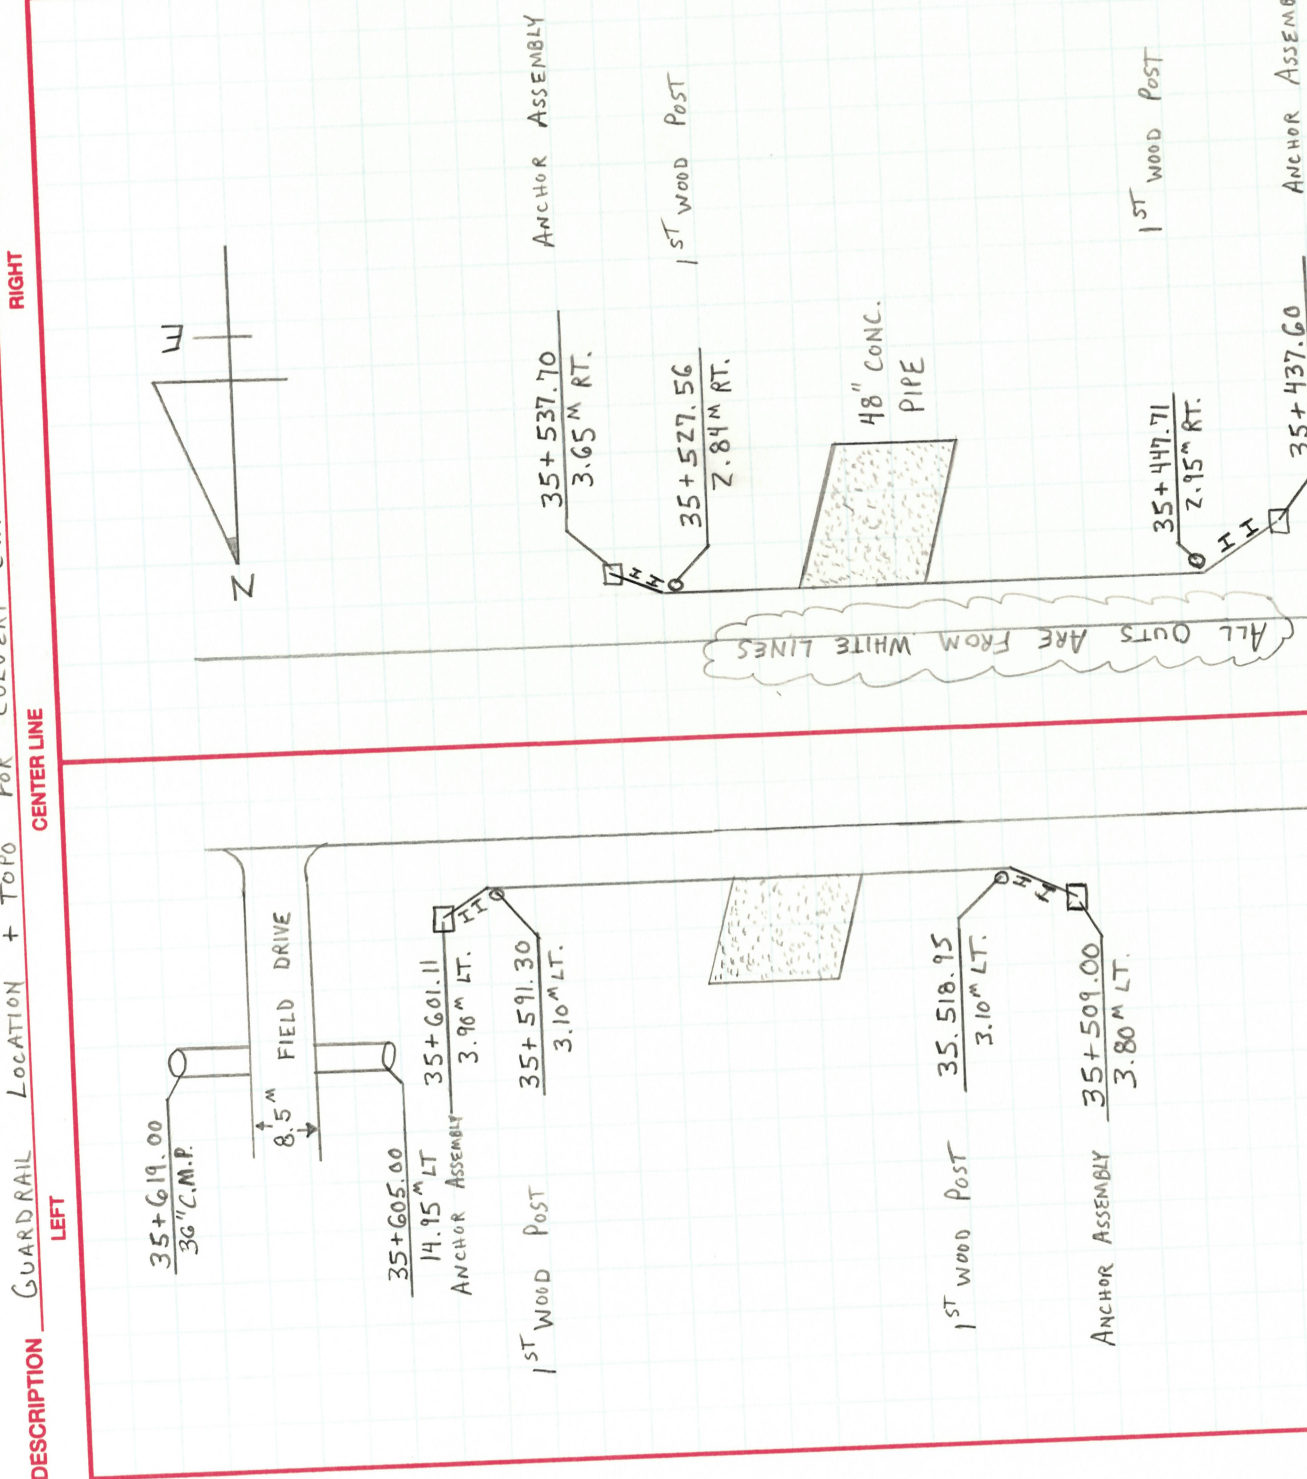

OHIO DEPARTMENT OF TRANSPORTATION

194SWH

PERSONNEL	TITLE	PERSONNEL	TITLE	COUNTY	WILLIAMS	DATE	2/23/98
CANTERBURY	π						
ROWSON	ϕ			S.R.	U.S. #6	WEATHER	PT. CLOUDY
WATSON	ϕ			SEC.	33.618 SLK	TEMP.	+45°F
						JOB NO.	

DESCRIPTION	GUARDRAIL	X-SECTIONS	FOR CULVERT	(WIL-G-ZZ07) ENGLISH	RIGHT

STA	LEFT	RIGHT	ELEV.	DESCRIPTION
35+375	B.S. 1.604	π 101.604	100.000	TOP NW BOLT OF G-RAIL ANCHOR ASSEMBLY STA 35+437.60, 3.15" RT OF E.O.P.
35+390				
35+405				
35+420				
35+435				
35+450				

OHIO DEPARTMENT OF TRANSPORTATION

1045WH

PERSONNEL TITLE PERSONNEL TITLE COUNTY WILLIAMS DATE 2/23/98
CANTERBURY T H S.A. U.S. # 6 WEATHER Pt. CLOUDY
ROUSOS W TEMP. +45° F
WATSON J
SEC. 33.618 SLK
JOB NO. _____

DESCRIPTION GUARDRAIL X-SECTIONS FOR CULVERT (WIL-G-ZZ07) ENGLISH
LEFT RIGHT
CENTER LINE

STA	B. S.	F. S.	ELEV.
35+480	1.96 15.0	2.12 7.5	1.470 0
35+495	2.07 17.0	2.26 12.3	1.513 0
35+510	3.26 12.6	2.99 5.9	1.536 0
35+525	4.42 13.4	3.63 9.9	1.572 0

T.P. 1.192
100.952
1.844
99.760
TOP N^{RY} BOLT OF G-RAL ANCHOR ASSEMBLY
STA 35+537.70, 3.65^M RT. E.O.P.

PERSONNEL	TITLE	PERSONNEL	TITLE	COUNTY	WILLIAMS	DATE	7/23/10
CANTERBURY	<u>TH</u>			S.R.	U.S. #6	WEATHER	P.T. CLOUDY
Rousos	<u>on</u>					TEMP.	+45° F
WATSON	<u>phi</u>			SEC.	33.618 SLK	JOB NO.	
					(WIL-6-2207) ENGLISH	RIGHT	

DESCRIPTION	GUARDRAIL	X-SECTIONS	FOR	CULVERT
	LEFT	CENTER LINE		


STA	B.S.	Σ	100.952	FACE OF GRAIL	BERM	WHITE LINE	ELEV.
35+570	3.49 19.7	4.05 14.8	1.61 5.4	1.18 2.20	0.913 1.010	0.884 0	
35+585	3.10 20.4	3.94 14.9	1.33 4.7	1.10 2.13	0.881 0.938	0.853 0	
35+600	2.87 20.0	3.86 14.3	1.52 5.6	1.17 3.89	0.849 0.862	0.825 0	
35+615	2.66 23.6	3.74 17.3	1.21 5.4	0.778 0	0.803 0.862		PROFILE OF FIELD DRIVE
35+630	3.18 18.7	3.78 14.4	1.30 4.7	0.750 0.918	0.722 0		
35+645	3.21 19.1	3.66 14.3	1.16 4.4	0.699 0.912	0.669 0		

OHIO DEPARTMENT OF TRANSPORTATION

194SWH

PERSONNEL	TITLE	PERSONNEL	TITLE	COUNTY	WILLIAMS	DATE	2/19/98
CANTERBURY	II						
RAUSOS	ON			S.R.	6	WEATHER	CLOUDY
WATSON	WHEEL					TEMP.	+40° F
				SEC.	33.618	SLK	
						JOB NO.	

DESCRIPTION LOCATION & DETAILS ABOUT CROSS HATCHING
 CENTER LINE PAVT S.R. #66-7

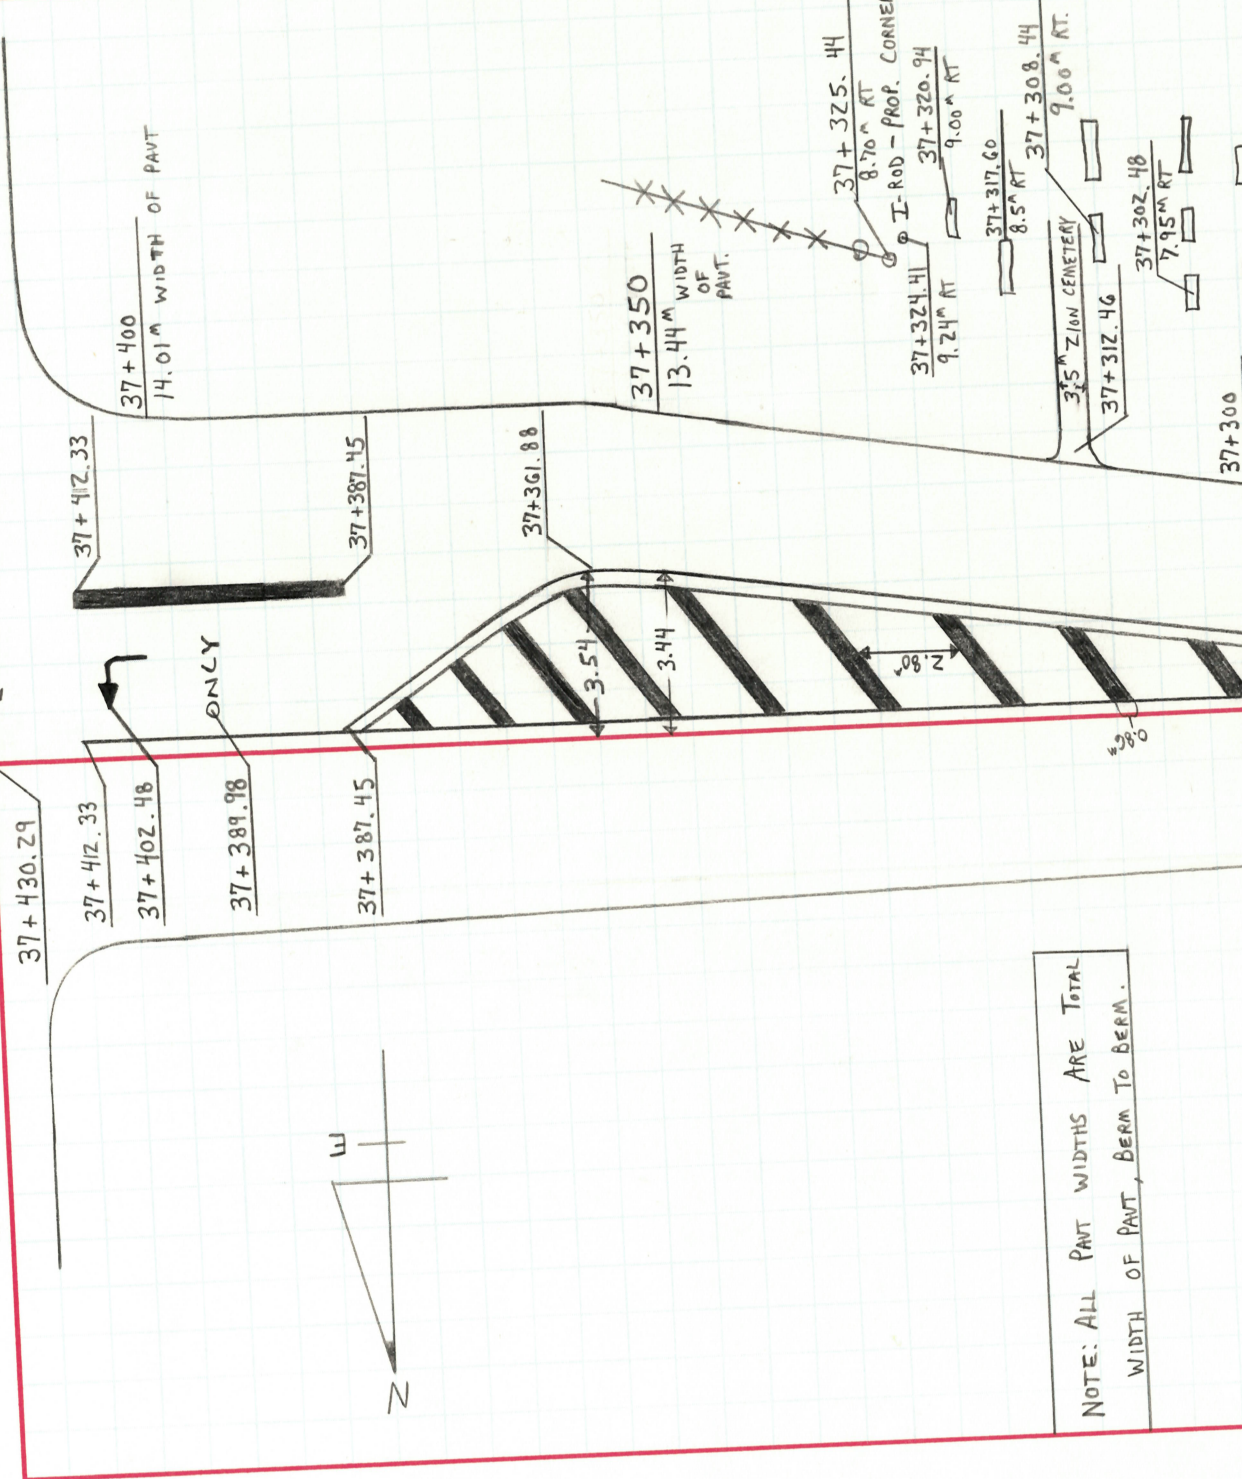

NOTE: ALL PAVT WIDTHS ARE TOTAL WIDTH OF PAVT, BERM TO BERM.


194SWH

OHIO DEPARTMENT OF TRANSPORTATION

SHEET NO. 16 OF 17


PERSONNEL CANTERBURY ROUSOS WATSON TITLE  on WHEEL PERSONNEL COUNTY WILLIAMS S.R. U.S. # 6 SEC. 33. 618 SLK DATE Z-19-98 WEATHER CLOUDY TEMP. +40° F JOB NO.

DESCRIPTION LOCATION & DETAILS ABOUT CROSS HATCHING CENTER LINE LEFT RIGHT

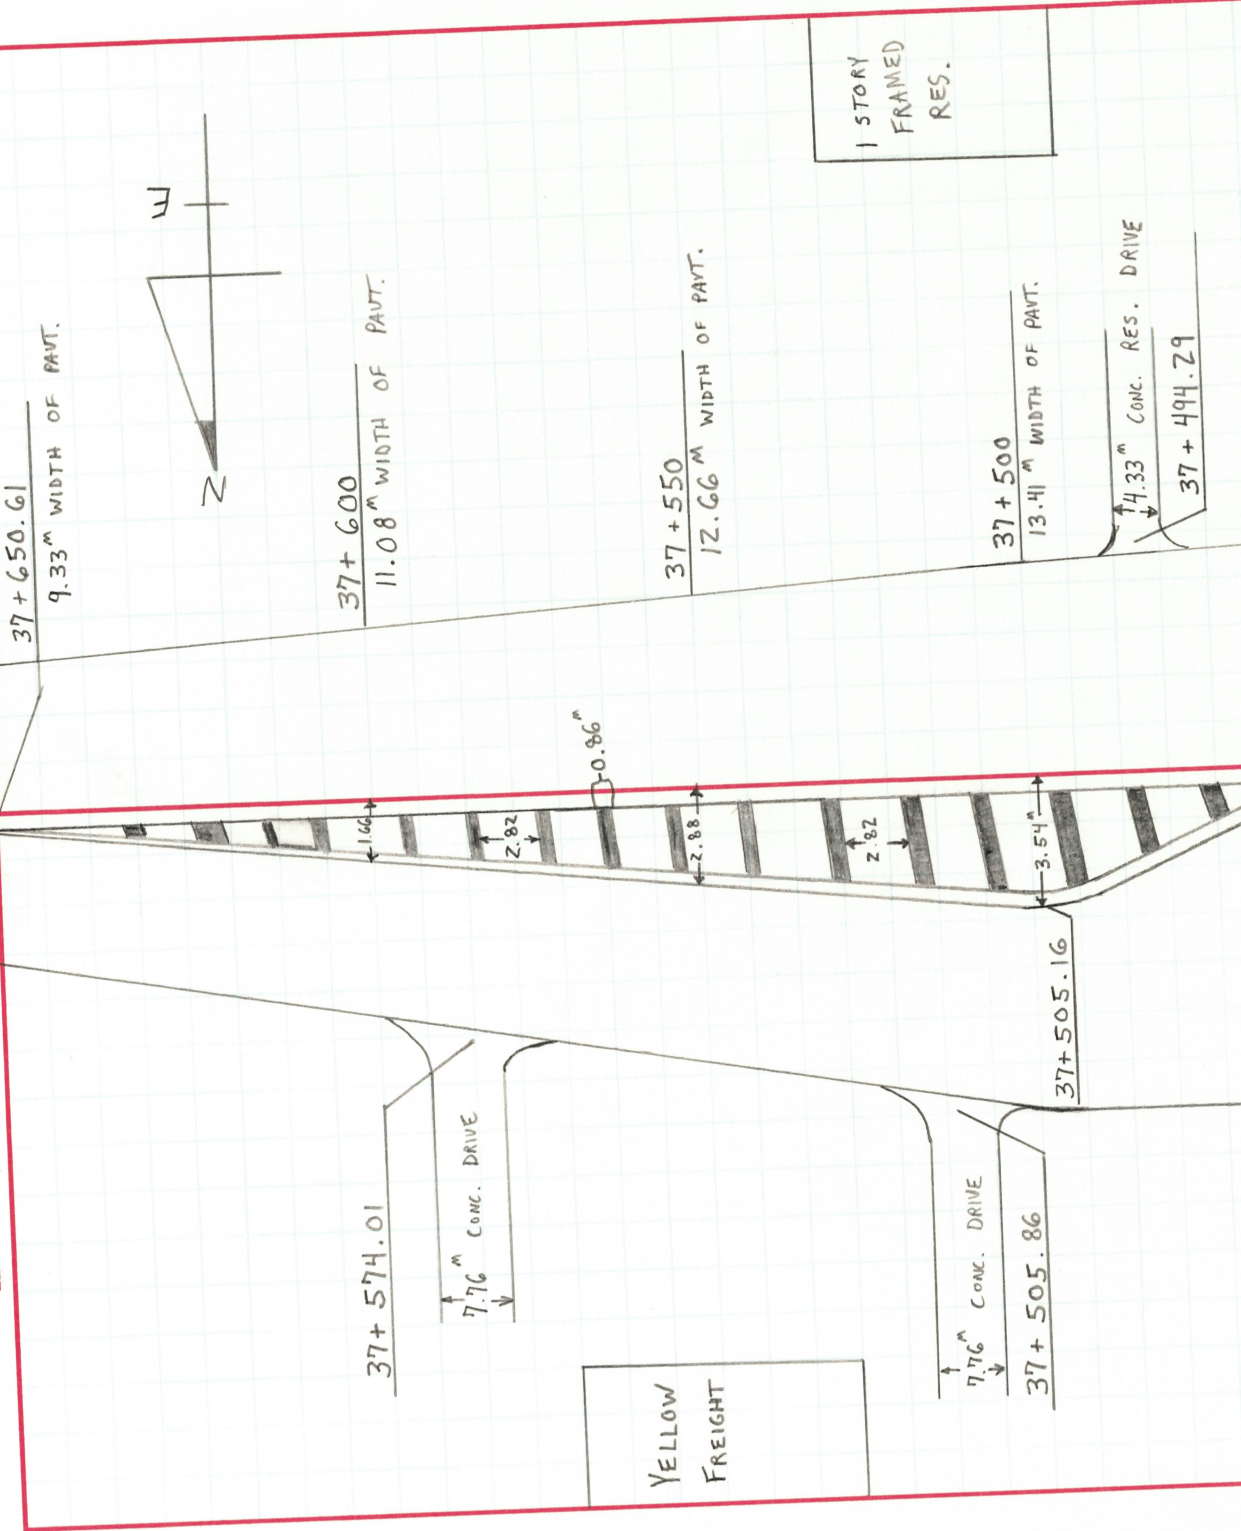

COUNTY Williams DATE 2/17/98
PERSONNEL Canterbury TITLE asst
Rousor TITLE PI
Watson TITLE φ
WEATHER CLOUDY / RAIN
TEMP. +40° F

DESCRIPTION Intersection pavement widths & X-SECS JOB NO. _____
LEFT CENTER LINE RIGHT

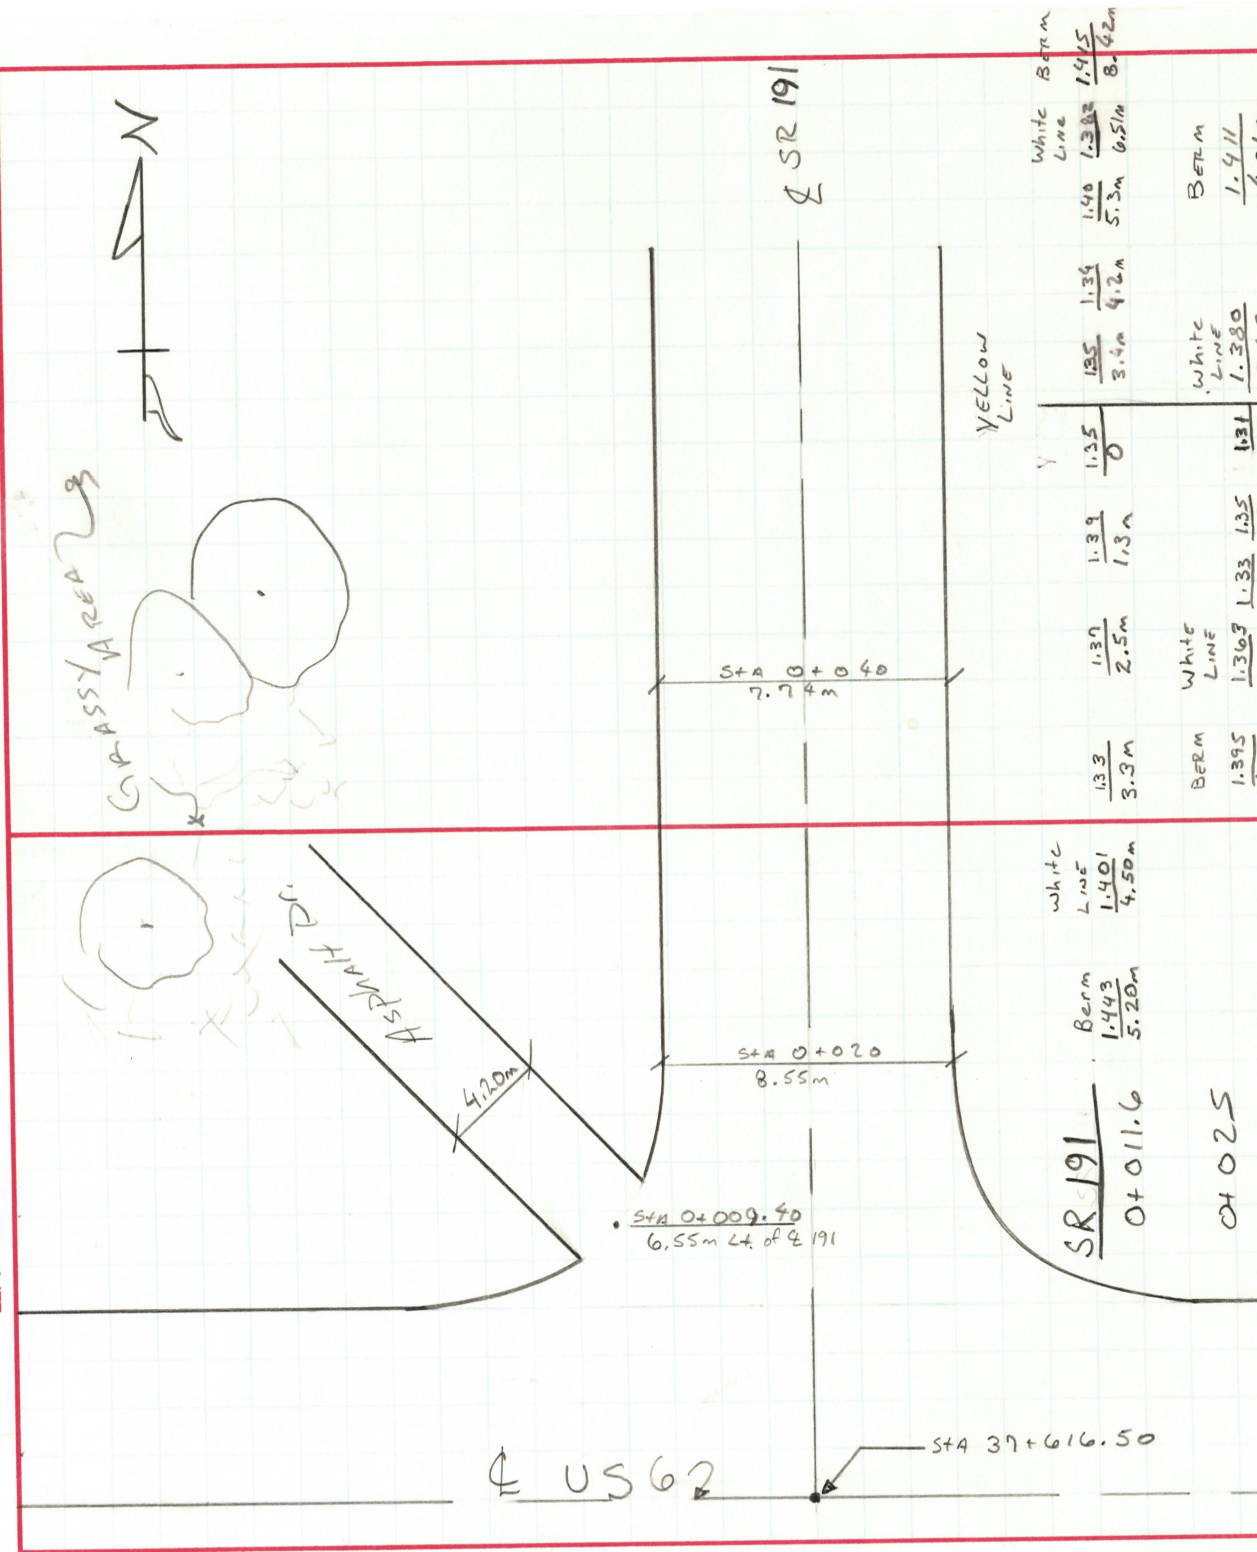

194SWH


OHIO DEPARTMENT OF TRANSPORTATION

SHEET NO.

PERSONNEL	TITLE	PERSONNEL	TITLE	COUNTY	WILLIAMS	DATE
				S. R.	6	
				SEC.	33.618	SUR
				TEMP.		
				WEATHER		

DESCRIPTION LOCATION & DETAILS ABOUT CROSS HATCHING


LEFT CENTER LINE RIGHT

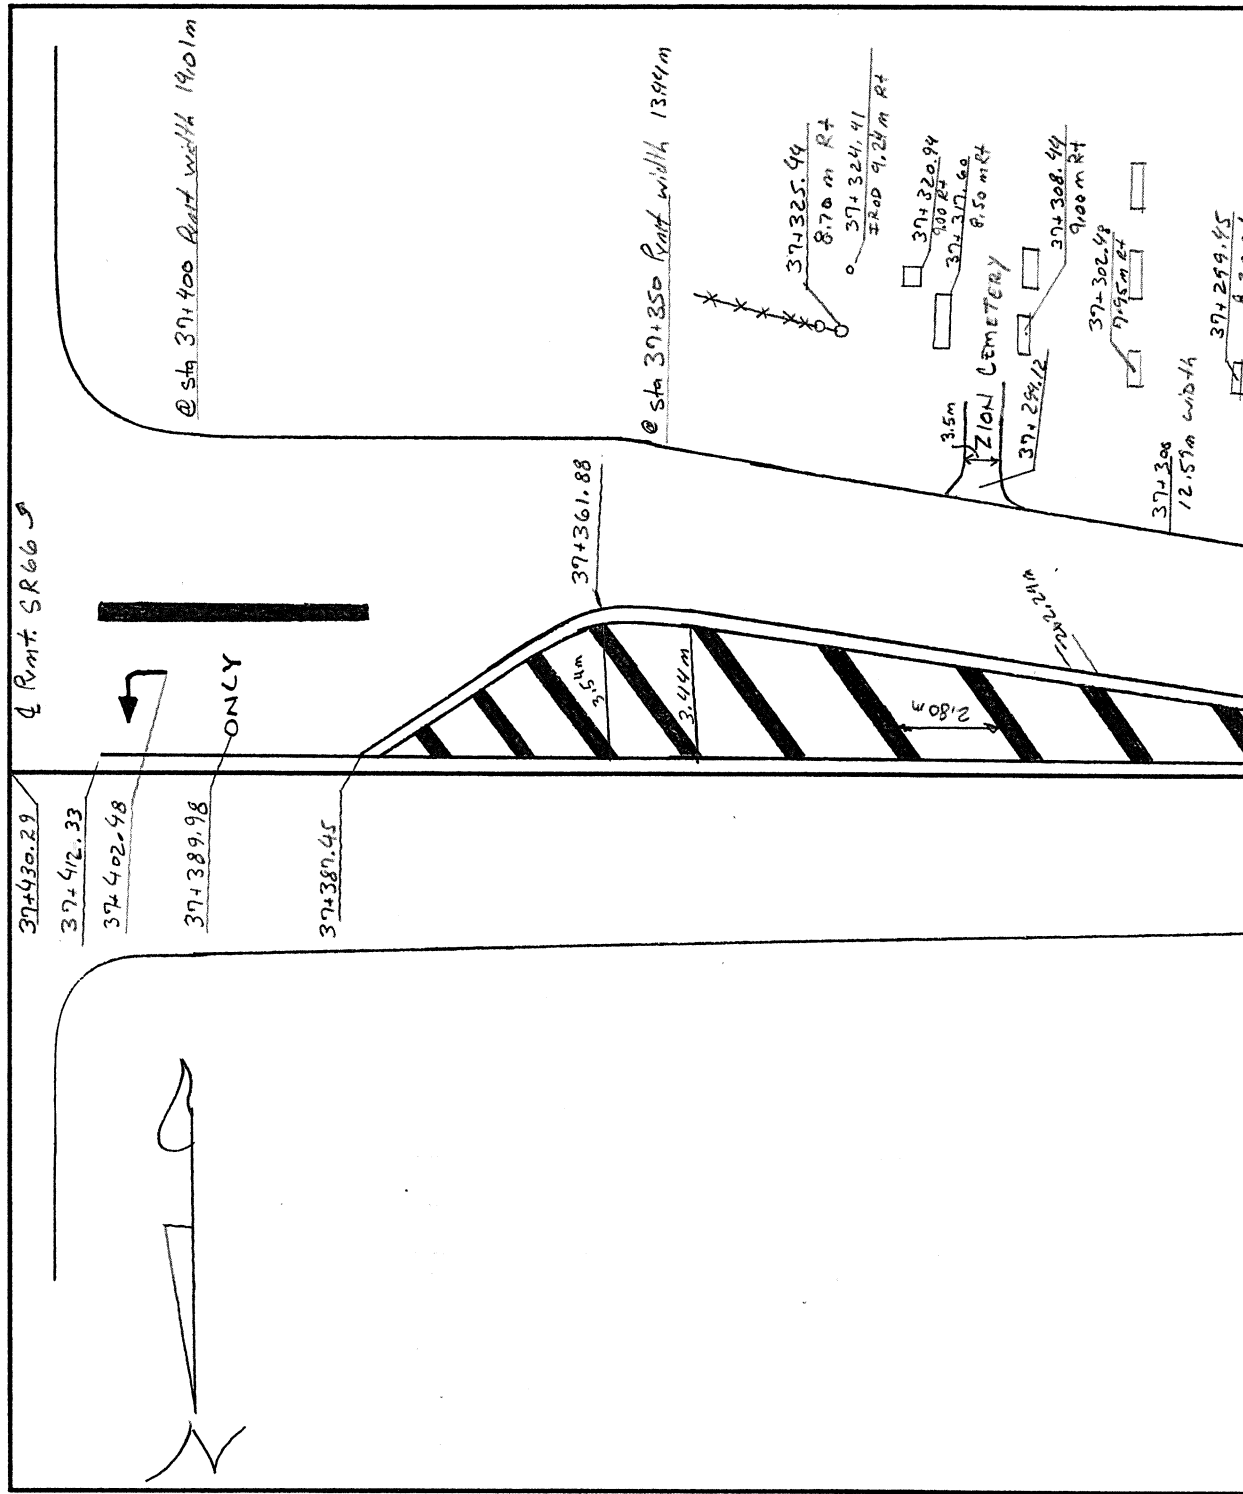

SHEET NO._____

PERSONNEL	TITLE	PERSONNEL	TITLE	COUNTY	DATE
				Williams	
				S. R. 6	WEATHER
				SEC. 33, 418	TEMP.

DESCRIPTION	DETAILS ABOUT CROSS HATCHING			JOB NO.
	LEFT	CENTER LINE	RIGHT	

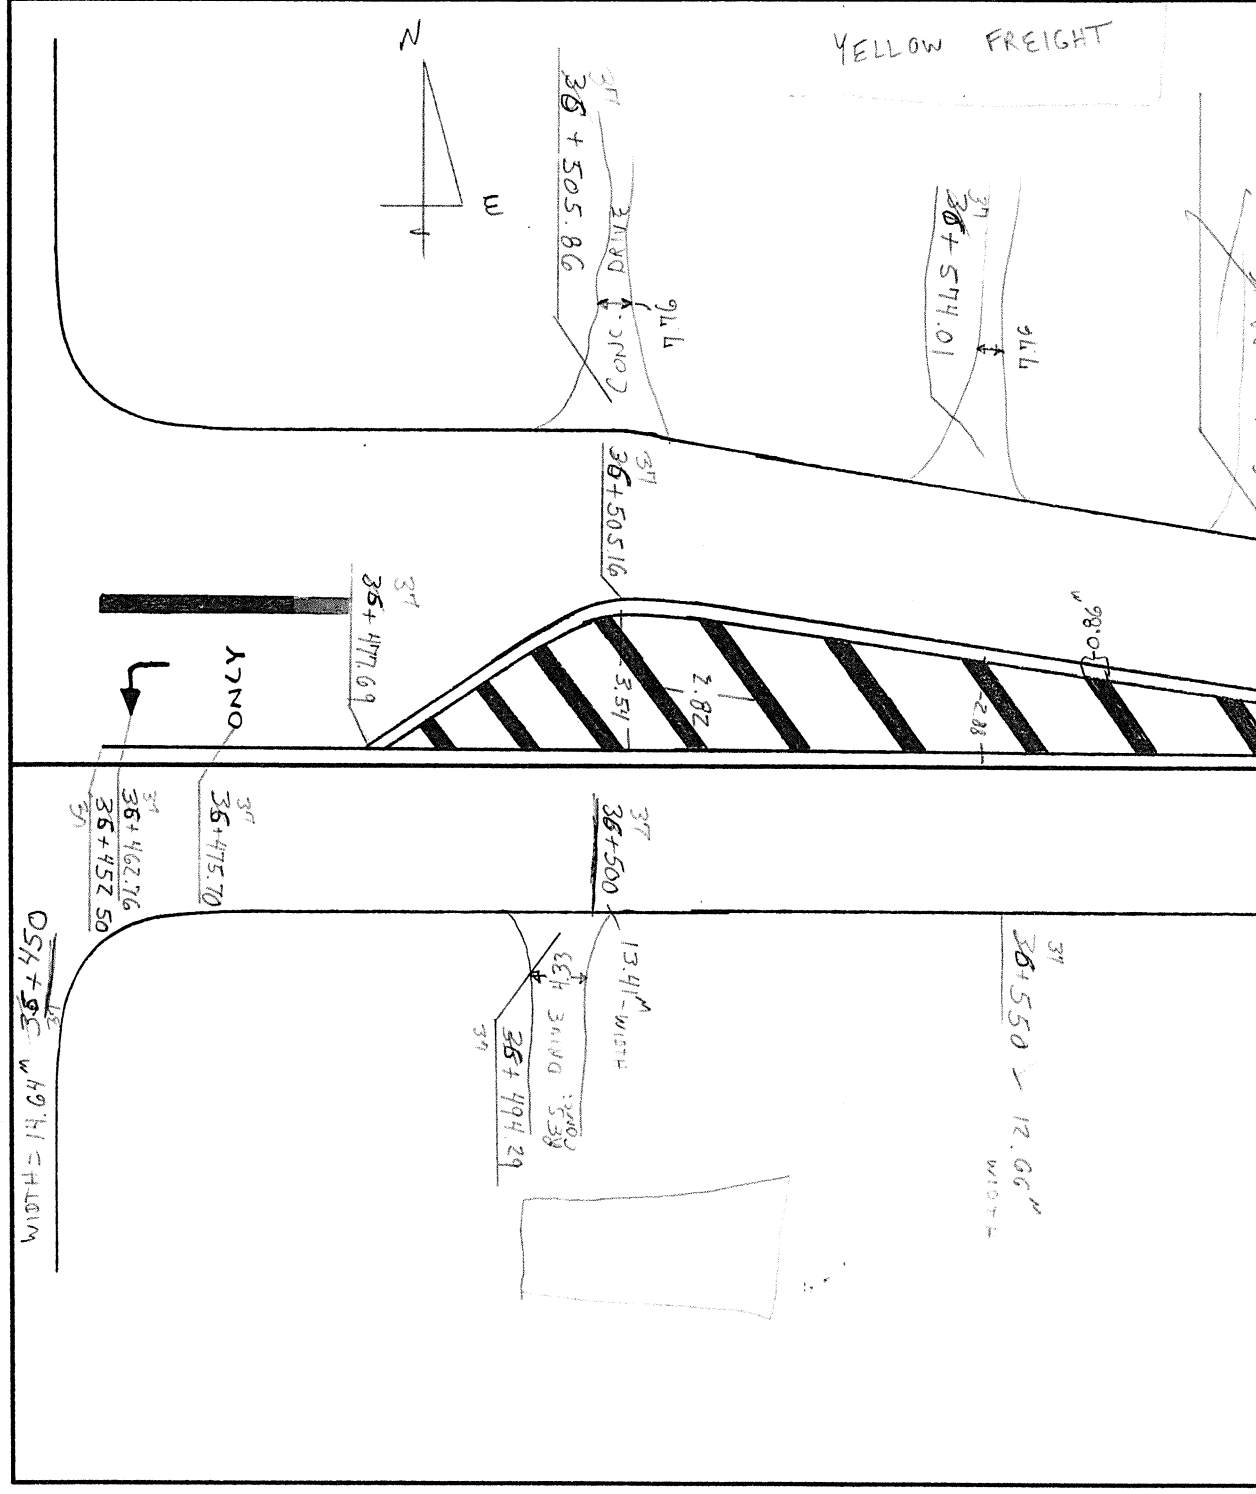


1943WH

OHIO DEPARTMENT OF TRANSPORTATION

SHEET NO.

PERSONNEL	TITLE	PERSONNEL	TITLE	COUNTY	DATE
				Williams	
				S. R.	6
				SEC.	33.618
				SUR	
				TEMP.	
				WEATHER	

DESCRIPTION	LOCATION	DETAILS	ABOUT	CROSS	HATCHING	JOB NO.

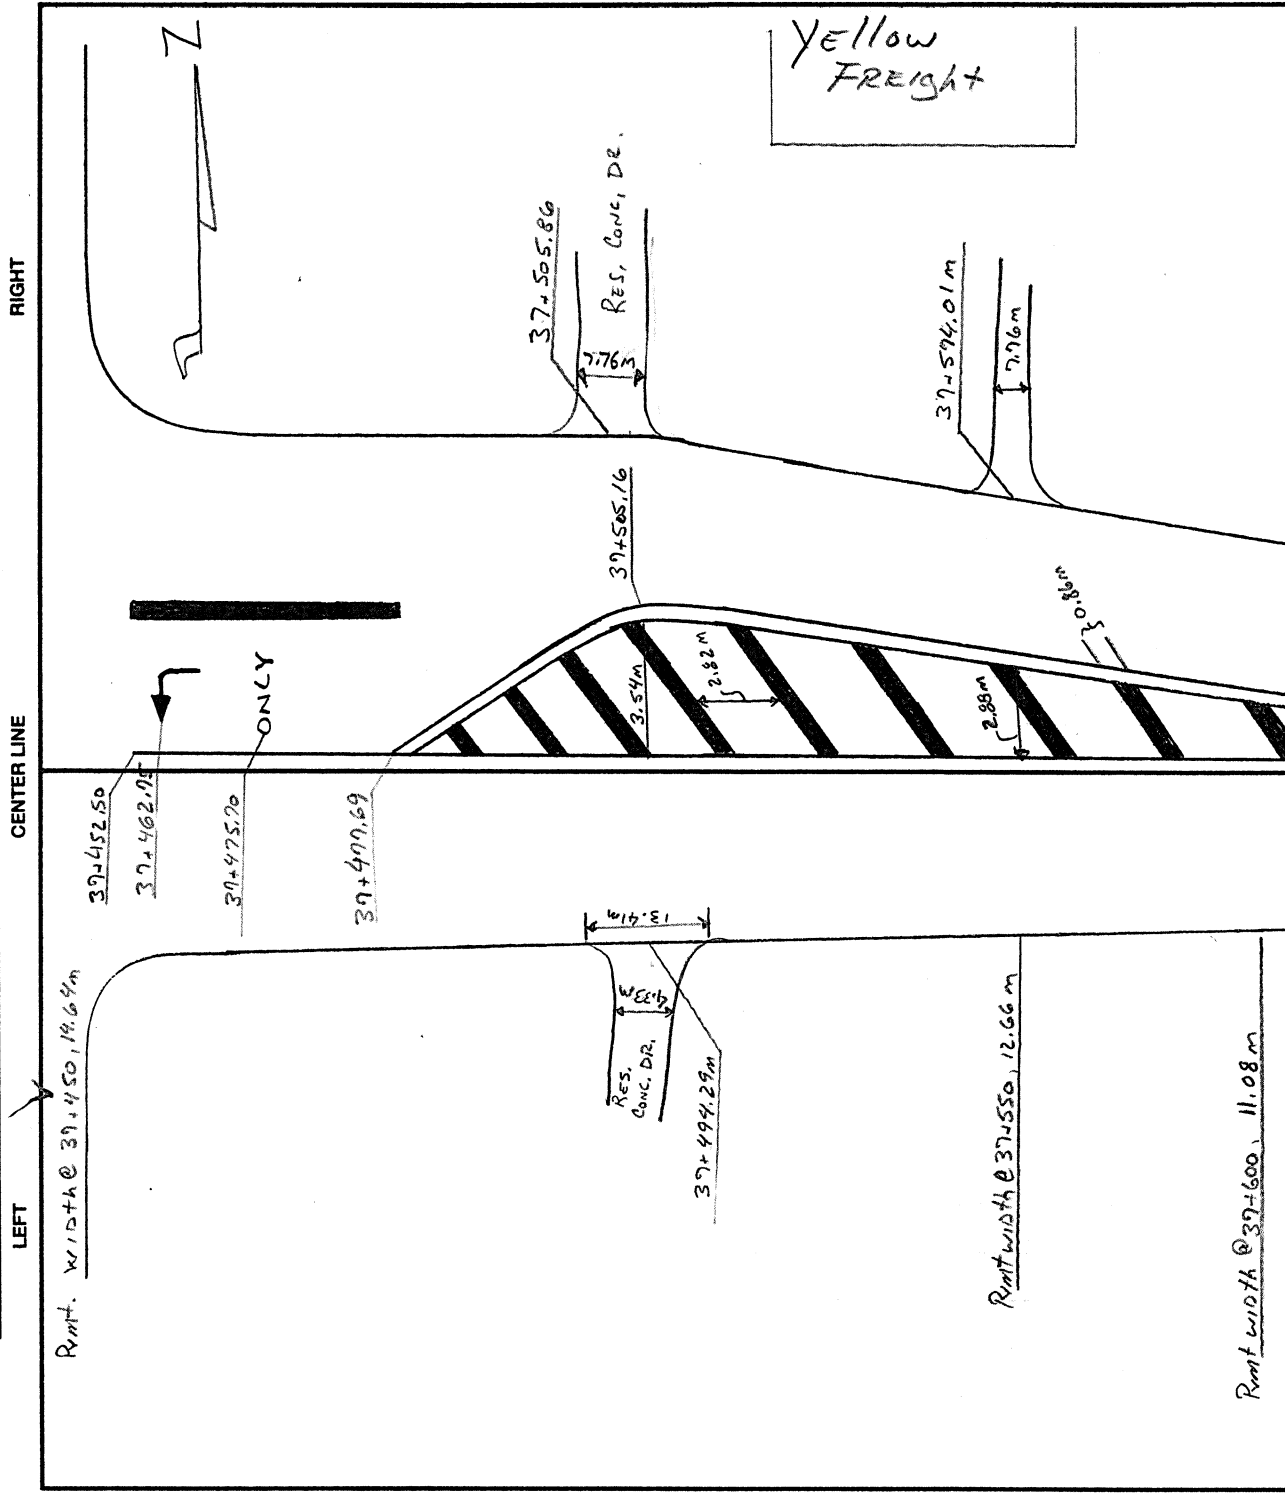

1945WH


OHIO DEPARTMENT OF TRANSPORTATION

SHEET NO.

PERSONNEL	TITLE	PERSONNEL	TITLE	COUNTY	WILLIAMS	DATE
				S. R.	6	WEATHER
				SEC.	33.618	TEMP.

DESCRIPTION LOCATION & DETAILS ABOUT CROSS HATCHING

LEFT CENTER LINE RIGHT

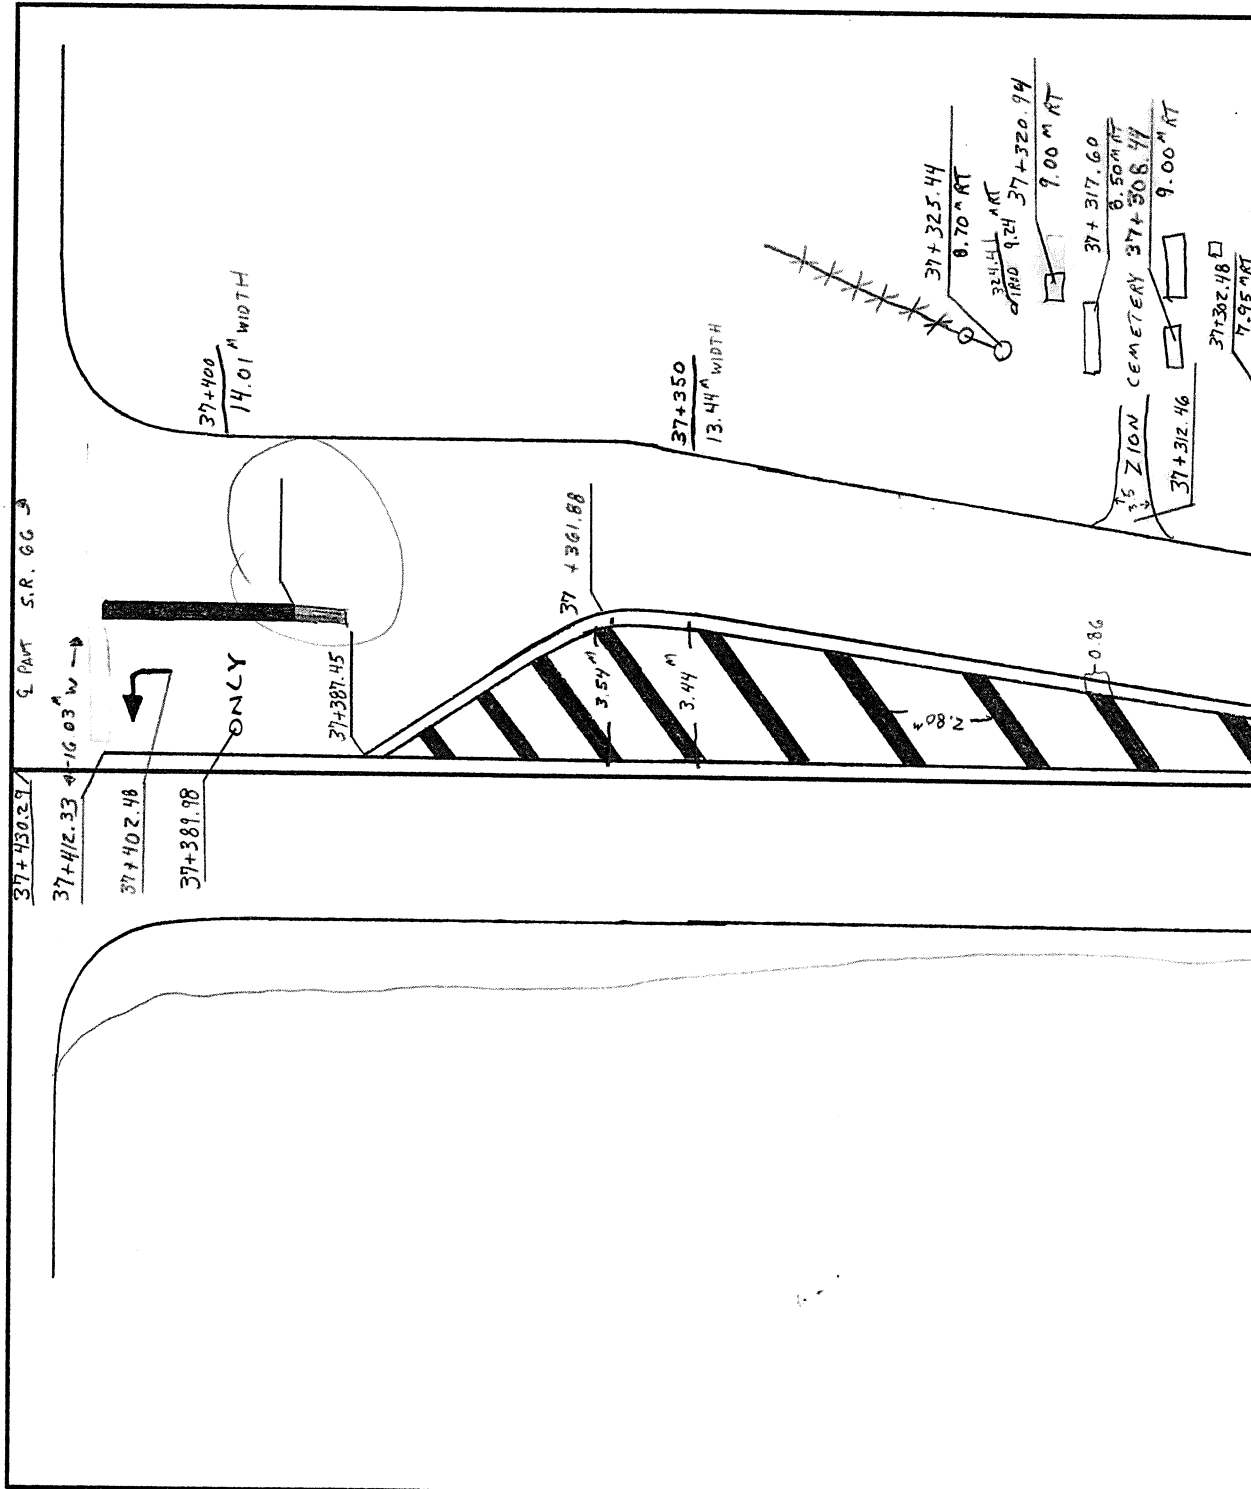

194SWH

OHIO DEPARTMENT OF TRANSPORTATION

SHEET NO.

PERSONNEL

TITLE

PERSONNEL

TITLE

COUNTY Williams DATE

S.R. 6 WEATHER

SEC. 33.618 SK TEMP.

DESCRIPTION LOCATION & DETAILS ABOUT CROSS HATCHING JOB NO.

LEFT

CENTER LINE

RIGHT

