


O.D.O.T. DISTRICT 2 SURVEY OFFICE (USE ONLY)


PERSONNEL _____ REFERENCE NO. 2 C SHEET 6 OF 34
 NOTES ASTON DATE 3-29-24 ROUTE SR 191
 H.C. RHOADES WEATHER SUNNY COUNTY WILLIAMS
 R.C. ASTON TEMP. 46° TOWNSHIP SPRINGFIEND
 SECTION 28
 DWG BY RHOADES PID PAVETRAIN T 6 N R 4 E

TYPE MONUMENT MAG/WASHER
 ON SURFACE - ~~BELOW~~ ON
 OFFSET CL PAVEMENT ON ~~RT~~ : RT
10.4' TO RT EDGE PAVEMENT
 STATION: 22+91

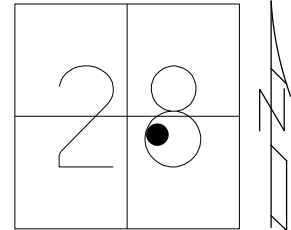

HORZ. DATUM: NAD83 2011 GEOID: NAVD88 2018
 GRID: NORTHING: 654774.446 EASTING: 1445899.873


RECORD:
 SET P.K.NAIL
 5/24/84, CL
 10/3/88, IS
 SET P.K.NAIL
 10/31/89, IS
 FD P.K.NAIL
 6/24/11, MC
 SET MAG/WASHER
 REFC2
 2/6/12, SAH
 FD MAG/WASHER
 REFC2, TDN
 2/2/23, JMR
 FD MAG/W
 3-29-24, JMR

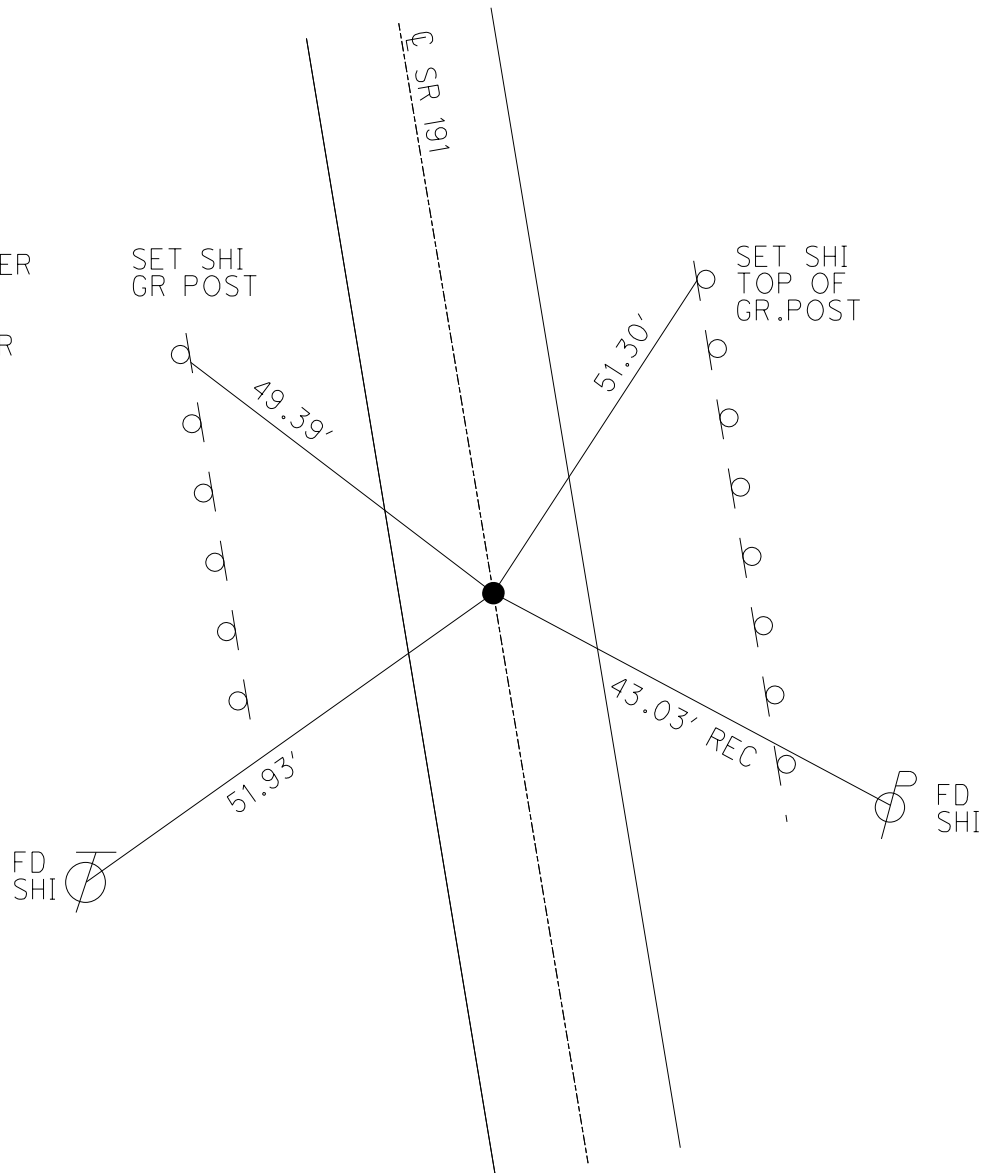

O.D.O.T. DISTRICT 2 SURVEY OFFICE (USE ONLY)


PERSONNEL _____ REFERENCE NO. 2 C SHEET 6 OF 34
 NOTES RHOADES DATE 6/22/22 ROUTE SR 191
 H.C. NIESE WEATHER SUNNY COUNTY WILLIAMS
 R.C. WHITAKER TEMP. 83° TOWNSHIP SPRINGFIEND
 DWG BY RHOADES PID PAVETRAIN SECTION 28
 T 6 N R 4 E

TYPE MONUMENT MAG/WASHER
 ON SURFACE - ~~BELOW~~ ON
 OFFSET Q PAVEMENT ON ~~LT~~ : RT
10.4' TO RT EDGE PAVEMENT
 STATION: 22+91

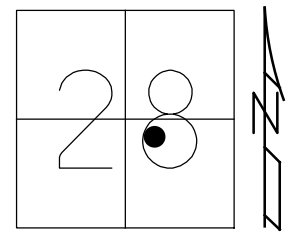

HORIZ.DATUM: NAD83 2011 GEOID: NAVD88 2018
 GRID: NORTHING: 654774.446 EASTING: 1445899.873


RECORD:
 SET P.K.NAIL
 5/24/84, CL
 10/3/88, IS
 SET P.K.NAIL
 10/31/89, IS
 FD P.K.NAIL
 6/24/11, MC
 SET MAG/WASHER
 REFC2
 2/6/12, SAH
 FD MAG/WASHER
 REFC2, TDN
 2/2/23, JMR

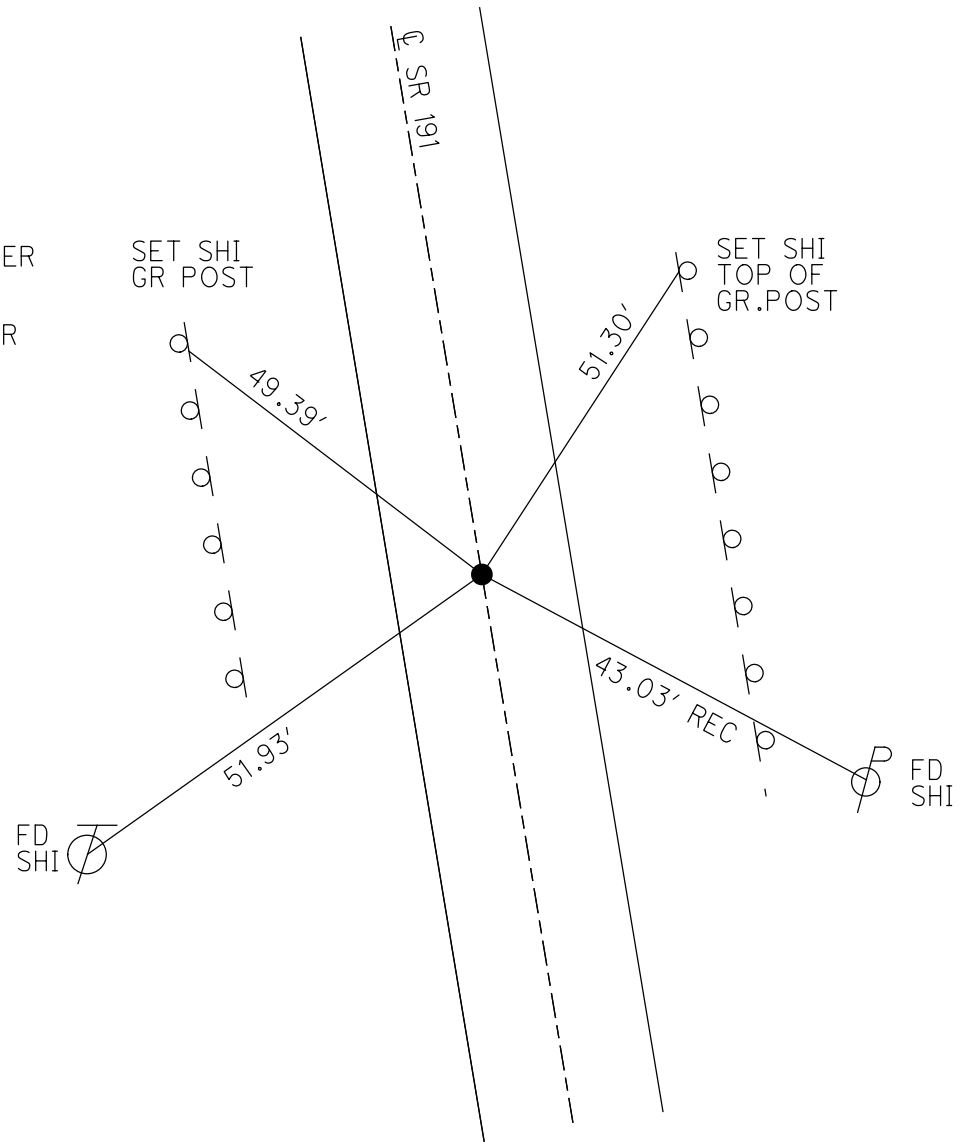

O.D.O.T. DISTRICT 2 SURVEY OFFICE (USE ONLY)


PERSONNEL _____ REFERENCE NO. 2 C SHEET 6 OF 34
 NOTES HUSS DATE 6/24/11 ROUTE SR 191
 H.C. HUSS WEATHER RAIN COUNTY WILLIAMS
 R.C. CANTERBURY TEMP. 70° TOWNSHIP SPRINGFIELD
 _____ SECTION 28
 _____ T 6 N R 4 E

TYPE MONUMENT P.K.NAIL
 ON SURFACE - ~~BELOW~~ ON _____
 LEFT - ☉ PAV'T - RIGHT ON _____
10.4' TORT EDGE PAVEMENT
 S.L.M. 22+91

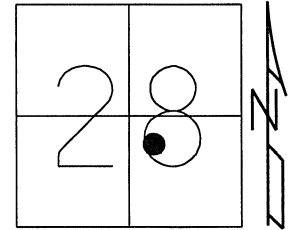

GRID: NORTHING: 654774.428 EASTING: 1445899.822

RECORD:
 SET P.K.NAIL
 FR/RECORD SURVEY
 5/24/84, CL
 10/3/88, IS
 SET P.K.NAIL
 10/31/89, IS
 FD P.K.NAIL
 6/24/11, MC
 SET MAG/WASHER
 GPS, FC2
 2/6/12, SAH

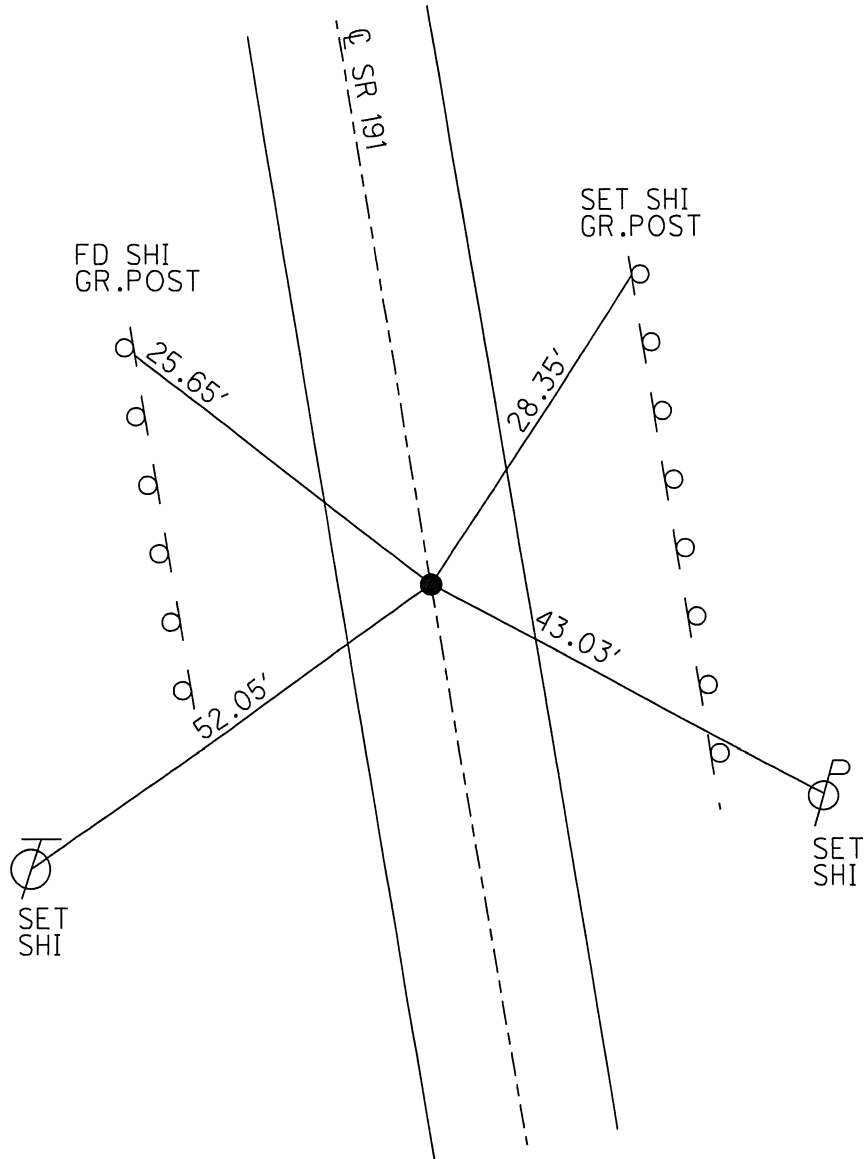

O.D.O.T. DISTRICT 2 SURVEY OFFICE

PERSONNEL

REFERENCE NO. 2-C

SHEET 4 OF

NOTES 1. Stone

H.C. D. Curtis

R.C. J. Householder

DATE 3 Oct. 88

WEATHER Fair

TEMP. 62°

ROUTE SR#191

COUNTY Williams

TOWNSHIP Springfield

SECTION 28

T R



TYPE MONUMENT PK Nail

ON SURFACE - BELOW Surface

LEFT - & PAV'T. - RIGHT

 TO EDGE PAVEMENT

S.L.M. 22 + 91

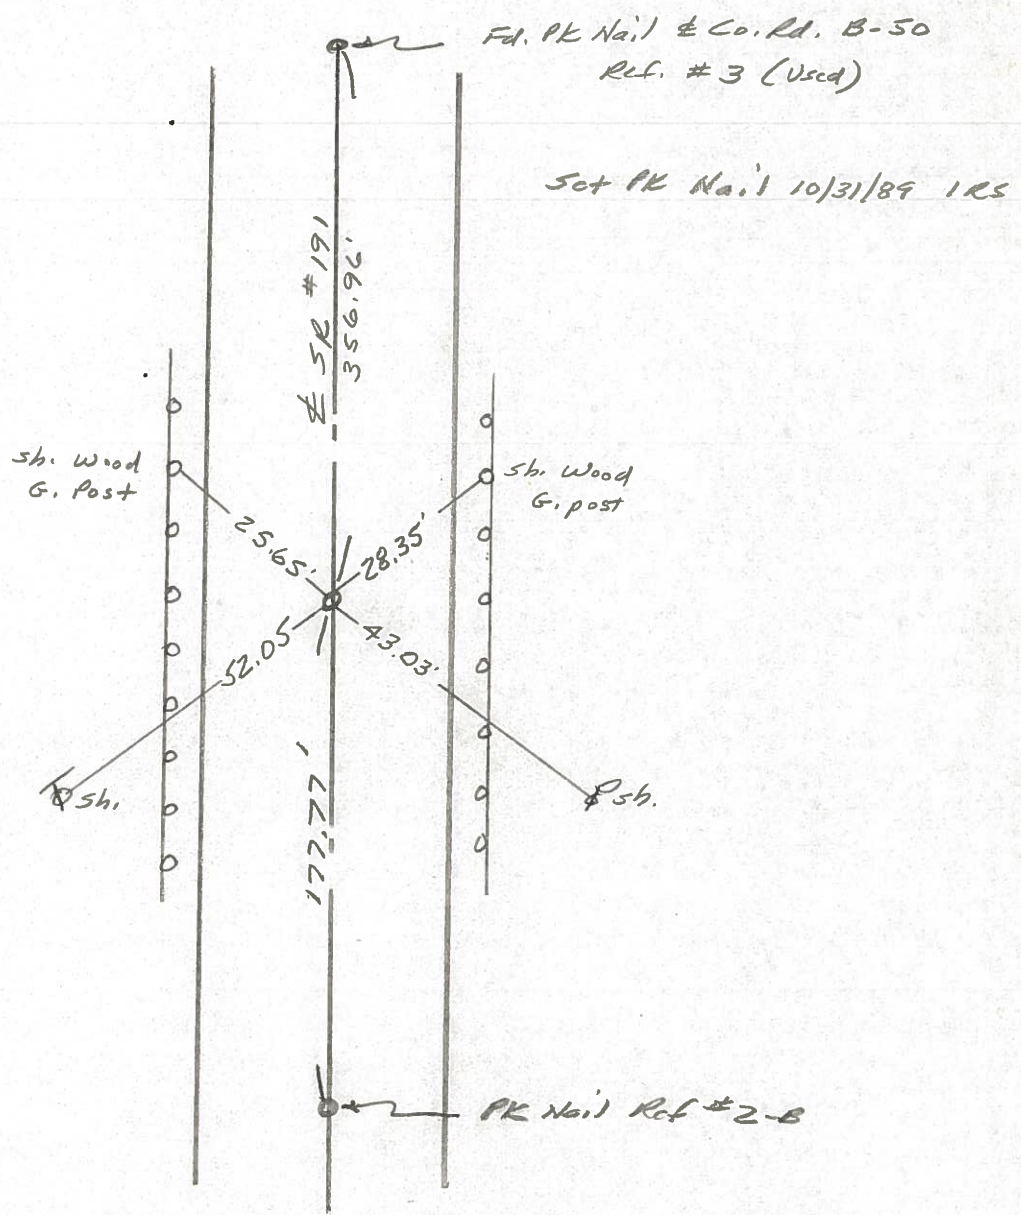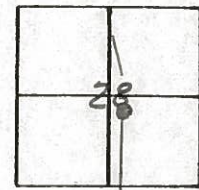

ODOT. DISTRICT 2 SURVEY OFFICE

County Williams S.R. 191

Date 5-24-84

Township SPRINGFIELD

Weather CLEAR

Section 28

Temp. 60°


T6N, R4E

Personnel HOFFMAN

LOSHRKE H.R.


HOUSEHOLDER R.C.

R-C

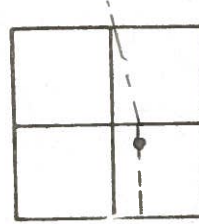

Set P.K. FROM RECORD SURVEYS
0.7' RT. of & PAUT SR191

SLM 22+89.09

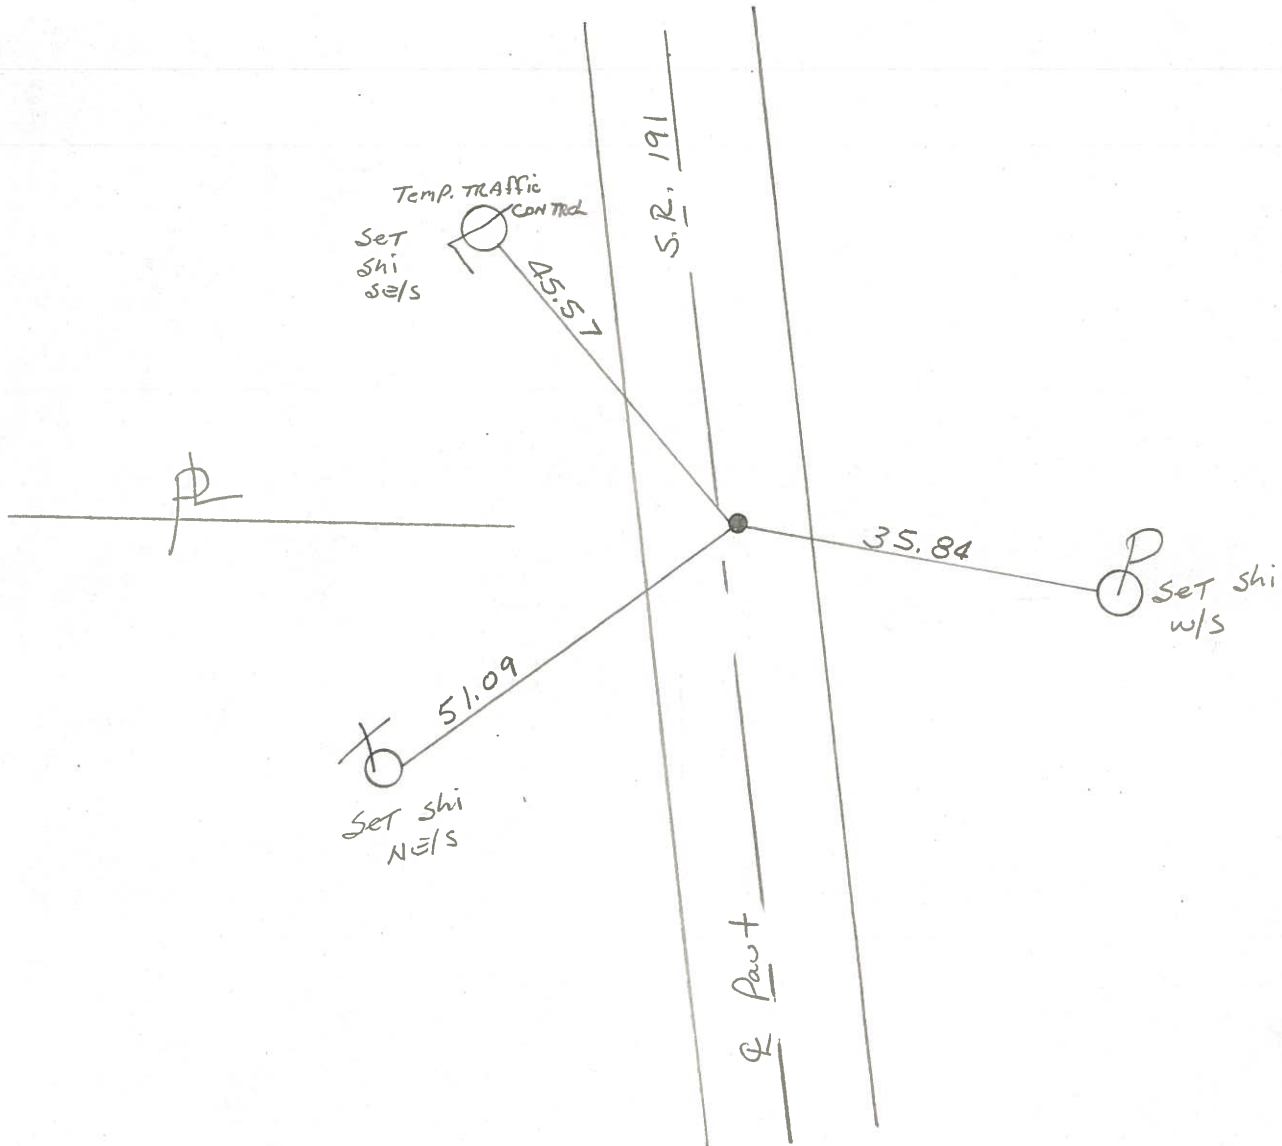

County Williams S.R. 191

Date 5-24-84

Township SPRINGFIELD


Weather CLEAR

Section 28

Temp. 60°

T6N, R4E

Personnel HOFFMAN
LOHRKE H.C.
HOUSEHOLDER R.C.

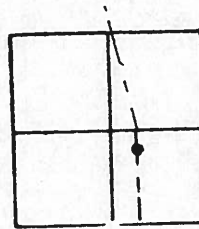

Set P.K. FROM RECORD SURVEYS
 0.7' RT. of & PAUT SR191

SLM 22+89.09

