

O.D.O.T. DISTRICT 2 SURVEY OFFICE (USE ONLY)

PERSONNEL

REFERENCE NO. 3

SHEET 7 OF 34

NOTES ASTON DATE 3-29-24

H.C. RHOADES WEATHER SUNNY

R.C. ASTON TEMP. 46°

ROUTE SR 191

COUNTY WILLIAMS

TOWNSHIP SPRINGFIEND

SECTION 28

DWG BY RHOADES PID PAVETRAIN

T 6 N R 4 E

TYPE MONUMENT MAG/WASHER

ON SURFACE - ~~BELOW~~ ON

OFFSET \odot PAVEMENT 0.3' LT : ~~RT~~

- TO - EDGE PAVEMENT



STATION: 26+48

HORZ.DATUM: NAD83 2011

GEOID: NAVD88 2018

GRID: NORTHING: 655127.802

EASTING: 1445849.955

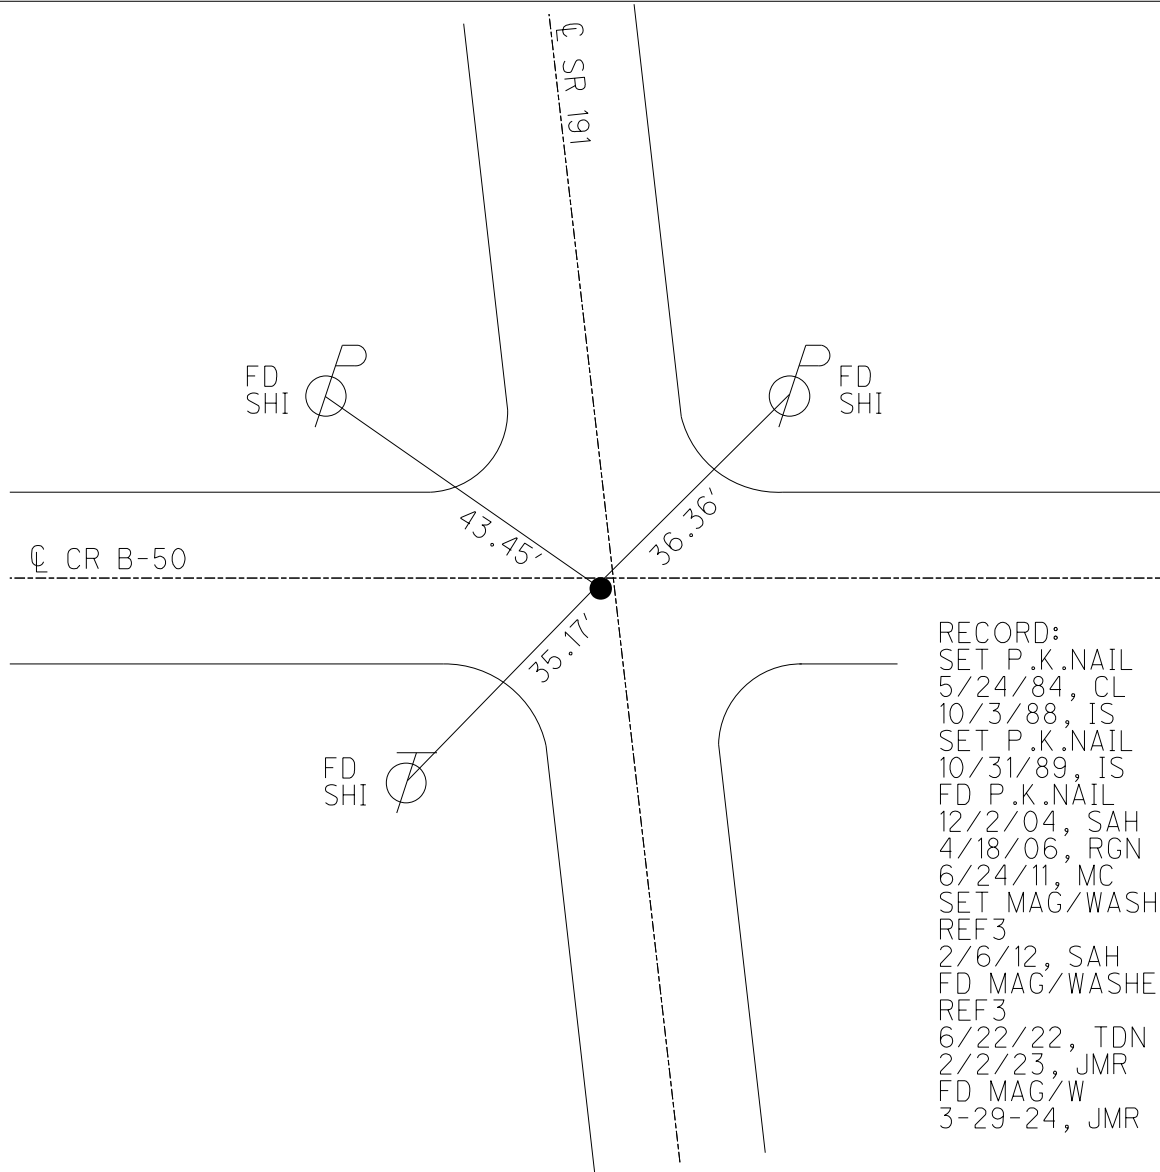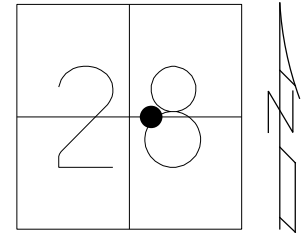

RECORD:
SET P.K.NAIL
5/24/84, CL
10/3/88, IS
SET P.K.NAIL
10/31/89, IS
FD P.K.NAIL
12/2/04, SAH
4/18/06, RGN
6/24/11, MC
SET MAG/WASHER
REF3
2/6/12, SAH
FD MAG/WASHER
REF3
6/22/22, TDN
2/2/23, JMR
FD MAG/W
3-29-24, JMR

O.D.O.T. DISTRICT 2 SURVEY OFFICE (USE ONLY)

PERSONNEL

REFERENCE NO. 3

SHEET 7 OF 34

NOTES RHOADES

DATE 6/22/22

ROUTE SR 191

H.C. NIESE

WEATHER SUNNY

COUNTY WILLIAMS

R.C. WHITAKER

TEMP. 83°

TOWNSHIP SPRINGFIEND

SECTION 28

DWG BY RHOADES

PID PAVETRAIN

T 6 N R 4 E

TYPE MONUMENT MAG/WASHER

ON SURFACE - ~~BELOW~~ ON

OFFSET 0.3' LT : ~~RT~~

- TO - EDGE PAVEMENT



STATION: 26+48

HORZ.DATUM: NAD83 2011

GEOID: NAVD88 2018

GRID: NORTHING: 655127.802

EASTING: 1445849.955

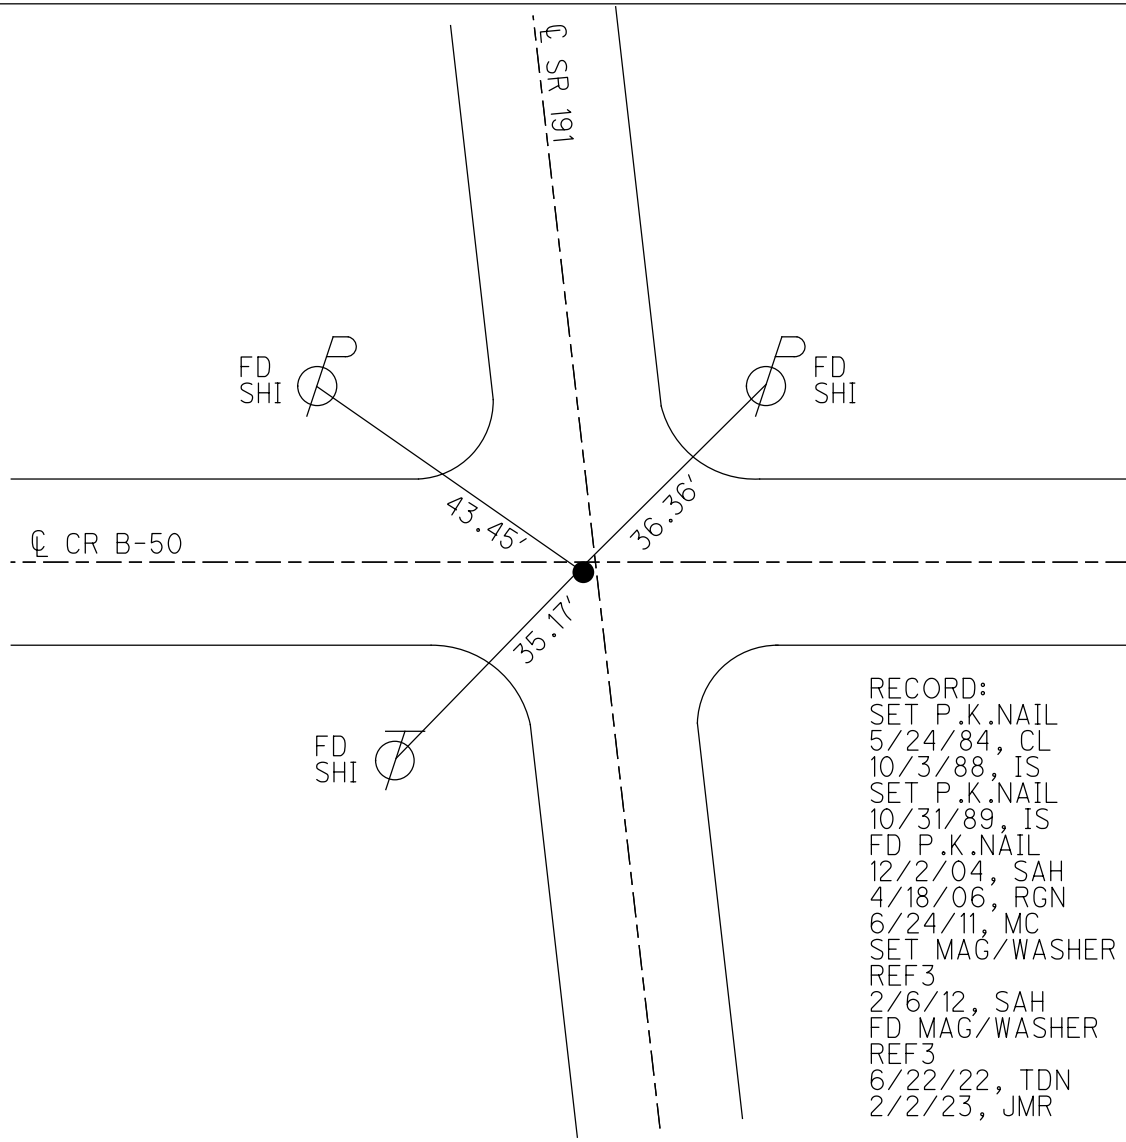
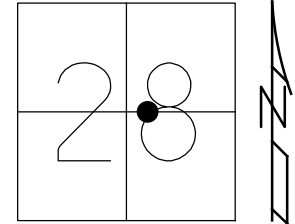


RECORD:
 SET P.K.NAIL
 5/24/84, CL
 10/3/88, IS
 SET P.K.NAIL
 10/31/89, IS
 FD P.K.NAIL
 12/2/04, SAH
 4/18/06, RGN
 6/24/11, MC
 SET MAG/WASHER
 REF3
 2/6/12, SAH
 FD MAG/WASHER
 REF3
 6/22/22, TDN
 2/2/23, JMR

O.D.O.T. DISTRICT 2 SURVEY OFFICE (USE ONLY)

PERSONNEL _____ REFERENCE NO. 3 SHEET 7 OF 34
 NOTES HUSS DATE 6/24/11 ROUTE SR 191
 H.C. HUSS WEATHER CLOUDY COUNTY WILLIAMS
 R.C. CANTERBURY TEMP. 68° TOWNSHIP SPRINGFIELD
 _____ SECTION 28
 _____ T 6 N R 4 E

TYPE MONUMENT P.K.NAIL
 ON SURFACE - ~~BELOW~~ ON _____
 LEFT - ☉ PAV'T - ~~RIGHT~~ 0.3', 1' S. OF ☉ B-50
 - TO - EDGE PAVEMENT
 S.L.M. 26+48
 GRID: NORTHING: 655127.807 EASTING: 1445849.910

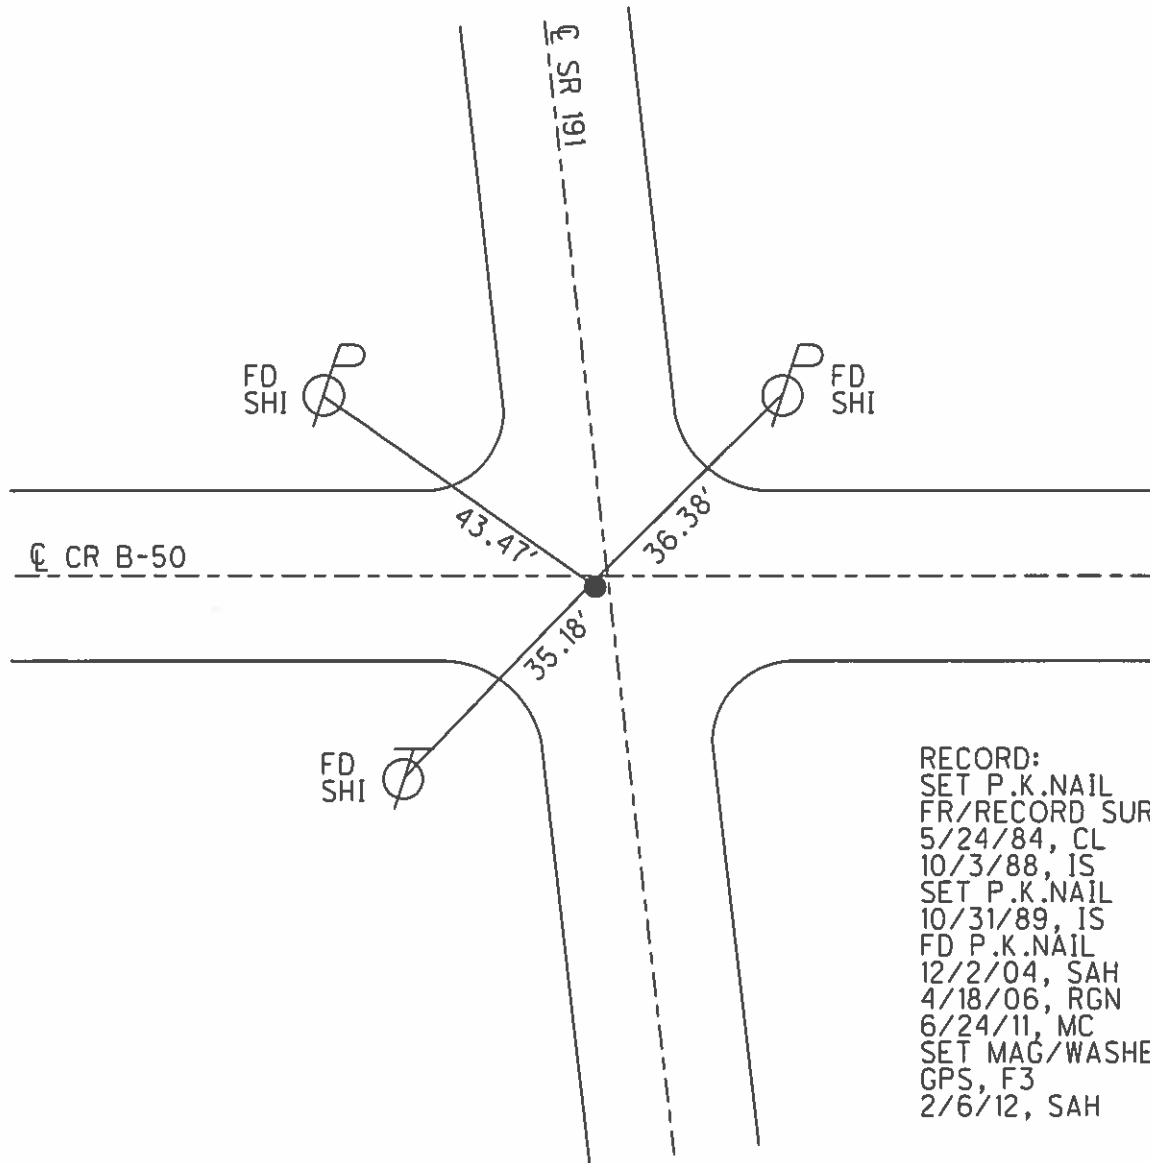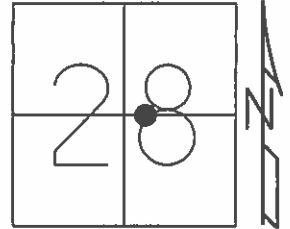

RECORD:
 SET P.K.NAIL
 FR/RECORD SURVEY
 5/24/84, CL
 10/3/88, IS
 SET P.K.NAIL
 10/31/89, IS
 FD P.K.NAIL
 12/2/04, SAH
 4/18/06, RGN
 6/24/11, MC
 SET MAG/WASHER
 GPS, F3
 2/6/12, SAH

O.D.O.T. DISTRICT 2 SURVEY OFFICE

PERSONNEL

REFERENCE NO. 3

SHEET 5 OF

NOTES L. Stone

H.C. D. Curtis

R.C. J. Housholder

DATE 3 Oct. 88

WEATHER Coal

TEMP. 63°

ROUTE SR#191

COUNTY Williams

TOWNSHIP Springfield

SECTION 28

T R


TYPE MONUMENT PK Nail

ON SURFACE - BELOW Surface


LEFT - \odot PAV'T. - RIGHT

 TO EDGE PAVEMENT

S.L.M. 26+78

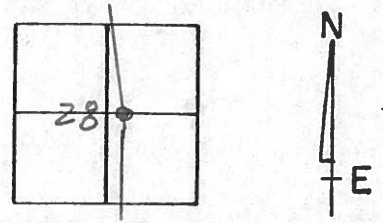

Set PK Nail 10/31/89 IRS

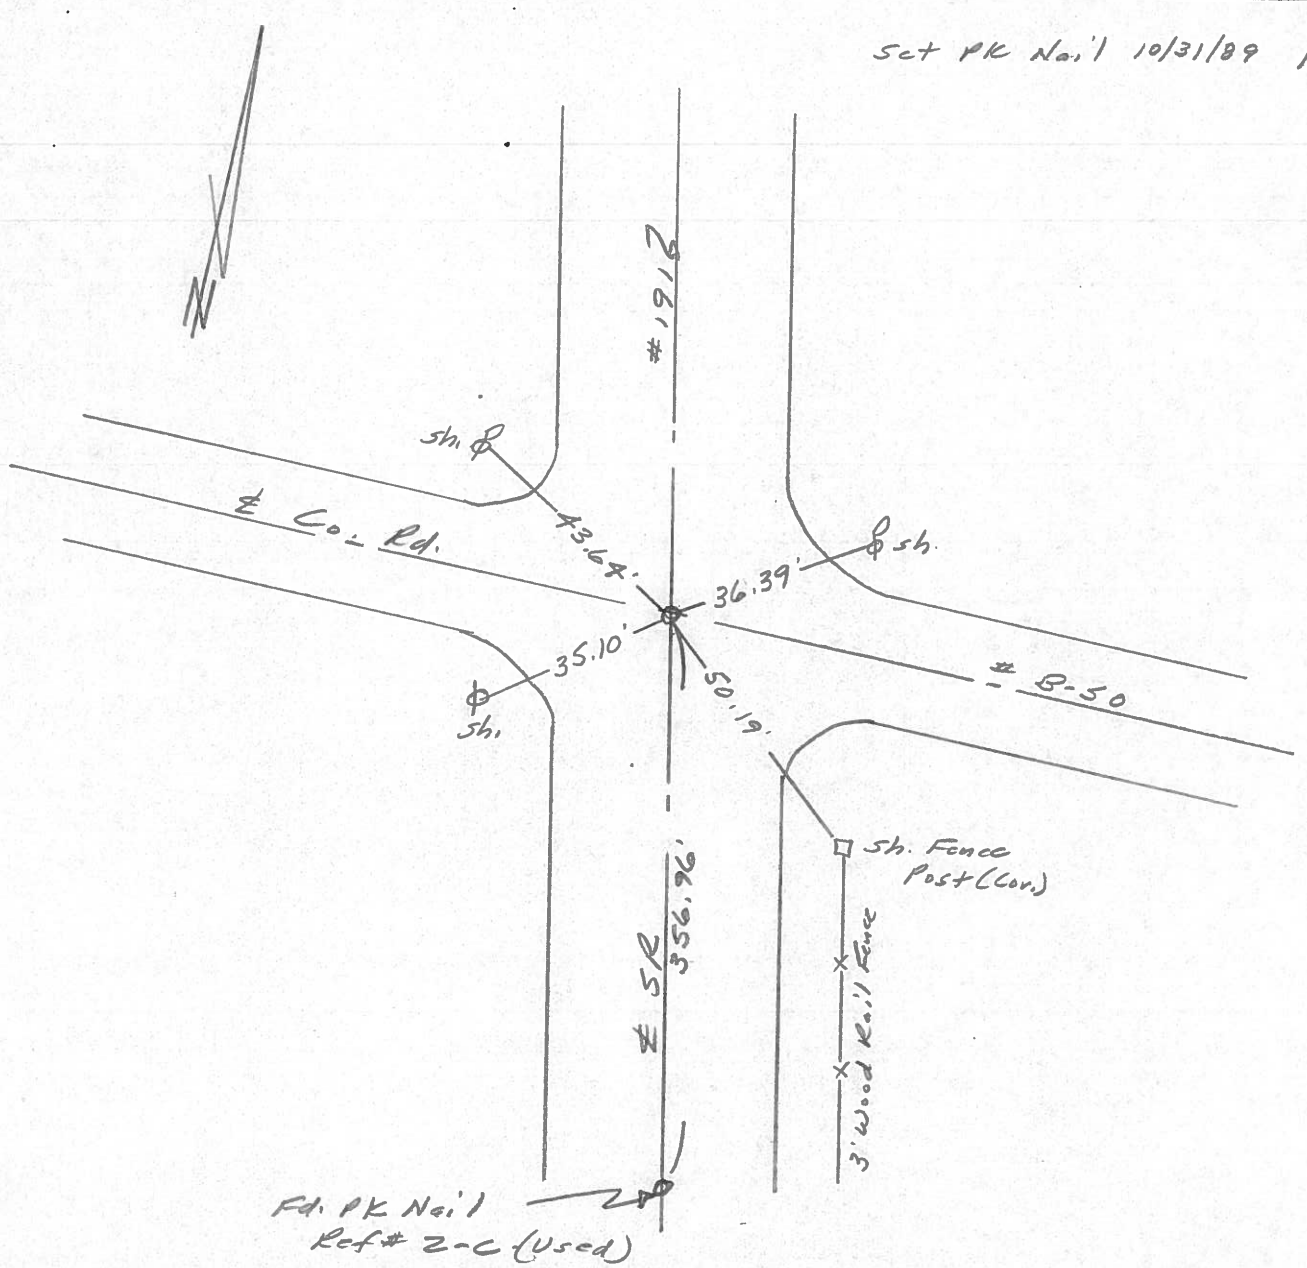

County Williams S.R. 191

Township SPRINGFIELD

Section 28

T6N, R4E

Personnel Hoffman

LOSHRKE H.C.


HOUSEHOLDER R.C.

3

Date 5-24-84

Weather Clear

Temp. 60°

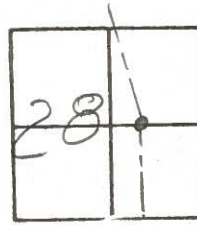


Set P.K. From Record Surveys

SLM = 26+46.09

0.7' LT. & Paut SR 191

ON & Co. Rd B-50

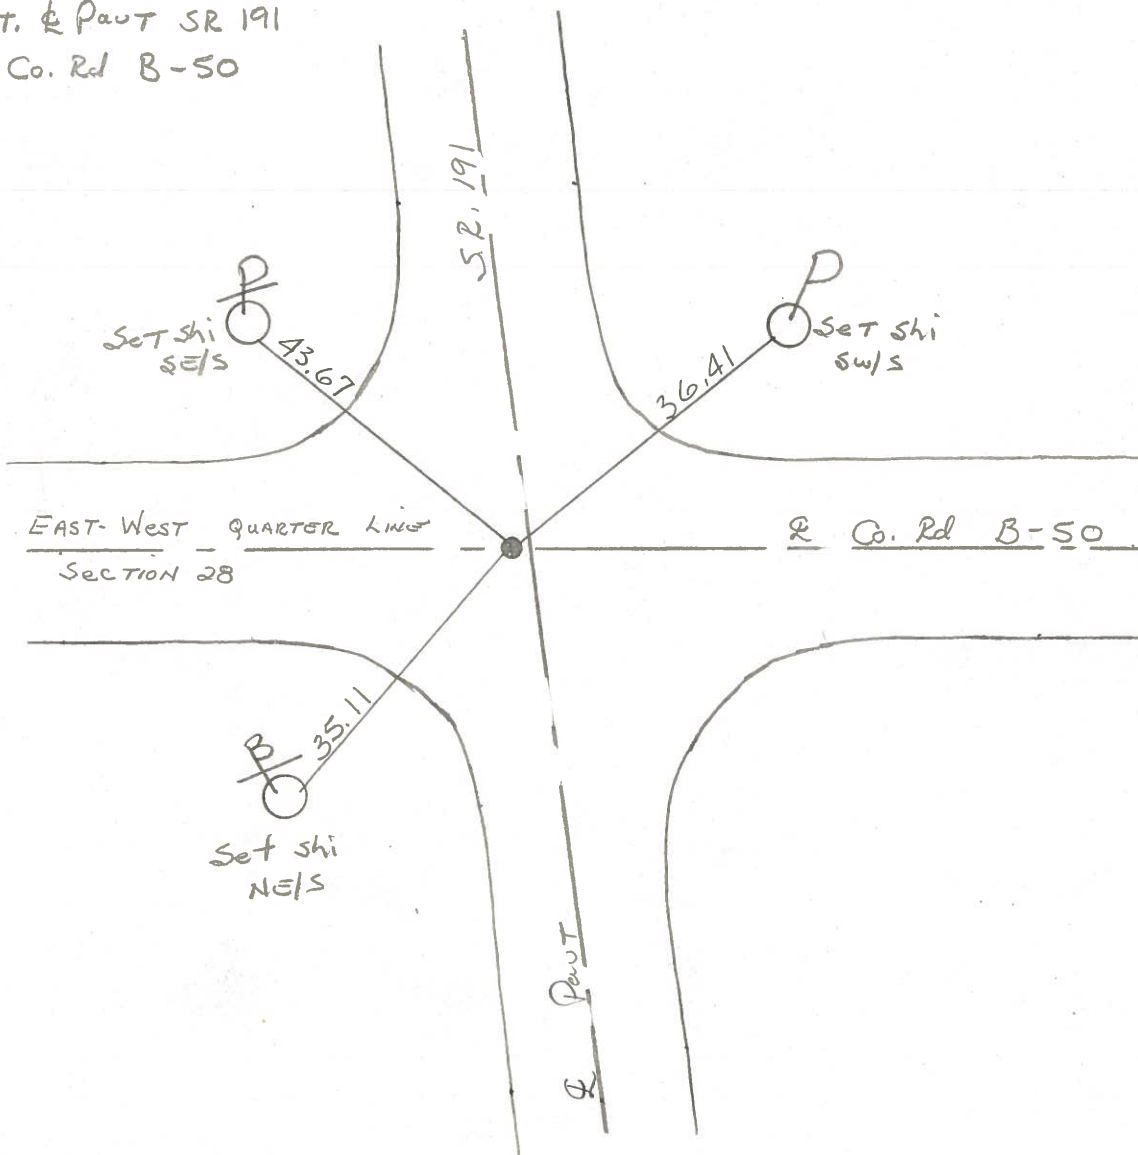

County Williams S.R. 191

Date 5-24-84

Township SPRINGFIELD

Weather Clear

Section 28

Temp. 60°


T6N, R4E

Personnel Hoffman

Loehrke H.C.

Householder R.C.

3

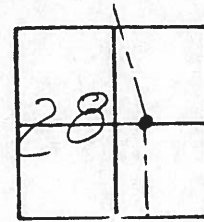

Set P.K. FROM RECORD SURVEYS

S.L.M. = 26+46.09

0.7' LT. & PAUT SR 191
ON & Co. Rd B-50

