

O.D.O.T. DISTRICT 2 SURVEY OFFICE (USE ONLY)

PERSONNEL

REFERENCE NO. 4

SHEET 8 OF 34

NOTES ASTON DATE 3-29-24

H.C. RHOADES WEATHER SUNNY

R.C. ASTON TEMP. 46°

ROUTE SR 191

COUNTY WILLIAMS

TOWNSHIP SPRINGFIEND

SECTION 28

DWG BY RHOADES PID PAVETRAIN

T 6 N R 4 E

TYPE MONUMENT MAG NAIL

ON SURFACE - ~~BELOW~~ ON

OFFSET C PAVEMENT 1' LT : ~~RT~~

- TO - EDGE PAVEMENT



STATION: 53+22

HORZ. DATUM: NAD83 2011

GEOID: NAVD88 2018

GRID: NORTHING: 657776.611

EASTING: 1445482.775

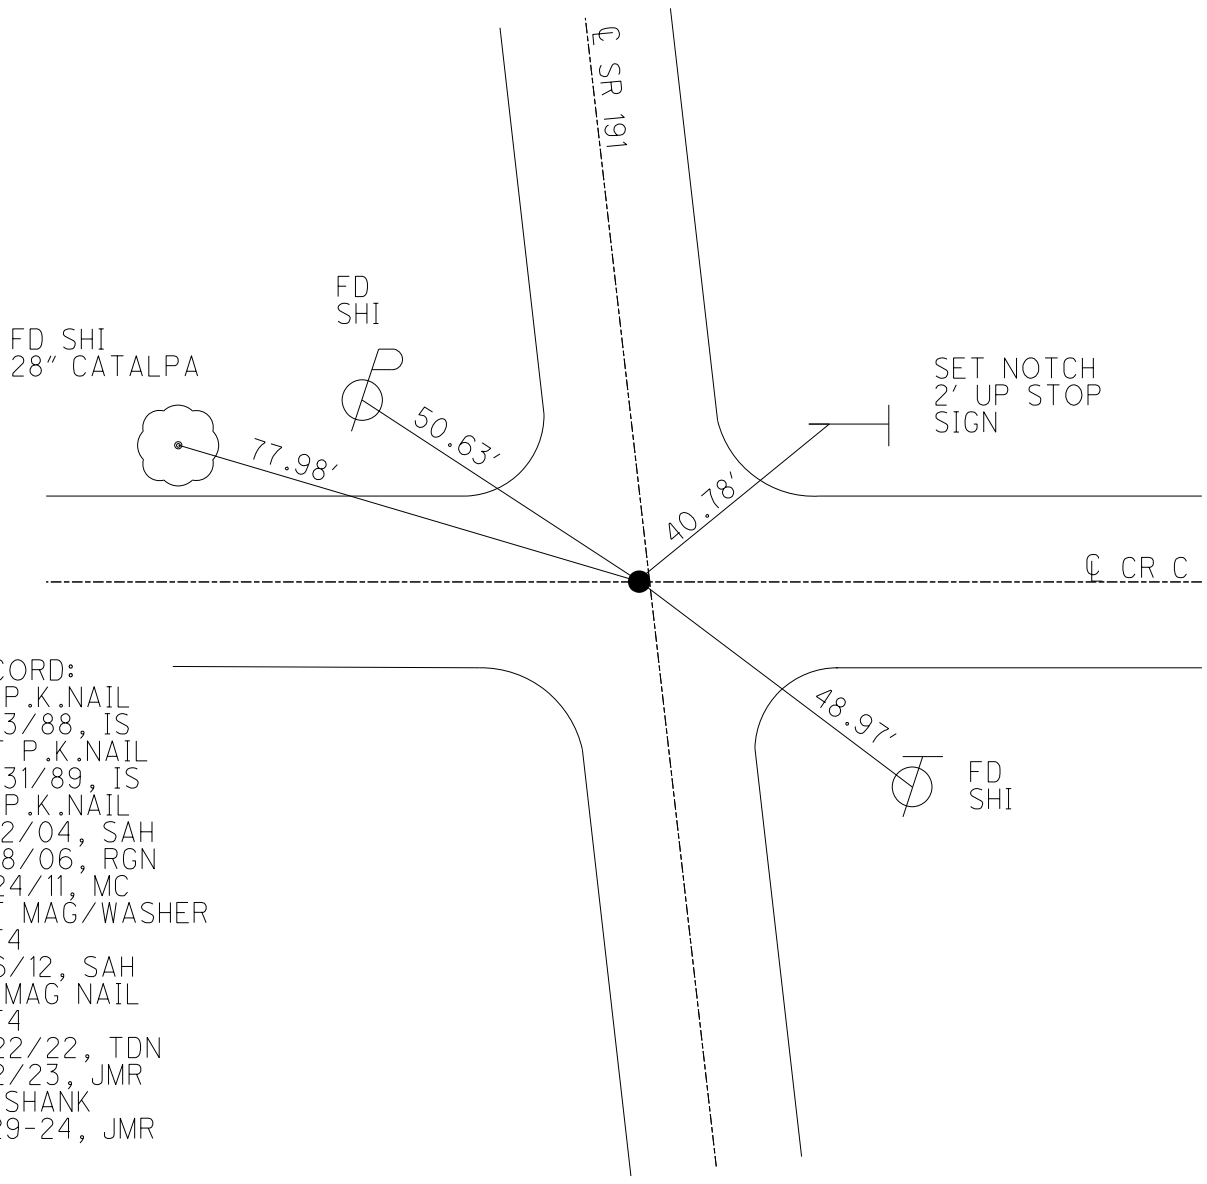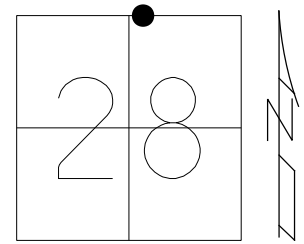


RECORD:
 FD P.K.NAIL
 10/3/88, IS
 SET P.K.NAIL
 10/31/89, IS
 FD P.K.NAIL
 12/2/04, SAH
 4/18/06, RGN
 6/24/11, MC
 SET MAG/WASHER
 REF4
 2/6/12, SAH
 FD MAG NAIL
 REF4
 6/22/22, TDN
 2/2/23, JMR
 FD SHANK
 3-29-24, JMR


O.D.O.T. DISTRICT 2 SURVEY OFFICE (USE ONLY)

PERSONNEL _____ REFERENCE NO. 4 SHEET 8 OF 34
 NOTES RHOADES DATE 6/22/22 ROUTE SR 191
 H.C. NIESE WEATHER SUNNY COUNTY WILLIAMS
 R.C. WHITAKER TEMP. 83° TOWNSHIP SPRINGFIEND
 SECTION 28
 DWG BY RHOADES PID PAVETRAN T 6 N R 4 E

TYPE MONUMENT MAG NAIL
 ON SURFACE - ~~BELOW~~ ON _____
 OFFSET \varnothing PAVEMENT 1' LT : ~~RT~~
 - TO - EDGE PAVEMENT
 STATION: 53+22

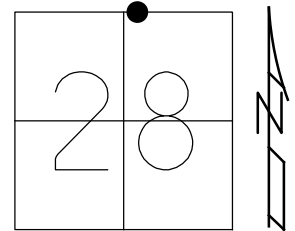

HORIZ.DATUM: NAD83 2011 GEOID: NAVD88 2018
 GRID: NORTHING: 657776.611 EASTING: 1445482.775


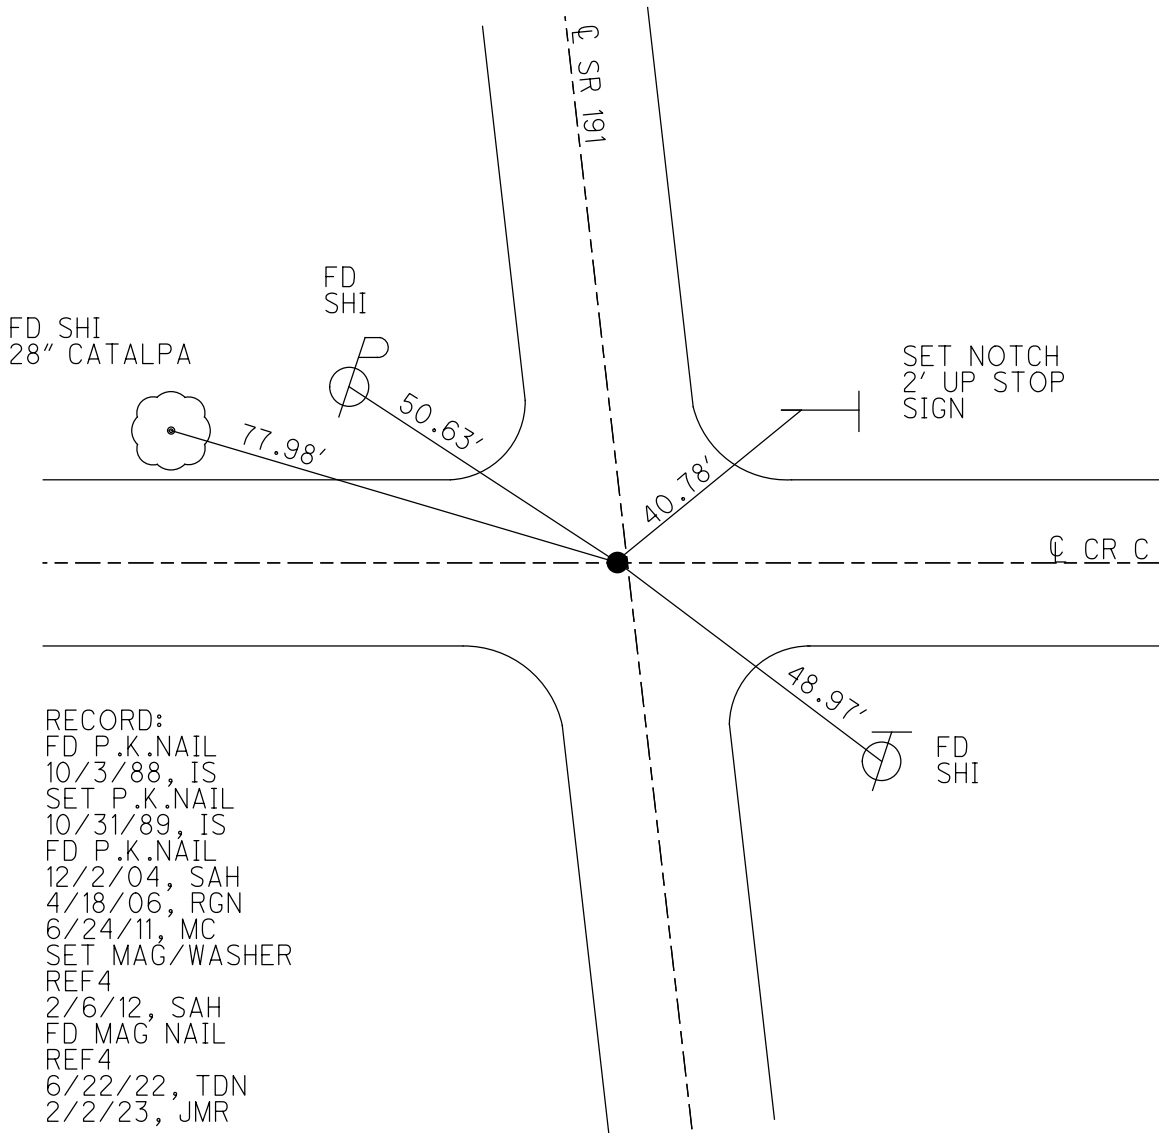


RECORD:
 FD P.K.NAIL
 10/3/88, IS
 SET P.K.NAIL
 10/31/89, IS
 FD P.K.NAIL
 12/2/04, SAH
 4/18/06, RGN
 6/24/11, MC
 SET MAG/WASHER
 REF4
 2/6/12, SAH
 FD MAG NAIL
 REF4
 6/22/22, TDN
 2/2/23, JMR

O.D.O.T. DISTRICT 2 SURVEY OFFICE (USE ONLY)

PERSONNEL _____ REFERENCE NO. 4 SHEET 8 OF 34
 NOTES HUSS DATE 6/24/11 ROUTE SR 191
 H.C. HUSS WEATHER RAIN COUNTY WILLIAMS
 R.C. CANTERBURY TEMP. 67° TOWNSHIP SPRINGFIELD
 SECTION 28
 T 6 N R 4 E

TYPE MONUMENT P.K.NAIL
 ON SURFACE - ~~BELOW~~ ON _____
 LEFT - ☉ PAV'T - ~~RIGHT~~ 1', ON ☉ CR C
 - TO - EDGE PAVEMENT
 S.L.M. 53+22
 GRID: NORTHING: 657776.580 EASTING: 1445482.689

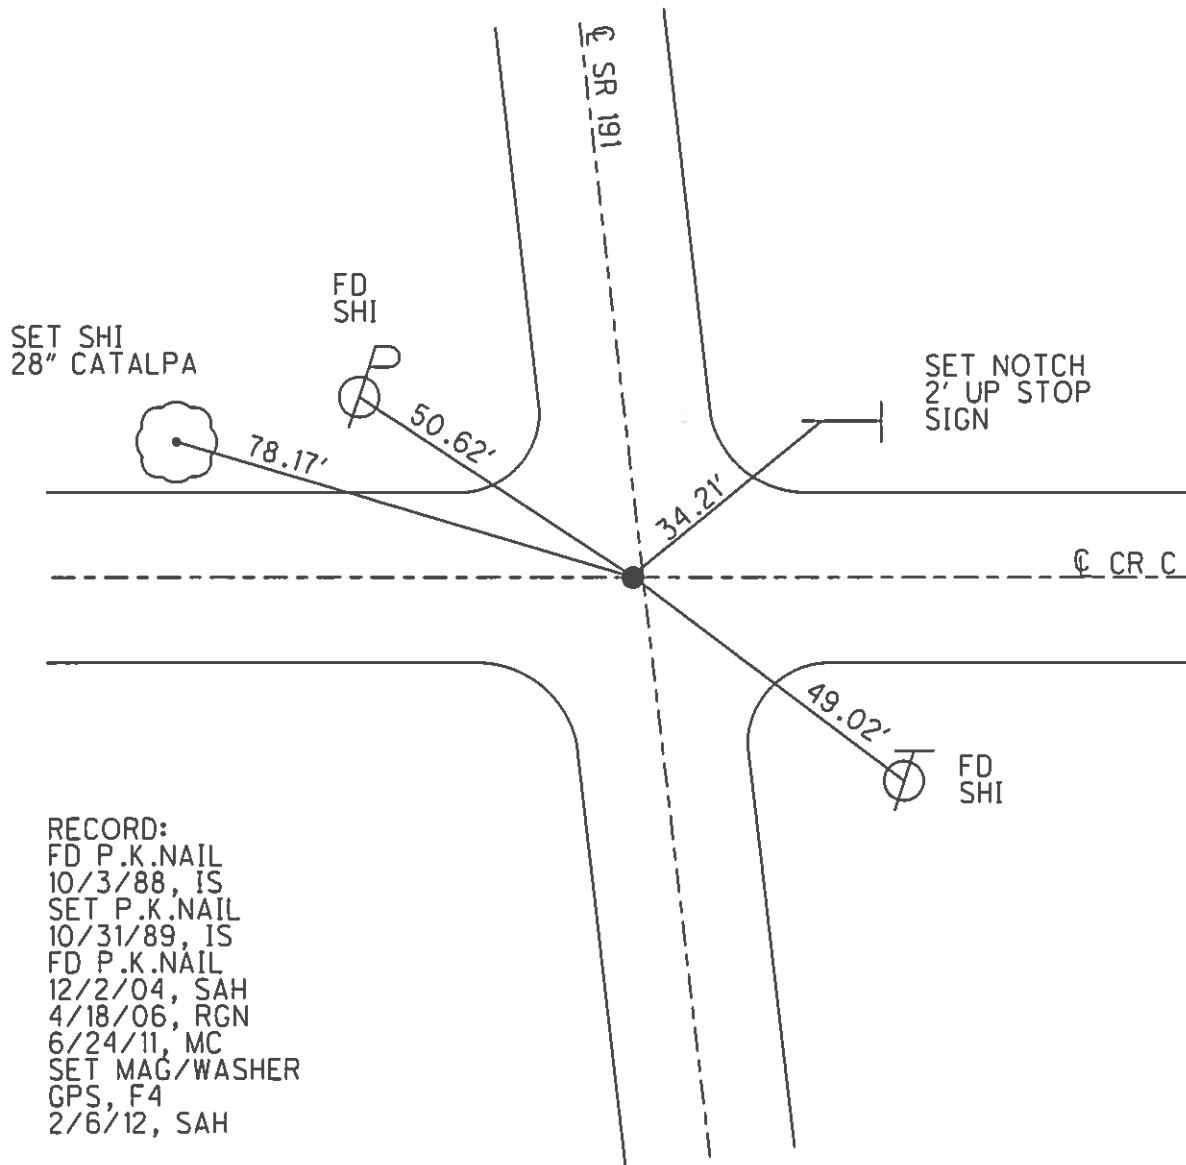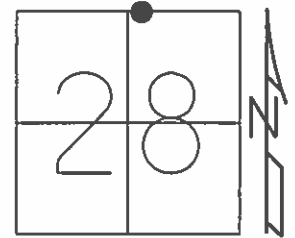

RECORD:
 FD P.K.NAIL
 10/3/88, IS
 SET P.K.NAIL
 10/31/89, IS
 FD P.K.NAIL
 12/2/04, SAH
 4/18/06, RGN
 6/24/11, MC
 SET MAG/WASHER
 GPS, F4
 2/6/12, SAH

O.D.O.T. DISTRICT 2 SURVEY OFFICE

PERSONNEL _____

REFERENCE NO. 4

SHEET 6 OF _____

NOTES 1. Stone

H.C. D. Curtis

DATE 3 Oct. 88

ROUTE SR#191

R.C. J. Householder

WEATHER Cool

COUNTY Williams

TEMP. 61°

TOWNSHIP Springfield

SECTION _____

T _____ R _____


TYPE MONUMENT PK Nail

ON SURFACE - BELOW Surface

LEFT - ☉ PAV'T. - RIGHT _____

TO _____ EDGE PAVEMENT

S.L.M. 53+22

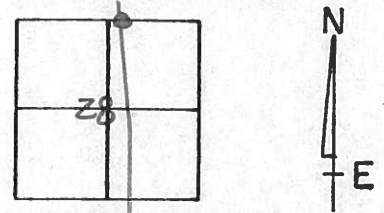

Set PK Nail 10/31/89 IRS

