

O.D.O.T. DISTRICT 2 SURVEY OFFICE (USE ONLY)

PERSONNEL

REFERENCE NO. 10

SHEET 14 OF 34

NOTES JAMES

DATE 3/20/19

ROUTE SR 191

H.C. O'DONNELL

WEATHER CLOUDY

COUNTY WILLIAMS

R.C. JAMES

TEMP. 36°

TOWNSHIP SPRINGFIELD

DWG BY NIESE PID 92373

SECTION 5

T 6 N R 4 E

TYPE MONUMENT MAG SHANK

ON SURFACE - ~~BELOW~~ ON

OFFSET  $\odot$  PAVEMENT 0.3' LT : ~~RT~~

9.9' TO LT EDGE PAVEMENT



STATION: 273+80.82

HORZ.DATUM: NAD83(2011)

GEOID: 12A

GRID: NORTHING: 676486.932

EASTING: 1440291.092

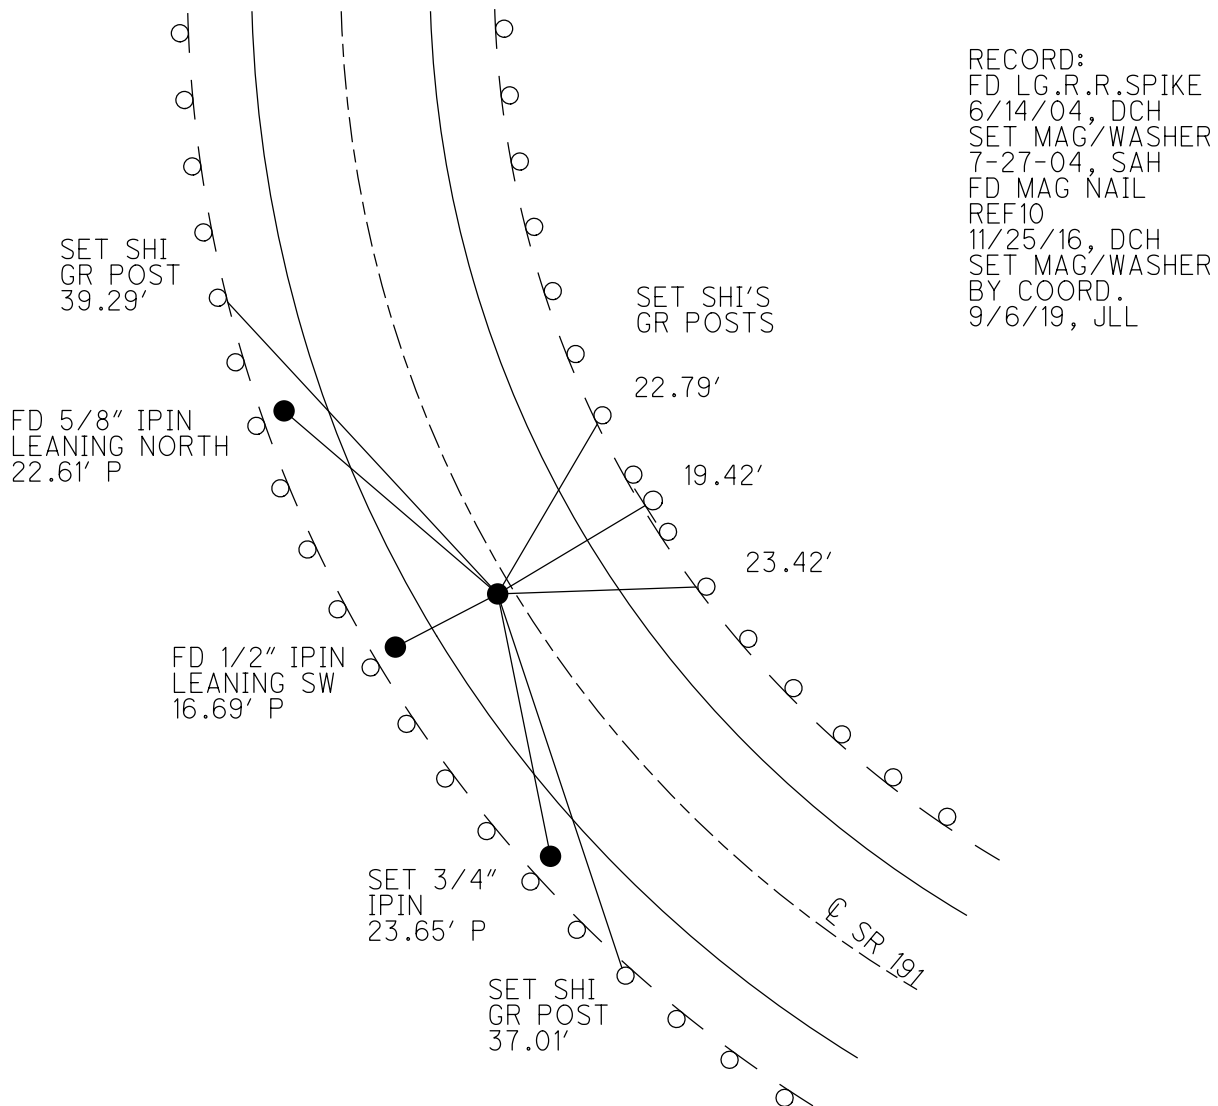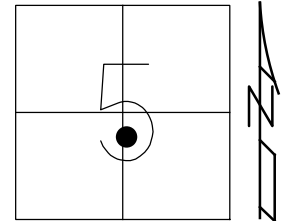


RECORD:  
 FD LG.R.R.SPIKE  
 6/14/04, DCH  
 SET MAG/WASHER  
 7-27-04, SAH  
 FD MAG NAIL  
 REF10  
 11/25/16, DCH  
 SET MAG/WASHER  
 BY COORD.  
 9/6/19, JLL

O.D.O.T. DISTRICT 2 SURVEY OFFICE (USE ONLY)


PERSONNEL \_\_\_\_\_ REFERENCE NO. 10 SHEET 14 OF 34  
 NOTES HUSS DATE 6/14/04 ROUTE SR 191  
 H.C. HOMAN WEATHER CLOUDY COUNTY WILLIAMS  
 R.C. NUHFER TEMP. 80° TOWNSHIP SPRINGFIELD  
 \_\_\_\_\_ SECTION 5  
 \_\_\_\_\_ T 6 N R 4 E

TYPE MONUMENT LG.R.R.SPIKE  
 ON SURFACE - ~~BELOW~~ ON \_\_\_\_\_  
 LEFT - ~~PAVT~~ - RIGHT 0.3'  
9.9' TOLT EDGE PAVEMENT  
 S.L.M. 273+82

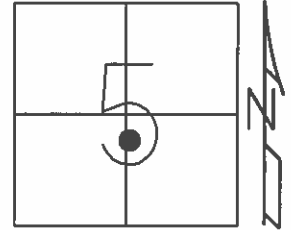

GRID: NORTHING: - EASTING: -

SET MAG & WASHER  
 7-27-04  
 SAH

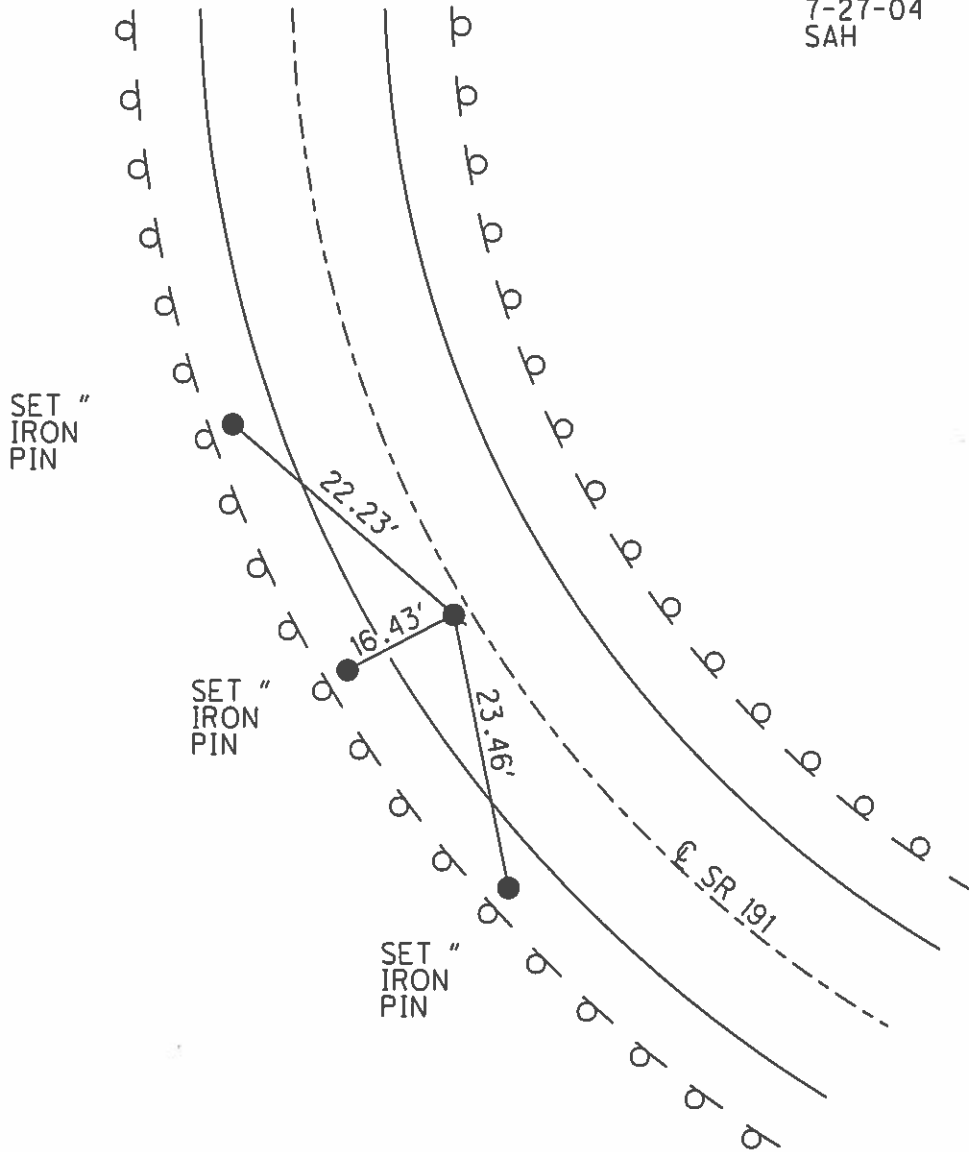

O.D.O.T. DISTRICT 2 SURVEY OFFICE

PERSONNEL

REFERENCE NO. 10

SHEET 4 OF 23

NOTES HUSS

DATE 06-14-04

ROUTE SR 191

H.C. HOMAN

WEATHER CLOUDY

COUNTY WILLIAMS

R.C. NUHFER

TEMP. 80°

TOWNSHIP SPRINGFIELD

SECTION 5

T 6 N R 4 E


TYPE MONUMENT LG RR SPIKE

ON SURFACE - ~~BELOW~~ ON


LEFT - ~~C PAVT~~ - ~~RIGHT~~ 0.3' LT

9.9 TO LT EDGE PAVEMENT

S.L.M. 273+82

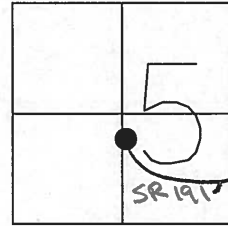

SET MAG & WASHER  
7-27-04  
SAH

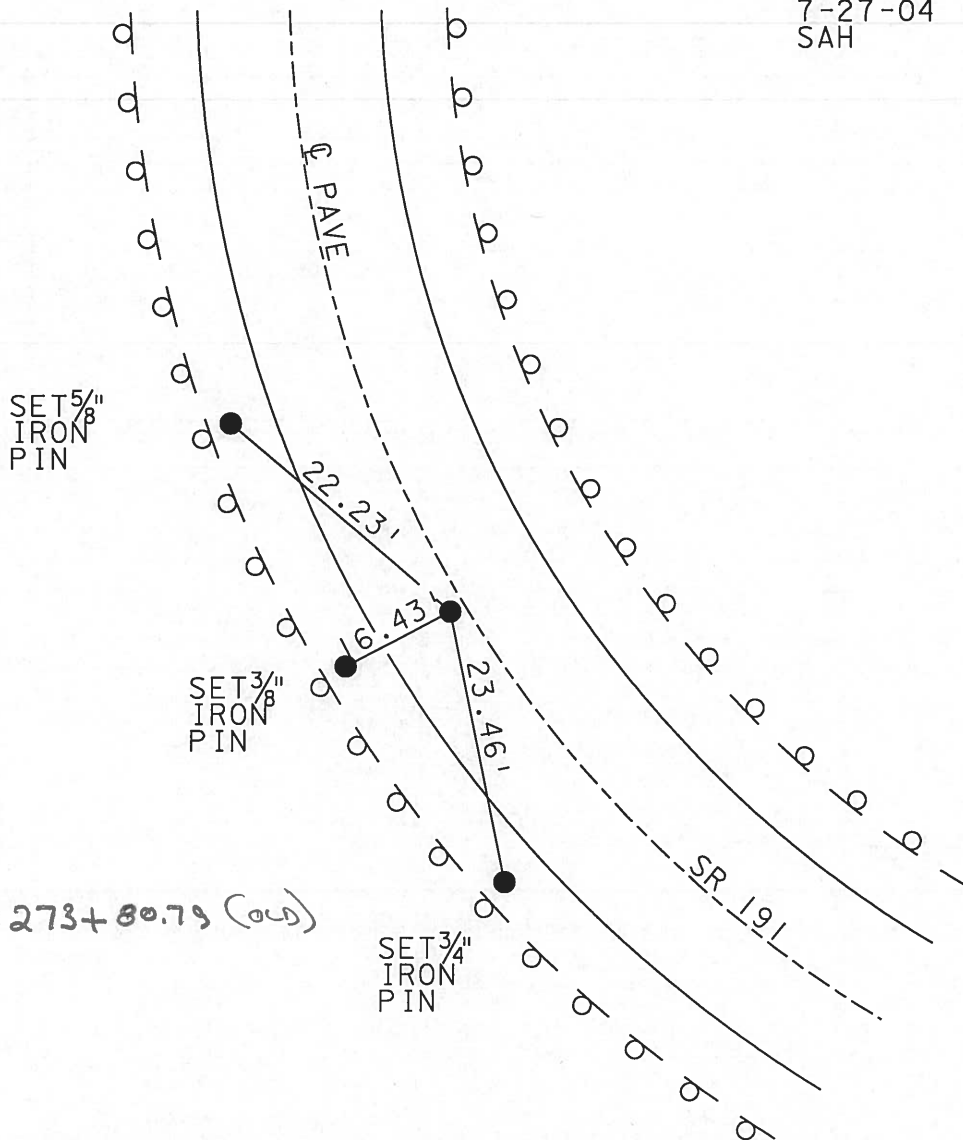

C.S. sta = 273+80.79 (O.S.)

# O.D.O.T. DISTRICT 2 SURVEY OFFICE

PERSONNEL \_\_\_\_\_

REFERENCE NO. \_\_\_\_\_

SHEET 3 OF 22

NOTES L. Stone

H.C. D. Curtis

R.C. J. Householder

DATE 7 Jan. 87

WEATHER Cloudy

TEMP. 30°

ROUTE SR#161

COUNTY Williams

TOWNSHIP Springfield

SECTION 5

T \_\_\_\_\_ R \_\_\_\_\_


TYPE MONUMENT R.R. Spk.

ON SURFACE - BELOW 2" deep

LEFT- & PAV'T. - RIGHT \_\_\_\_\_

TO \_\_\_\_\_ EDGE PAVEMENT

S.L.M. 273+82

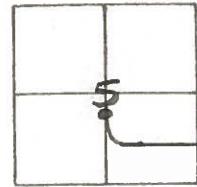

Set Small R.R. Spk. To Surface  
9-10-87

