

O.D.O.T. DISTRICT 2 SURVEY OFFICE (USE ONLY)

PERSONNEL

REFERENCE NO. 11

SHEET 15 OF 34

NOTES AUBLE

DATE 9/6/19

ROUTE SR 191

H.C. LEU

WEATHER CLOUDY

COUNTY WILLIAMS

R.C. NASON

TEMP. 67°

TOWNSHIP SPRINGFIELD

NIESE

SECTION 5

DWG BY NIESE PID 92373

T 6 N R 4 E

TYPE MONUMENT MAG/WASHER

ON SURFACE - ~~BELOW~~ ON

OFFSET 1.0' Pavement ~~LT~~ : RT
11.5' TO LT EDGE PAVEMENT



STATION: 276+80.82

HORZ. DATUM: NAD83(2011)

GEOID: 12A

GRID: NORTHING: 676786.575

EASTING: 1440281.761

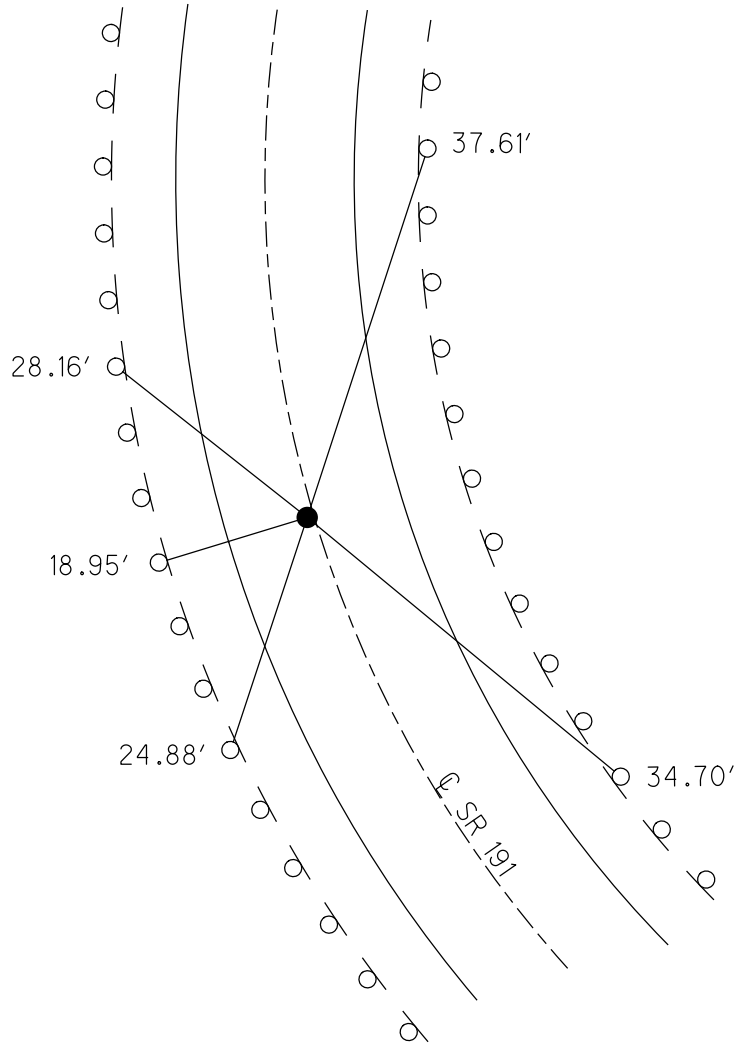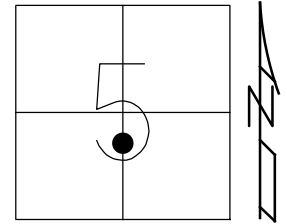


SET SHI'S GR POSTS

RECORD: S.T.
 STA 276+80.79
 FD SM.R.R.SPIKE
 6/14/04, DCH
 SET MAG/WASHER
 7/27/04, SAH
 FD MAG/WASHER
 REF11
 11/25/16, DCH
 SET MAG/WASHER
 BY COORD.
 9/6/19, JLL

O.D.O.T. DISTRICT 2 SURVEY OFFICE (USE ONLY)

PERSONNEL _____ REFERENCE NO. 11 SHEET 15 OF 34
 NOTES HUSS DATE 6/14/04 ROUTE SR 191
 H.C. HOMAN WEATHER CLOUDY COUNTY WILLIAMS
 R.C. NUHFER TEMP. 76° TOWNSHIP SPRINGFIELD
 _____ SECTION 5
 _____ T 6 N R 4 E


TYPE MONUMENT SM.R.R.SPIKE
 ON SURFACE - ~~BELOW~~ ON _____
 LEFT - C PAV'T - RIGHT ON _____
11.5' TO LT EDGE PAVEMENT
 S.L.M. 276+82

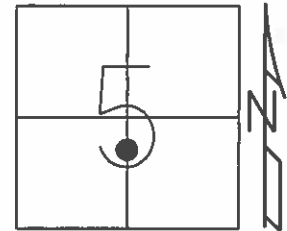

GRID: NORTHING: _____ - EASTING: _____ -

S.T. STA 276+80.79 (OLD)

SET MAG & WASHER
 7-27-04
 SAH

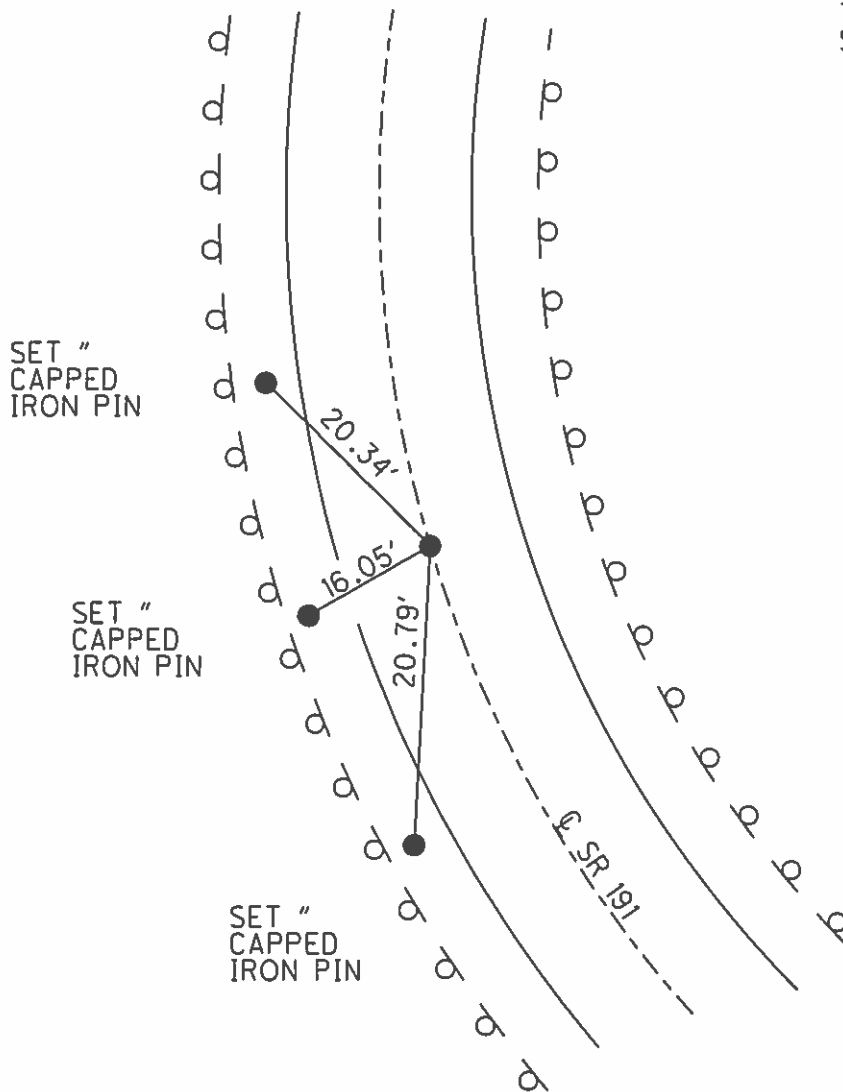

O.D.O.T. DISTRICT 2 SURVEY OFFICE

PERSONNEL _____

REFERENCE NO. 11

SHEET 5 OF 23

NOTES HUSS

DATE 06-14-04

ROUTE SR 191

H.C. HOMAN

WEATHER CLOUDY

COUNTY WILLIAMS

R.C. NUHFER

TEMP. 76°

TOWNSHIP SPRINGFIELD

SECTION 5

T 6 N R 4 E


TYPE MONUMENT SM RR SPIKE

ON SURFACE ~~BELOW~~ ON

~~LEFT - Q~~ PAV'T ~~RIGHT~~ ON


11.5' TO LT EDGE PAVEMENT

S.L.M. 276+82

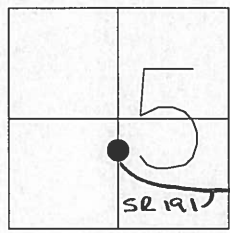

S.T. STA 276+80.79 (OLD)

SET MAG & WASHER
7-27-04
SAH

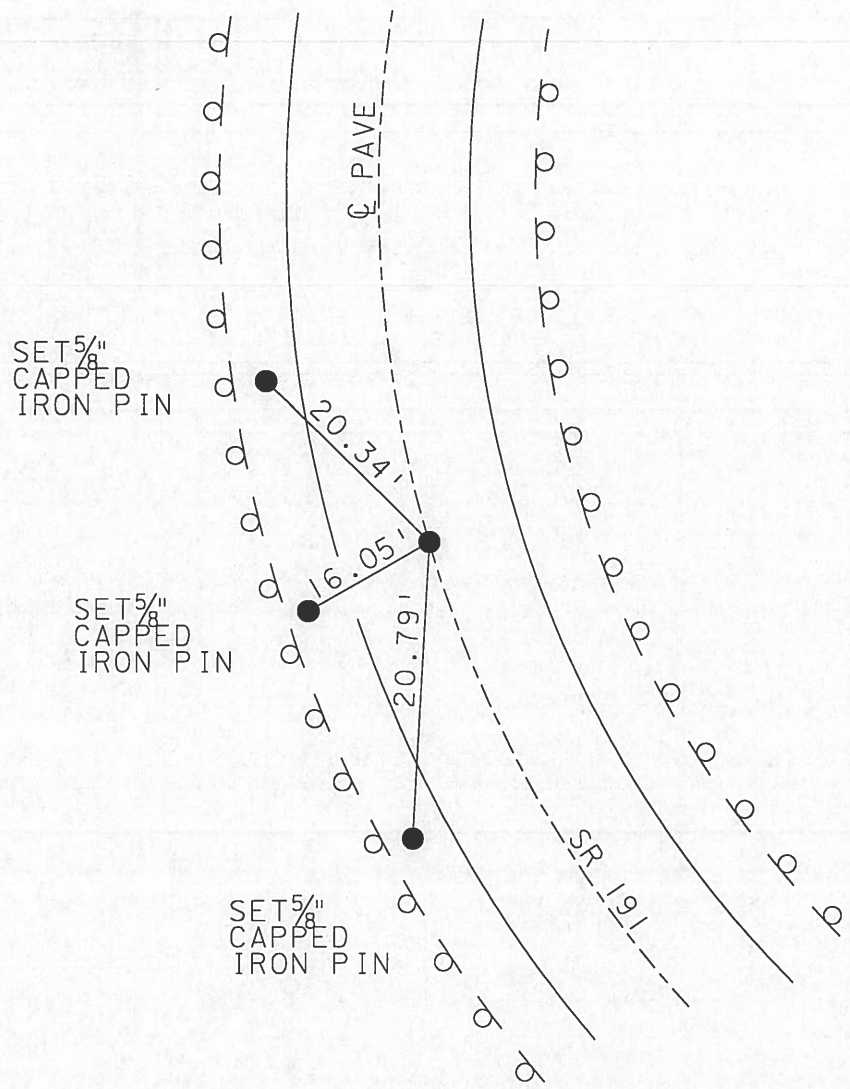

O.D.O.T. DISTRICT 2 SURVEY OFFICE

PERSONNEL _____

REFERENCE NO. _____

SHEET 4 OF 22

NOTES 1. Stone

H.C. D. Curtis

R.C. J. Householder

DATE 7 Jan. 87

WEATHER Cloudy

TEMP. 30°

ROUTE SR#191

COUNTY Williams

TOWNSHIP Springfield

SECTION 5

T _____ R _____


TYPE MONUMENT RR Spk.

ON SURFACE - BELOW 2" deep

LEFT - & PAV'T. - RIGHT _____


_____ TO _____ EDGE PAVEMENT

S.L.M. 276+82

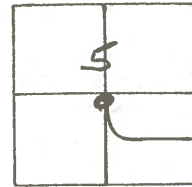

set Small R.R. Spk. To Surface

19-10-87

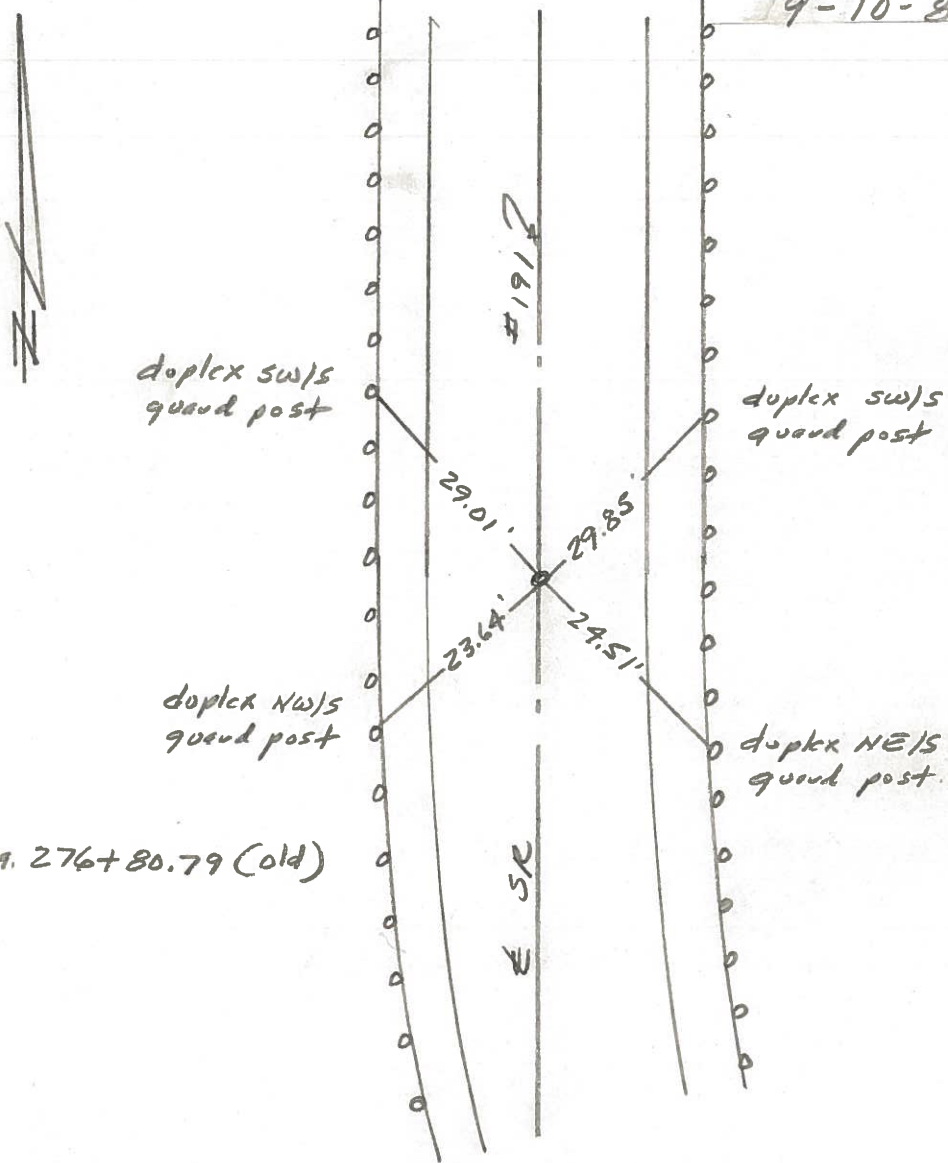

SIT. Sta. 276+80.79 (old)