



O.D.O.T. DISTRICT 2 SURVEY OFFICE (USE ONLY)

PERSONNEL _____ REFERENCE NO. 23 C SHEET 27 OF 34
 NOTES RHOADES DATE 7/12/18 ROUTE SR 191
 H.C. LEU WEATHER CLEAR COUNTY WILLIAMS
 R.C. HAGEMeyer TEMP. 74° TOWNSHIP BRADY
 DWG BY NASON PID 92373 SECTION 8
 T 7 N R 4 E

TYPE MONUMENT MAG NAIL
 ON SURFACE - ~~BELOW~~ ON _____
 OFFSET ϕ PAVEMENT 1.2' LT : ~~RT~~
 - TO - EDGE PAVEMENT
 STATION: 528+74.14

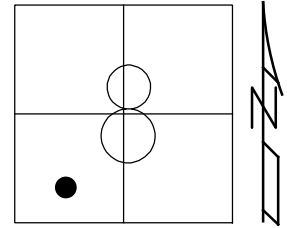

HORIZ.DATUM: NAD83(2011) GEOID: 2012A
 GRID: NORTHING: 700761.432 EASTING: 1439373.527

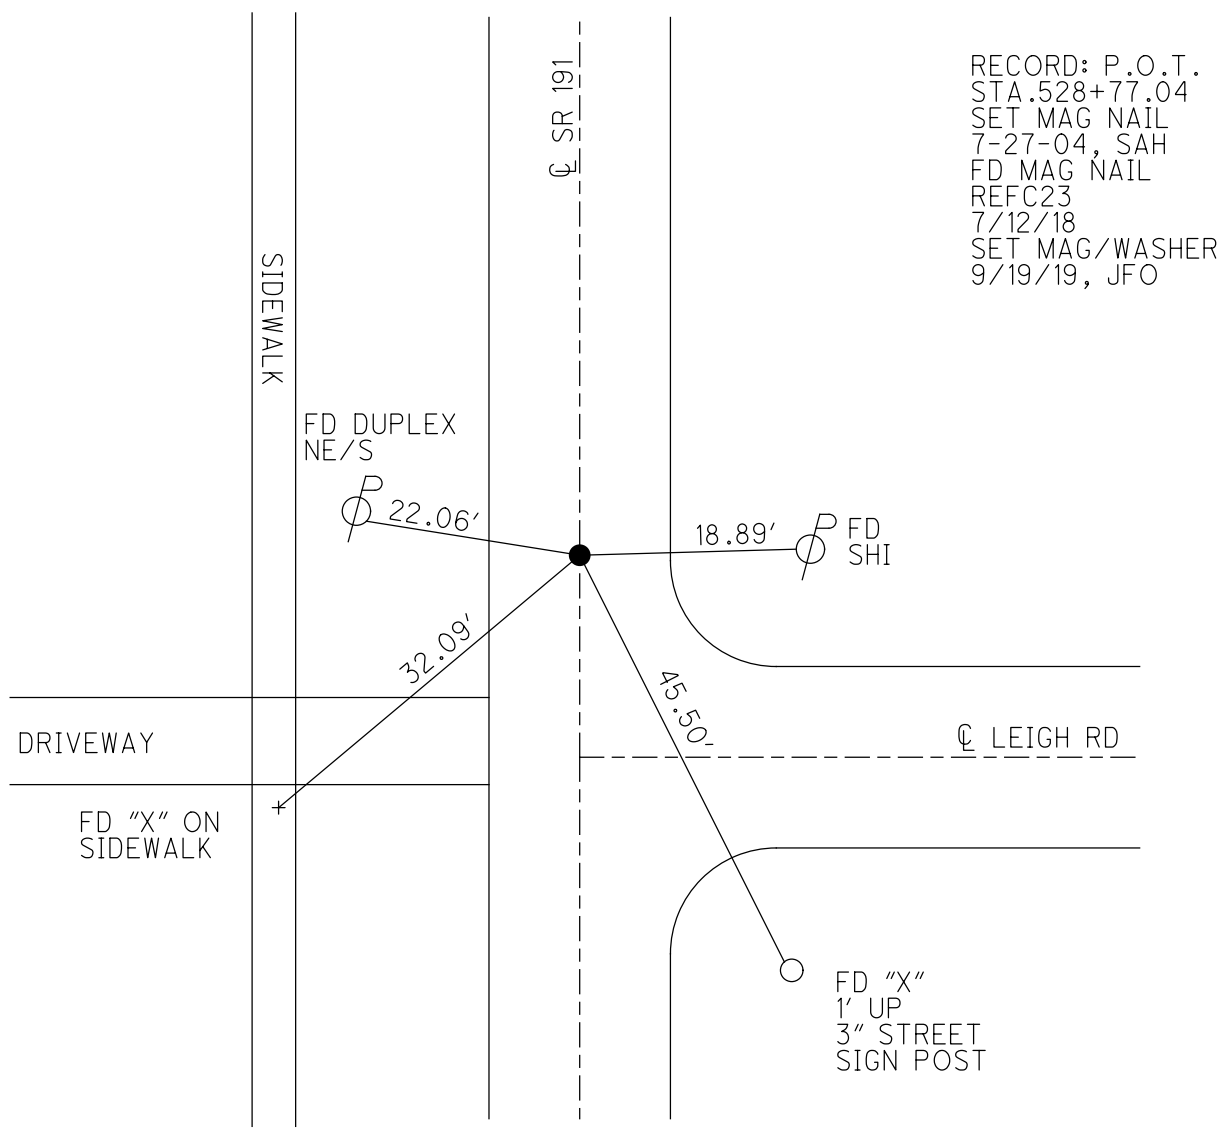

O.D.O.T. DISTRICT 2 SURVEY OFFICE (USE ONLY)

PERSONNEL _____ REFERENCE NO. 23 C SHEET 27 OF 34

NOTES HUSS DATE 6/15/04 ROUTE SR 191

H.C. HOMAN WEATHER CLEAR COUNTY WILLIAMS

R.C. NUHFER TEMP. 78° TOWNSHIP BRADY

SECTION 8

T 7 N R 4 E

TYPE MONUMENT SM.R.R.SPIKE


ON SURFACE - ~~BELOW~~ ON _____

LEFT - ~~C PAV'T~~ - RIGHT 0.6'

- TO - EDGE PAVEMENT


S.L.M. 528+75

GRID: NORTHING: _____ EASTING: _____

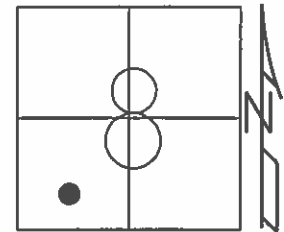

P.O.T. STA 528+77.04 (OLD)


SET MAG NAIL
7-27-04
SAH

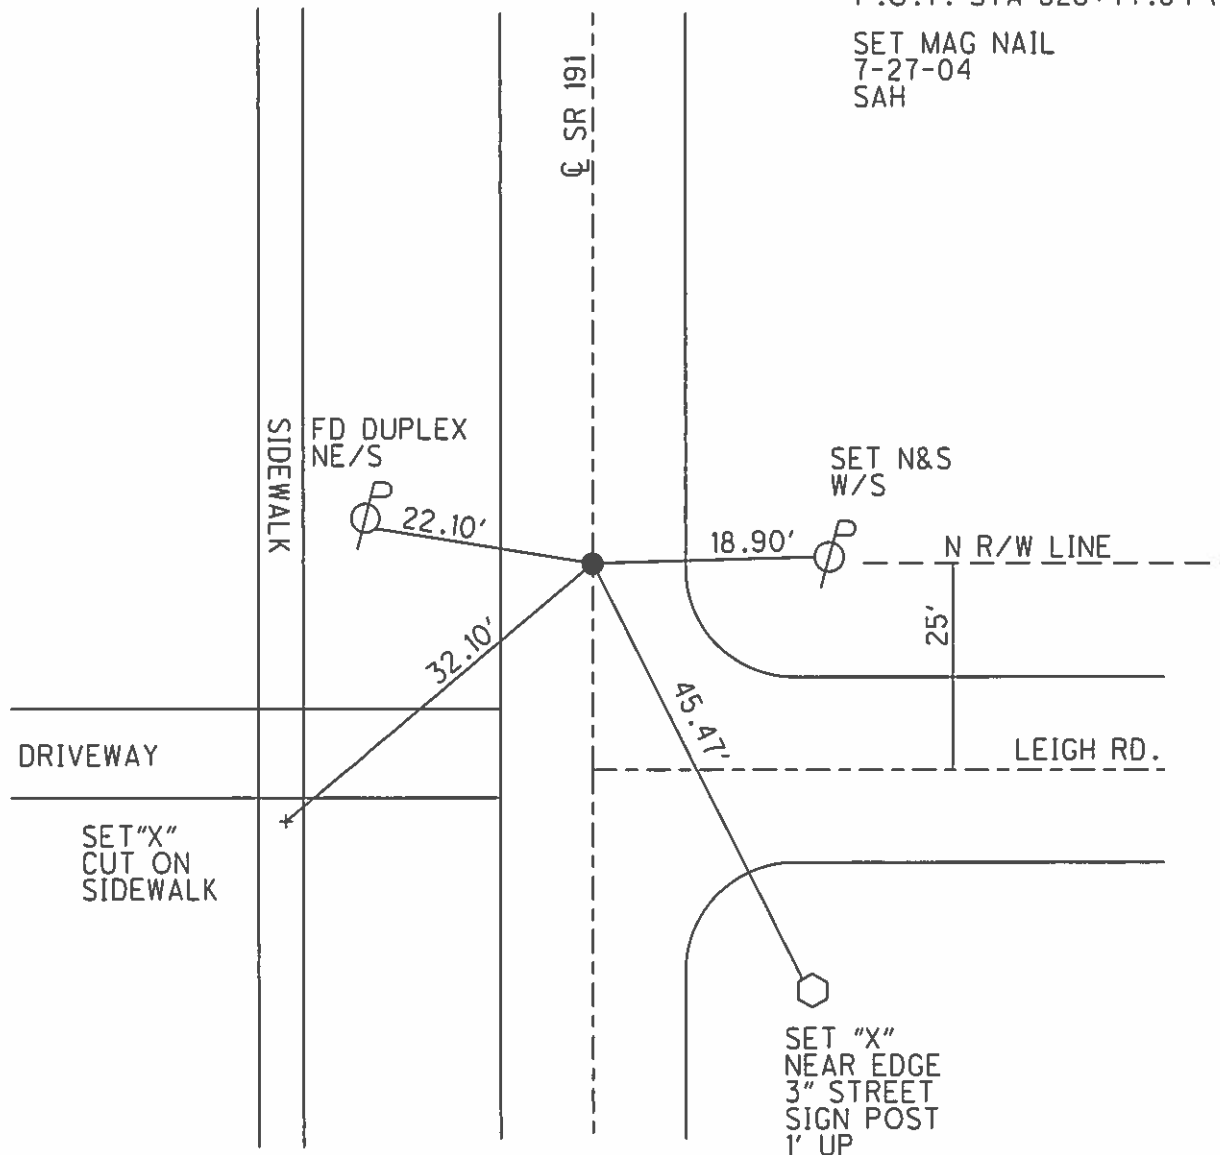

O.D.O.T. DISTRICT 2 SURVEY OFFICE


PERSONNEL	REFERENCE NO. <u>23-C</u>	SHEET <u>17</u> OF <u>23</u>
NOTES <u>HUSS</u>	DATE <u>6-15-04</u>	ROUTE <u>SR 191</u>
H.C. <u>HOMAN</u>	WEATHER <u>CLEAR</u>	COUNTY <u>WILLIAMS</u>
R.C. <u>NUHFER</u>	TEMP. <u>78°</u>	TOWNSHIP <u>BRADY</u>
		SECTION <u>8</u>
		<u>T 7 N R 4 E</u>

TYPE MONUMENT SM RR SPIKE
 ON SURFACE ~~BELOW~~ ON
 LEFT ~~PAVT~~ ~~RIGHT~~ 0.6' LT
TO EDGE PAVEMENT
 S.L.M. 528+75

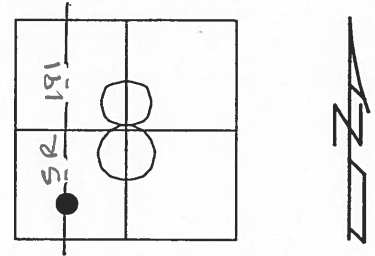

SET MAG NAIL
 7-27-04
 SAH

P.O.T. STA 528+77.04 (OLD)

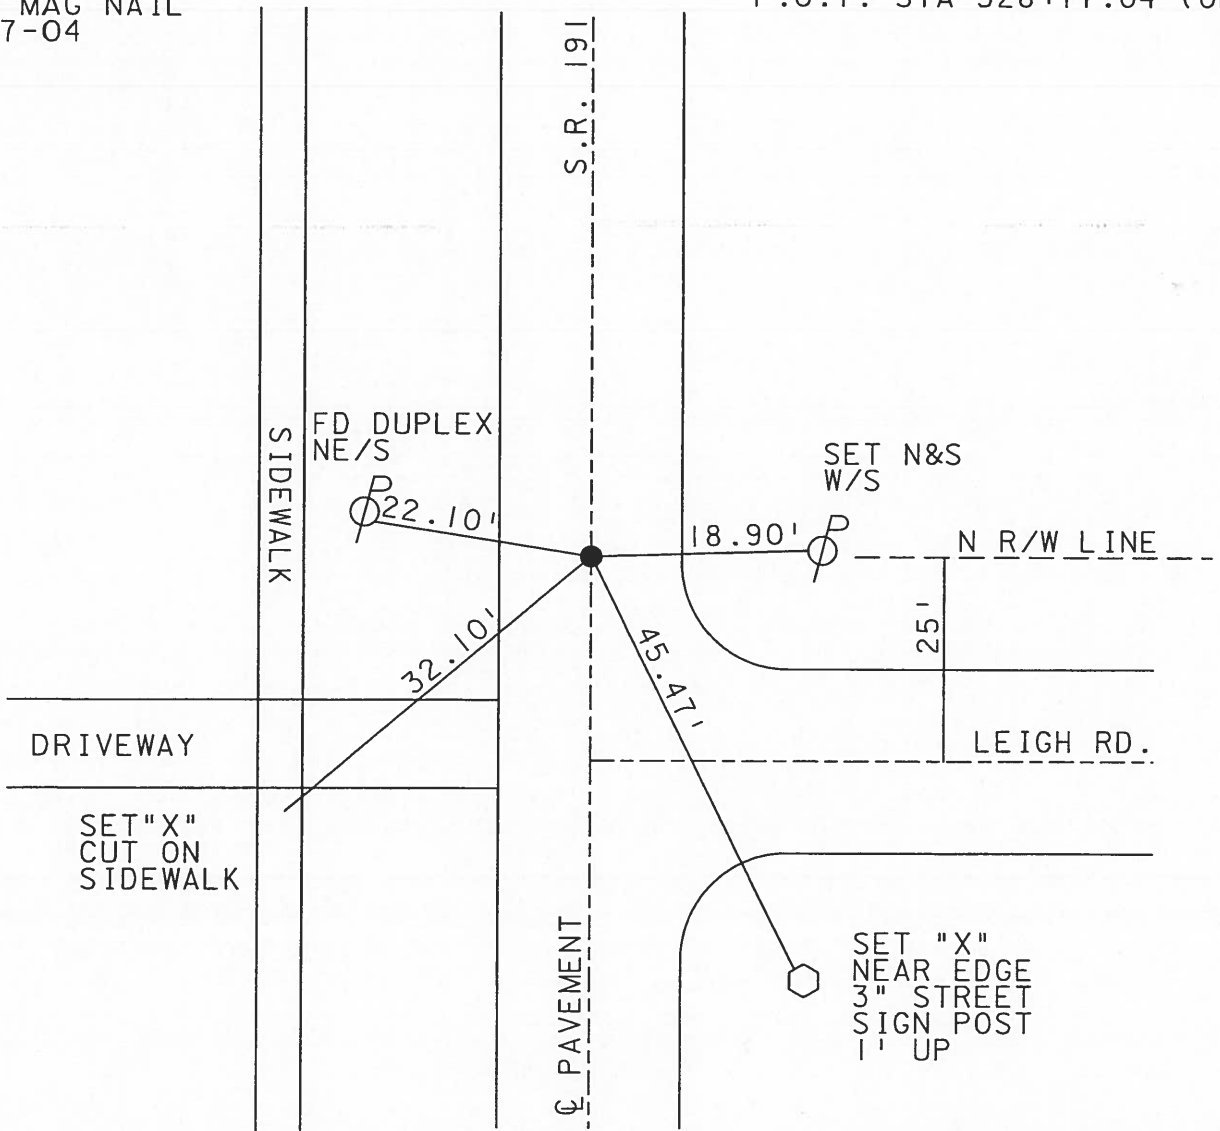

O.D.O.T. DISTRICT 2 SURVEY OFFICE

PERSONNEL

REFERENCE NO. 23-C

SHEET 16 OF 22

NOTES I. Stone

H.C. J. Curtis

R.C. J. Houscholder

DATE 14 Jan. 87

WEATHER Cool

TEMP. 37°

ROUTE SR #191

COUNTY Williams

TOWNSHIP Brady

SECTION 8

T. R.


TYPE MONUMENT 3/4" I. pipe

ON SURFACE - BELOW 2" deep

LEFT- PAV'T. - RIGHT

 TO EDGE PAVEMENT

S.L.M. 528+75

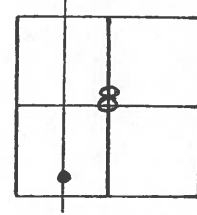

*Set Small R.R. Spk. To Surface
9-10-87*

