

O.D.O.T. DISTRICT 2 SURVEY OFFICE (USE ONLY)

PERSONNEL

REFERENCE NO. 23 F

SHEET 30 OF 34

NOTES RHOADES

DATE 7/12/18

ROUTE SR 191

H.C. LEU

WEATHER CLEAR

COUNTY WILLIAMS

R.C. HAGEMeyer

TEMP. 75°

TOWNSHIP BRADY

DWG BY NASON

PID 92373

SECTION 8

T 7 N R 4 E

TYPE MONUMENT MAG SHANK

~~ON SURFACE~~ - BELOW 1"

OFFSET Q PAVEMENT 1.8' LT : ~~RT~~

10.8' TO RT EDGE PAVEMENT


STATION: 535+39.69

HORZ. DATUM: NAD83(2011)


GEOID: 2012A

GRID: NORTHING: 701426.880

EASTING: 1439377.280

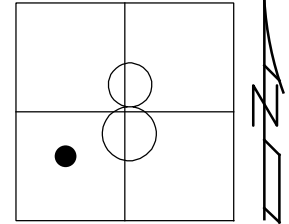

RECORD:  
 SET MAG NAIL  
 7-27-04, SAH  
 FD SM.R.R.SPIKE  
 6/15/04, DCH  
 FD MAG SHANK  
 1" DOWN  
 REFF23  
 7/12/18  
 SET MAG/WASHER  
 9/19/19/, JLL

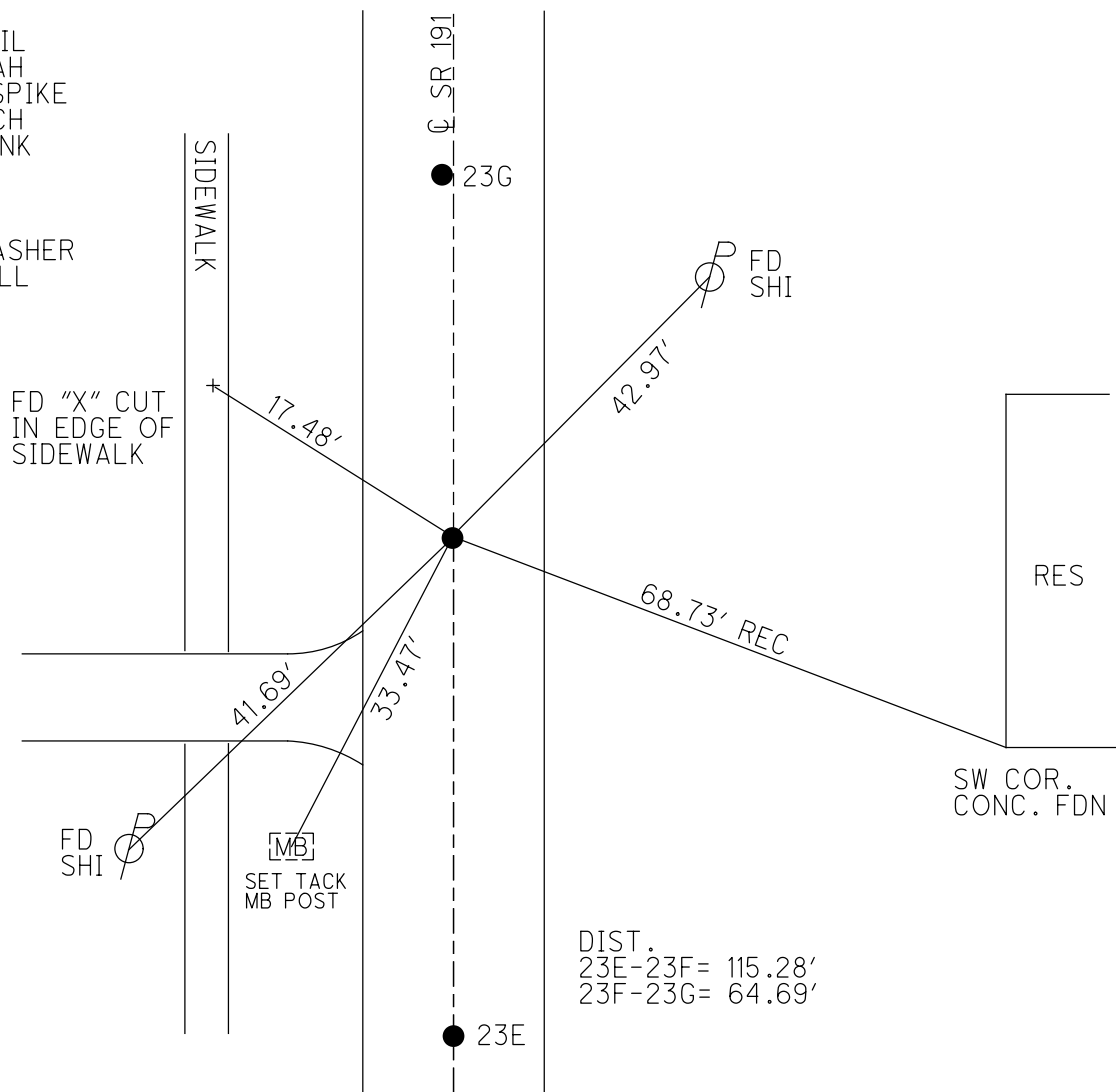

DIST.  
 23E-23F = 115.28'  
 23F-23G = 64.69'

O.D.O.T. DISTRICT 2 SURVEY OFFICE (USE ONLY)

PERSONNEL


REFERENCE NO. 23 F SHEET 30 OF 34

NOTES HUSS  
 H.C. HOMAN  
 R.C. NUHFER

DATE 6/15/04  
 WEATHER CLEAR  
 TEMP. 78°


ROUTE SR 191  
 COUNTY WILLIAMS  
 TOWNSHIP BRADY  
 SECTION 8  
T 7 N R 4 E

TYPE MONUMENT SM.R.R.SPIKE  
 ON SURFACE - ~~BELOW~~ ON \_\_\_\_\_  
 LEFT - ~~C PAV'T~~ RIGHT 0.6'  
10.8' TO RT EDGE PAVEMENT  
 S.L.M. 535+41

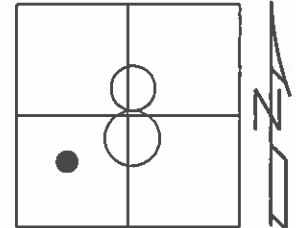

GRID: NORTHING: \_\_\_\_\_ EASTING: \_\_\_\_\_


SET MAG NAIL  
 7-27-04  
 SAH

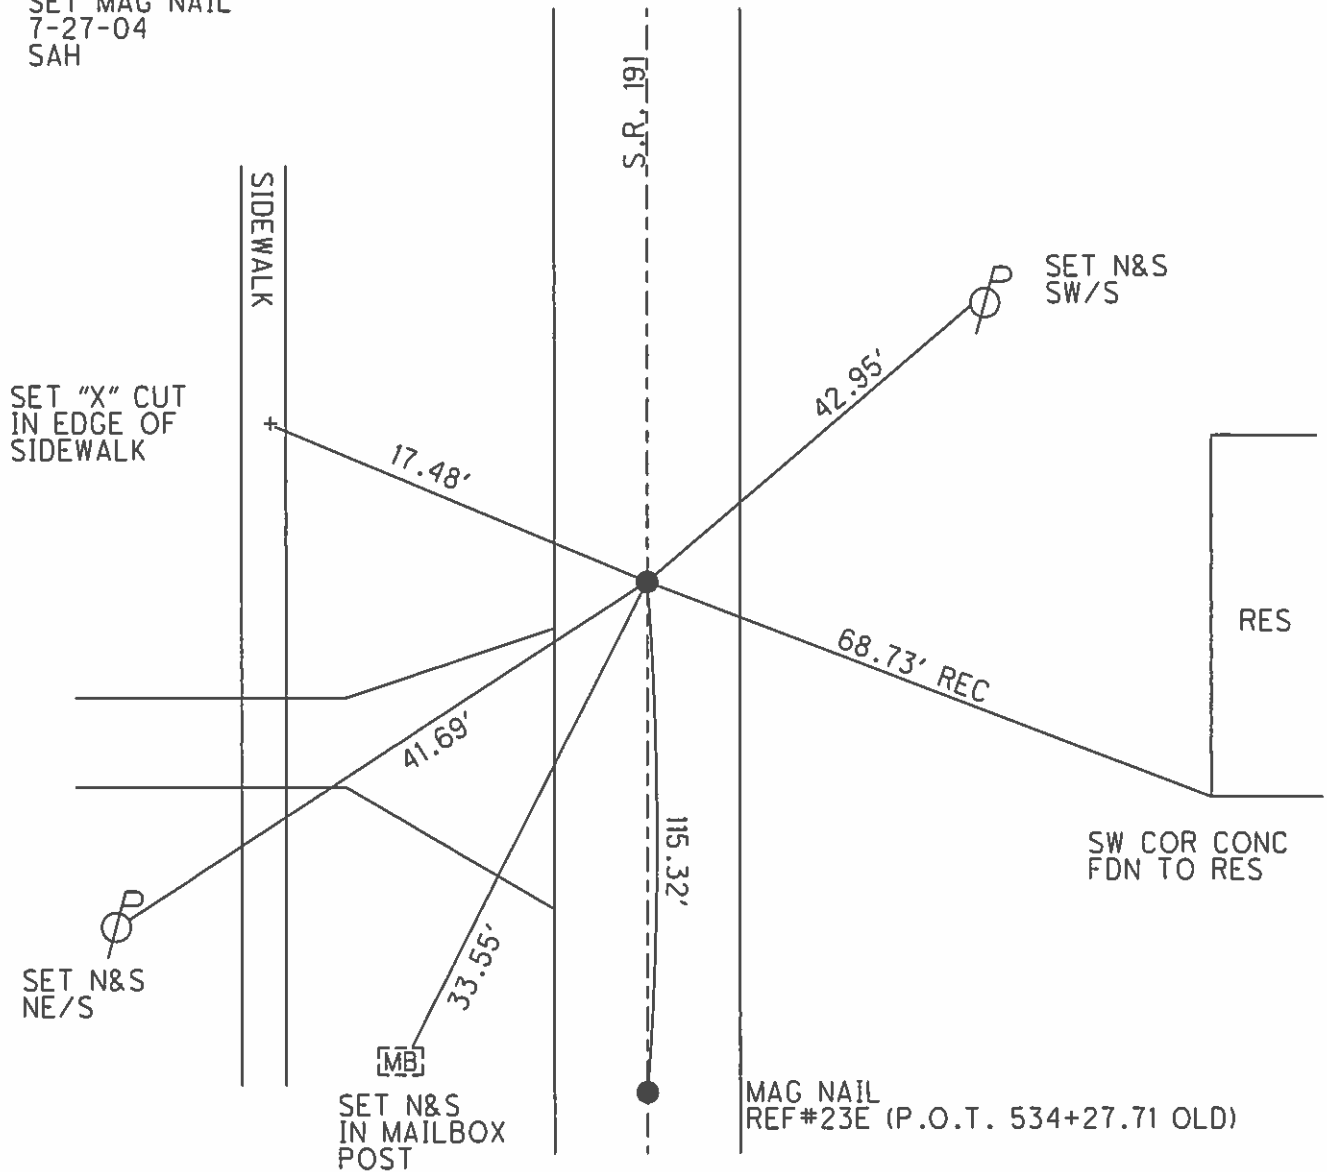


O.D.O.T. DISTRICT 2 SURVEY OFFICE

PERSONNEL	REFERENCE NO. <u>23-F</u>	SHEET <u>20</u> OF <u>23</u>
NOTES <u>HUSS</u>	DATE <u>6-15-04</u>	ROUTE <u>SR 191</u>
H.C. <u>HOMAN</u>	WEATHER <u>CLEAR</u>	COUNTY <u>WILLIAMS</u>
R.C. <u>NUHFER</u>	TEMP. <u>78°</u>	TOWNSHIP <u>BRADY</u>
		SECTION <u>8</u>
		<u>T 7 N R 4 E</u>

TYPE MONUMENT SM RR SPIKE  
 ON SURFACE - ~~BELOW~~ ON  
 LEFT - ~~C PAVT - RIGHT~~ 0.6' LT  
10.8' TO RT EDGE PAVEMENT  
 S.L.M. 535+41

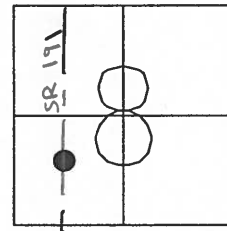

SET MAG NAIL  
 7-27-04  
 SAH

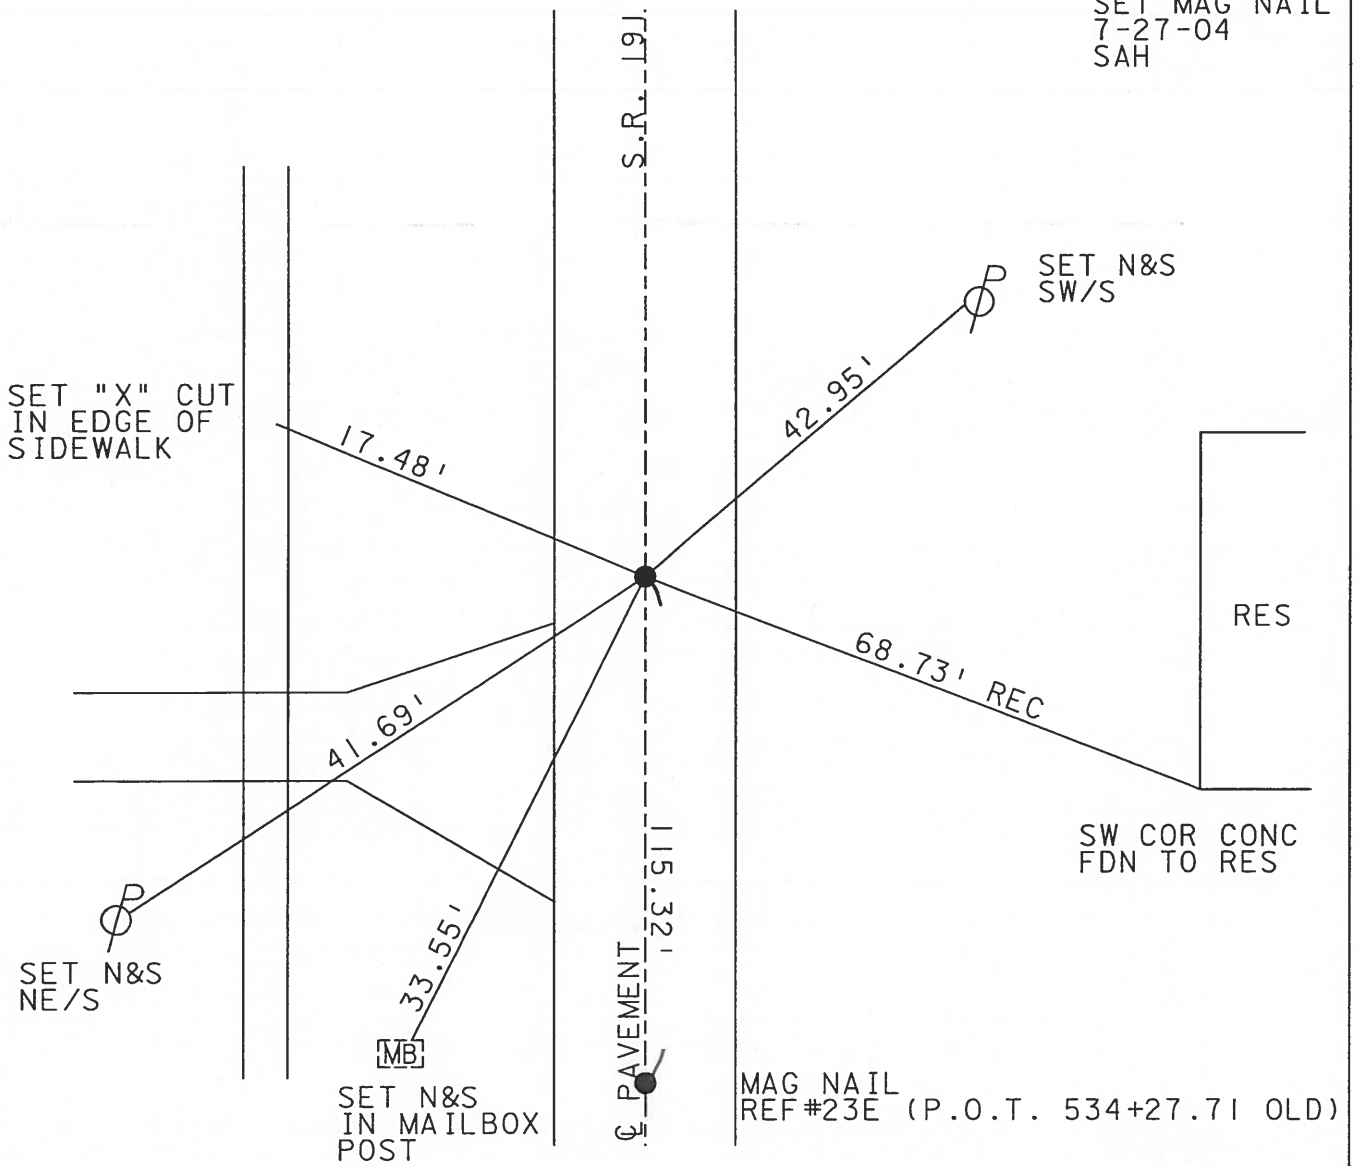

O.D.O.T. DISTRICT 2 SURVEY OFFICE

PERSONNEL

REFERENCE NO. 23-F

SHEET 19 OF 22

NOTES 1. Stone

H.C. D. Curtis

R.C. J. Haushalter

DATE 14 Jan. 87

WEATHER Cool

TEMP. 39°

ROUTE SR#191

COUNTY Williams

TOWNSHIP Brady

SECTION 8

T.      R.     


TYPE MONUMENT RR Spk.

ON SURFACE - BELOW Surface

LEFT -      PAV'T. - RIGHT     

     TO      EDGE PAVEMENT

S.L.M. 535+41

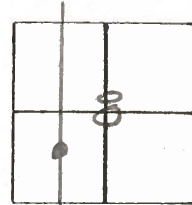

Set Small R.R. Spk. To Surface  
9-10-87

