

O.D.O.T. DISTRICT 2 SURVEY OFFICE (USE ONLY)

PERSONNEL

REFERENCE NO. 23 G

SHEET 31 OF 34

NOTES RHOADES

DATE 7/12/18

ROUTE SR 191

H.C. LEU

WEATHER CLEAR

COUNTY WILLIAMS

R.C. HAGEMEYER

TEMP. 75°

TOWNSHIP BRADY

SECTION 8

DWG BY NASON

PID 102827

T 7 N R 4 E

TYPE MONUMENT MAG NAIL

ON SURFACE - ~~BELOW~~ ON

OFFSET Q PAVEMENT 1' LT : ~~RT~~

10.8' TO RT EDGE PAVEMENT


STATION: 536+04.37

HORIZ.DATUM: NAD83(2011)


GEOID: 2012A

GRID: NORTHING: 701491.621

EASTING: 1439377.614

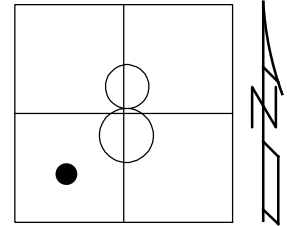

RECORD:
 SET MAG NAIL
 7-27-04, SAH
 FD MAG NAIL
 REFG23
 7/12/18
 SET MAG/WASHER
 9/19/19, JLL

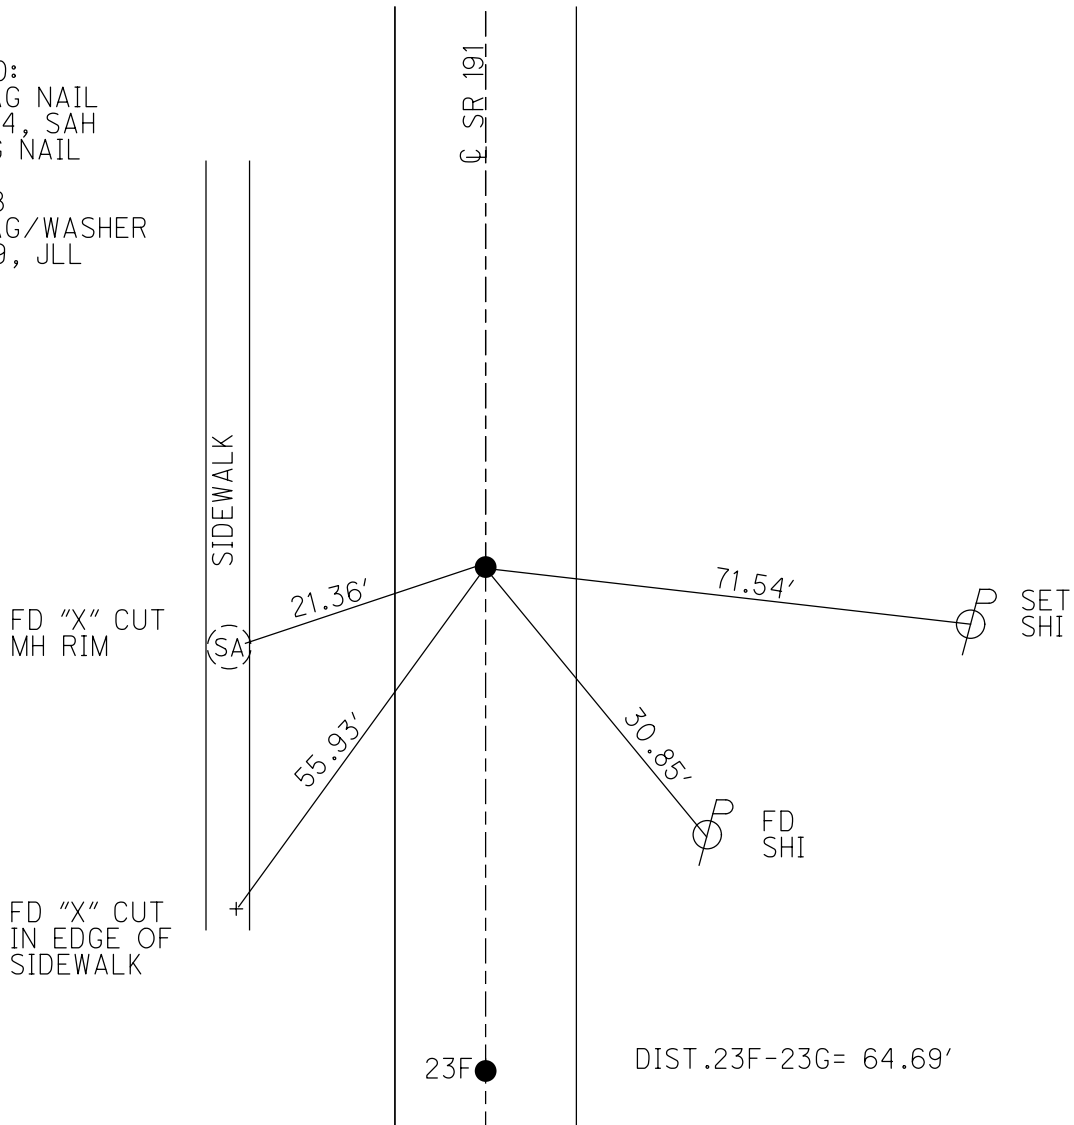

DIST .23F-23G= 64.69'

O.D.O.T. DISTRICT 2 SURVEY OFFICE (USE ONLY)

PERSONNEL _____ REFERENCE NO. 23 G SHEET 31 OF 34

NOTES HUSS DATE 6/15/04 ROUTE SR 191

H.C. HOMAN WEATHER CLEAR COUNTY WILLIAMS

R.C. NUHFER TEMP. 80° TOWNSHIP BRADY

SECTION 8

T 7 N R 4 E

TYPE MONUMENT SM.R.R.SPIKE


ON SURFACE - ~~BELOW~~ ON _____

LEFT - ~~C PAV'T - RIGHT~~ 0.5'


10.8' TO RT EDGE PAVEMENT

S.L.M. 536+05

GRID: NORTHING: _____ EASTING: _____

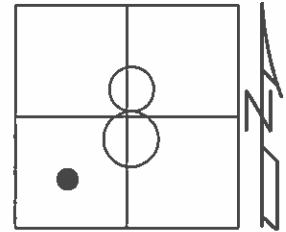

SET MAG NAIL
7-27-04
SAH

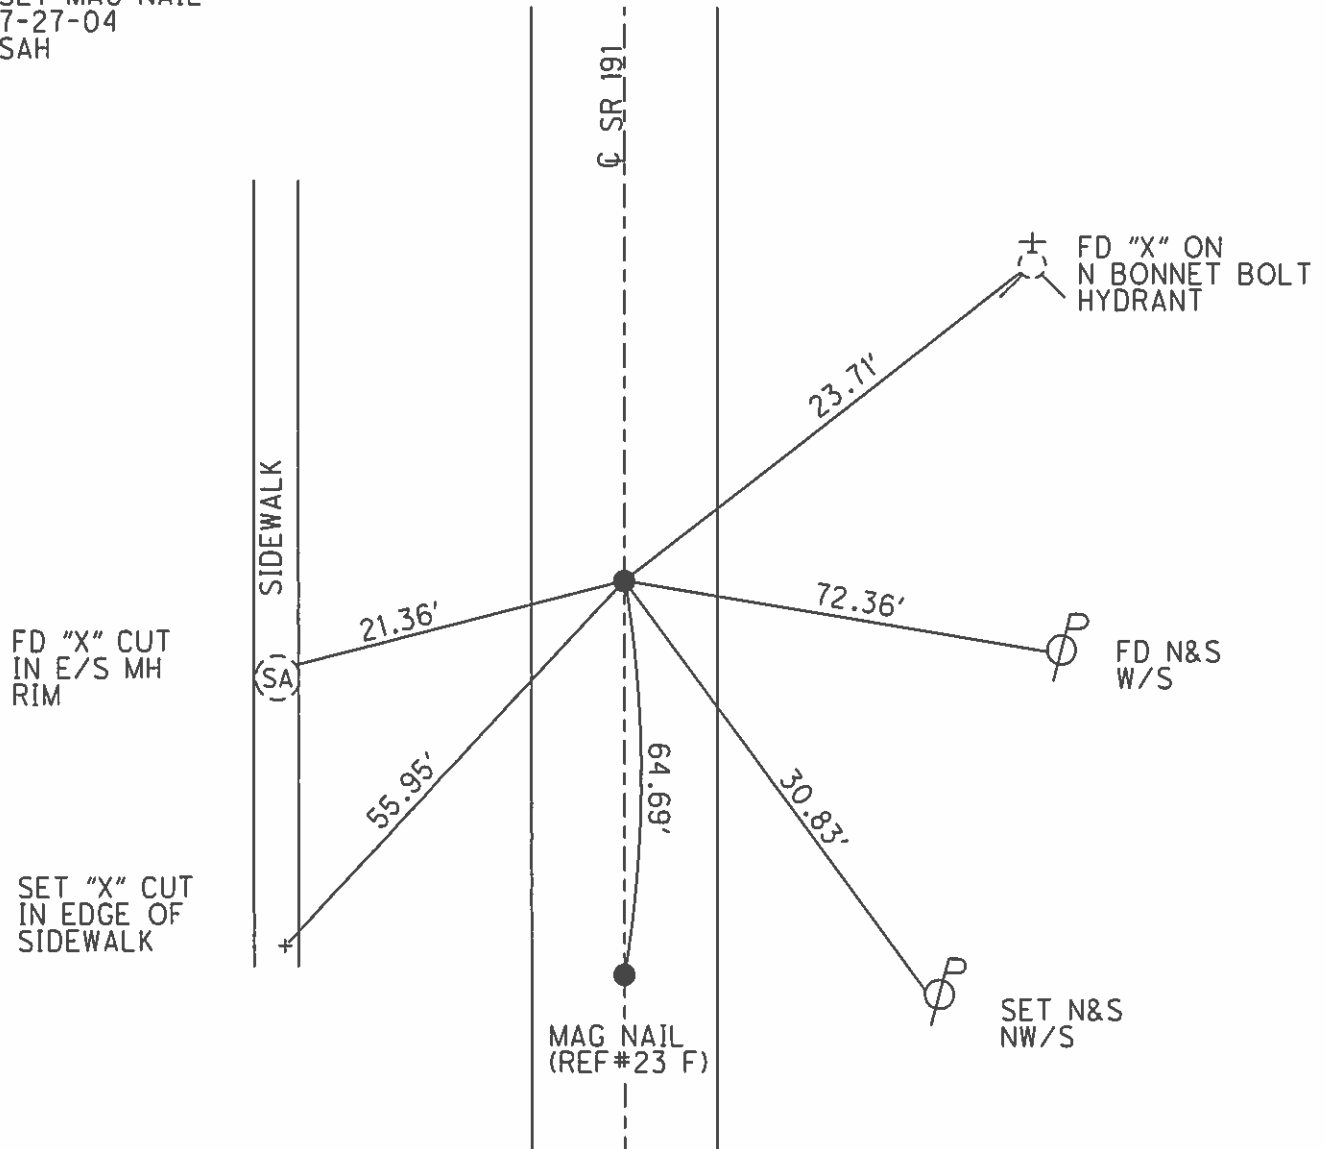

O.D.O.T. DISTRICT 2 SURVEY OFFICE

PERSONNEL _____

REFERENCE NO. 23-G

SHEET 21 OF 23

NOTES HUSS

DATE 6-15-04

ROUTE SR 191

H.C. HOMAN

WEATHER CLEAR

COUNTY WILLIAMS

R.C. NUHFER

TEMP. 80°

TOWNSHIP BRADY

SECTION 8

T 7 N R 4 E


TYPE MONUMENT SM RR SPIKE

ON SURFACE ~~- BELOW~~ ON


LEFT ~~- C PAVT - RIGHT~~ 0.5' LT

10.8' TO RT. EDGE PAVEMENT

S.L.M. 536+05

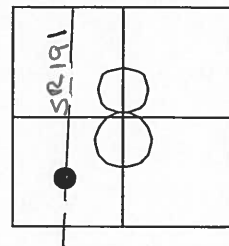

SET MAG NAIL
7-27-04
SAH

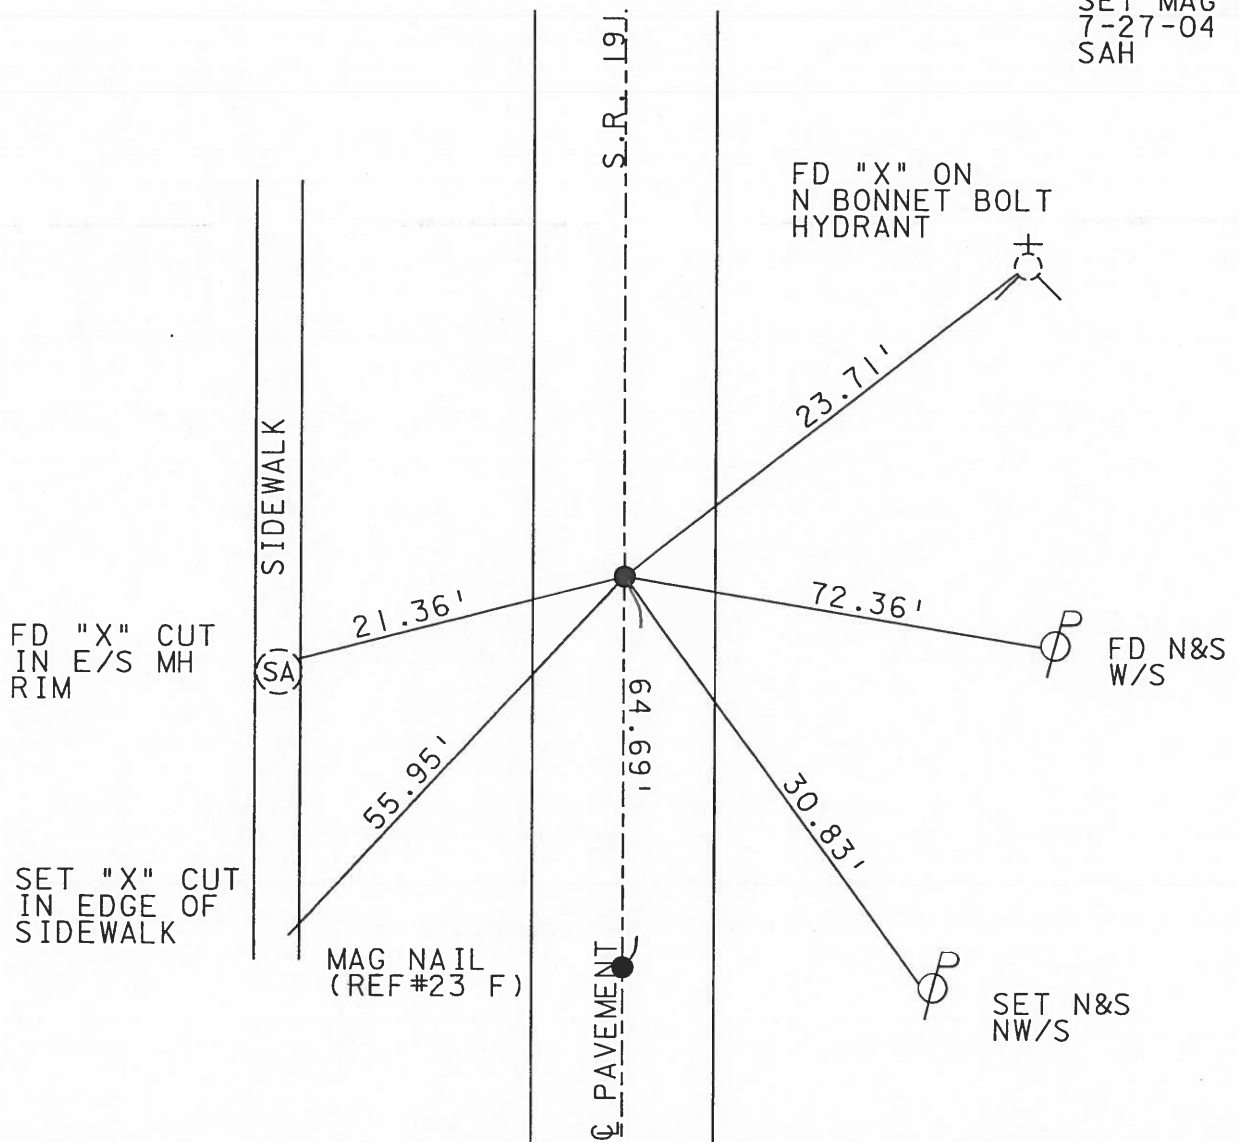

O.D.O.T. DISTRICT 2 SURVEY OFFICE

PERSONNEL

REFERENCE NO. 23-G

SHEET 20 OF 22

NOTES 1. Stone

H.C. D. Curtis

R.C. J. Householder

DATE 14 Jan. 87

WEATHER Coal

TEMP. 39°

ROUTE SR#191

COUNTY Williams

TOWNSHIP Brady

SECTION 8

T ___ R ___


TYPE MONUMENT RR Spk.

ON SURFACE - BELOW 2" deep

LEFT - & PAV'T. - RIGHT

___ TO ___ EDGE PAVEMENT

S.L.M. 536+05

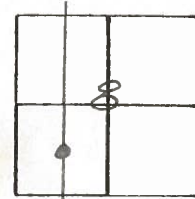

Set Small R.R. Spk. To Surface
9-10-87

