

PERSONNEL TITLE PERSONNEL TITLE

Louys
Passefall
Wise
Erikson

Knapc
Newcomb

COUNTY WV.

DATE 6-19-67

S. R. 191


WEATHER Fair

SEC. 2 1/2 mi N of Stryker TEMP. 70°

DESCRIPTION

Alignment and R/W

JOB NO.

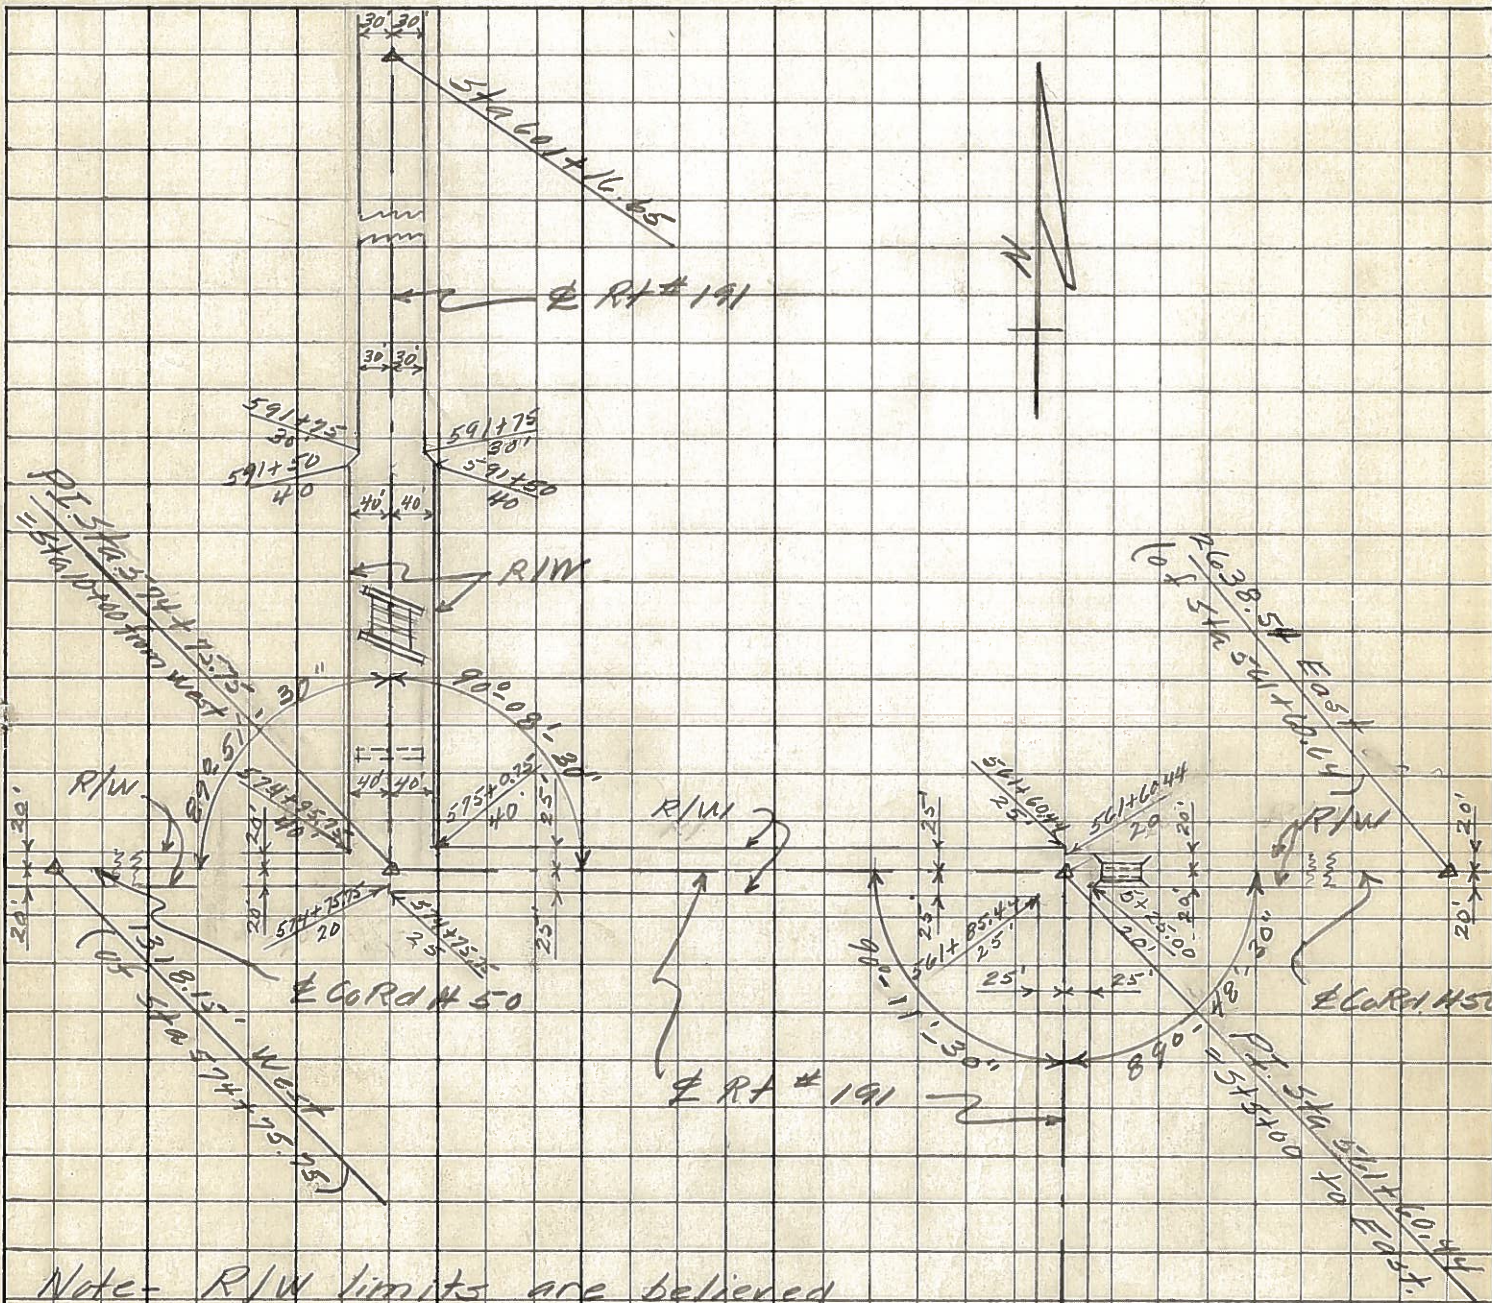

Note - R/W limits are believed to be correct as shown.

Reference = Deed Record book Vol. # 145 pgs. 151 to 171 of Brady & Springfield Twp. in Recorder's office, Bryan O. also State Highway Construction plan dated 1959 or WV 191-9.19, 5 structures. (Existing 60' R/W back of Sta 574+75.95 is incorrect)

R/W

P.I. Sta 574+13.38

Copy to GHS
7-5-67
CW

PERSONNEL	TITLE	PERSONNEL	TITLE	COUNTY	DATE
<u>Lovys</u>		<u>Newcomb</u>		<u>Wi</u>	<u>6-15-67</u>
<u>Passafium</u>				S. R. # <u>191</u>	WEATHER <u>Fair</u>
<u>Wise</u>				SEC. Br Co Rd <u>H-50</u>	TEMP. <u>90°</u>
<u>Erikson</u>					
DESCRIPTION	<u>Witnesses to Control Points</u>			JOB NO.	
	LEFT	CENTER LINE	RIGHT		

