


O.D.O.T. DISTRICT 2 SURVEY OFFICE (USE ONLY)

PERSONNEL _____ REFERENCE NO. 2 SHEET 2 OF 23
 NOTES NIESE DATE 3/22/21 ROUTE US 20A
 H.C. AUBLE WEATHER FAIR COUNTY WILLIAMS
 R.C. NIESH TEMP. 52° TOWNSHIP MADISON
 DWG BY RHOADES PID 95998 SECTION 32
 T 9 S R 2 W

TYPE MONUMENT P.K./WASHER
 ON SURFACE - ~~BELOW~~ ON
 OFFSET C PAVEMENT ON LT : RT
12.2' TO LT EDGE PAVEMENT
 STATION: 9+02

HORZ.DATUM: NAD83 2011 GEOID: NAVD88 2012A
 GRID: NORTHING: 727004.756 EASTING: 1402386.922

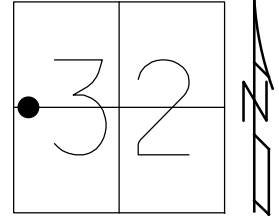


RECORD: P.C.
 STA 3+92.56
 FD LG.R.R.SPIKE
 W/"+"
 1/2" DOWN
 MBH
 FD P.K./WASHER
 8/19/98, SAH
 SET P.K./WASHER
 11/12/98, BVD
 FD P.K./WASHER
 REF2
 12/14/18, JLL
 SET MAG/WASHER
 10/26/21, DSA

SET NOTCH
 3.5' UP
 SIGN POST

SET
 SHIS

SET SHI
 GR POSTS

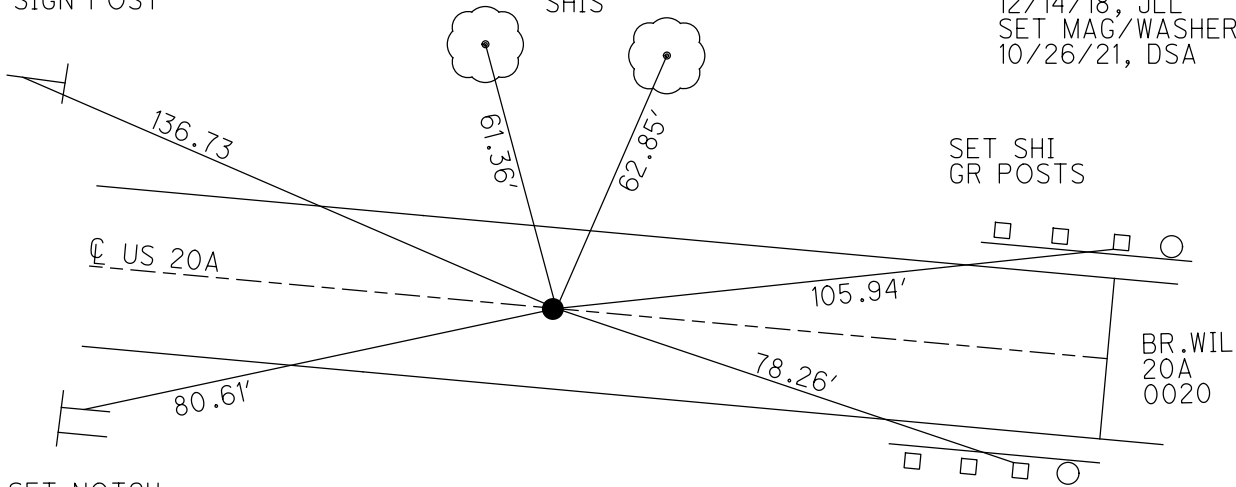


SET NOTCH
 3' UP
 SIGN POST


O.D.O.T. DISTRICT 2 SURVEY OFFICE (USE ONLY)

PERSONNEL _____ REFERENCE NO. 2 SHEET 2 OF 23
 NOTES HUSS DATE 8/19/98 ROUTE US 20A
 H.C. CORDES WEATHER PTLY CLOUDY COUNTY WILLIAMS
 R.C. HUSS TEMP. 80° TOWNSHIP MADISON
 DWG BY NIESE PID _____ SECTION 32
 T 9 S R 2 W

TYPE MONUMENT P.K./WASHER
 ON SURFACE - ~~BELOW~~ ON
 OFFSET C PAVEMENT ON LT : RT
13.2' TO LT EDGE PAVEMENT
 STATION: 9+02
 HORZ.DATUM: _____ GEOID: _____
 GRID: NORTHING: _____ EASTING: _____

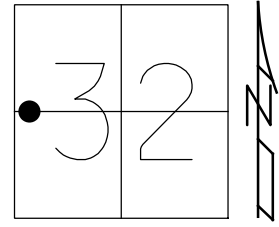

RECORD: P.C.
 STA 3+92.56
 FD LG.R.R.SPIKE
 W/"+"
 1/2" DOWN
 MBH
 FD P.K./WASHER
 8/19/98, SAH
 SET P.K./WASHER
 11/12/98, BVD

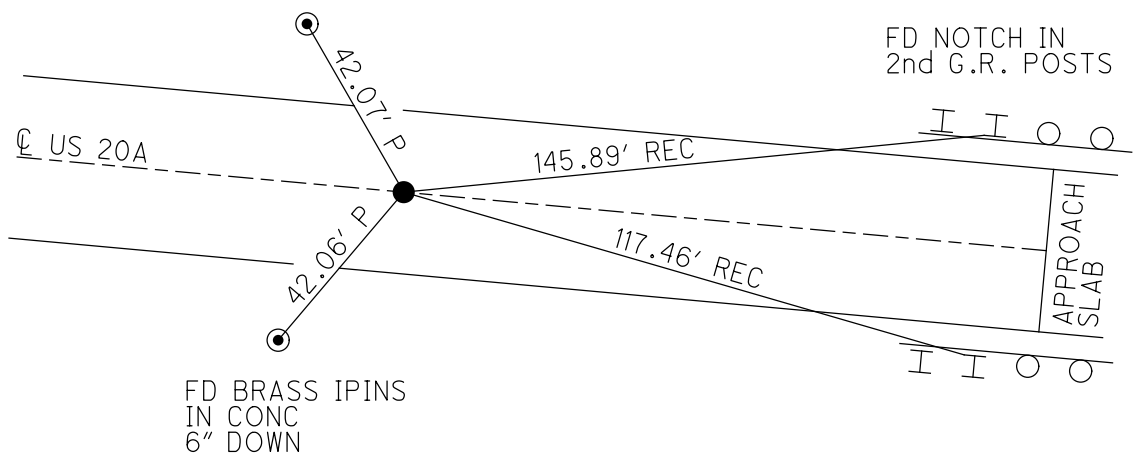

O.D.O.T. DISTRICT 2 SURVEY OFFICE

PERSONNEL


REFERENCE NO. 2 SHEET 2 OF 3

NOTES S. Huss
 H.C. B. Cordes
 R.C. S. Huss

DATE 8-19-98
 WEATHER Pt Cldy Fair
 TEMP. +80° F

ROUTE 20-A
 COUNTY Williams
 TOWNSHIP Madison
 SECTION 32
 T 9 S R 2 W


TYPE MONUMENT PK/WASHER
 ON SURFACE - ~~BELOW~~ YES
~~LEFT~~ - C PAV'T - ~~RIGHT~~ YES
12.2 TO L EDGE PAVEMENT
 S.L.M. 0+02

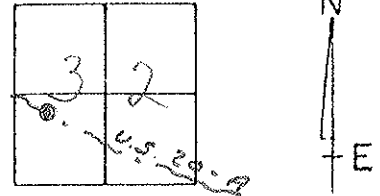

Record

PC, Sta 3+92.56
 Fd "4" on lng. RR spk
 1/2" below surf MBH

SET PK & WASHER
 11-12-98
 B.V.D

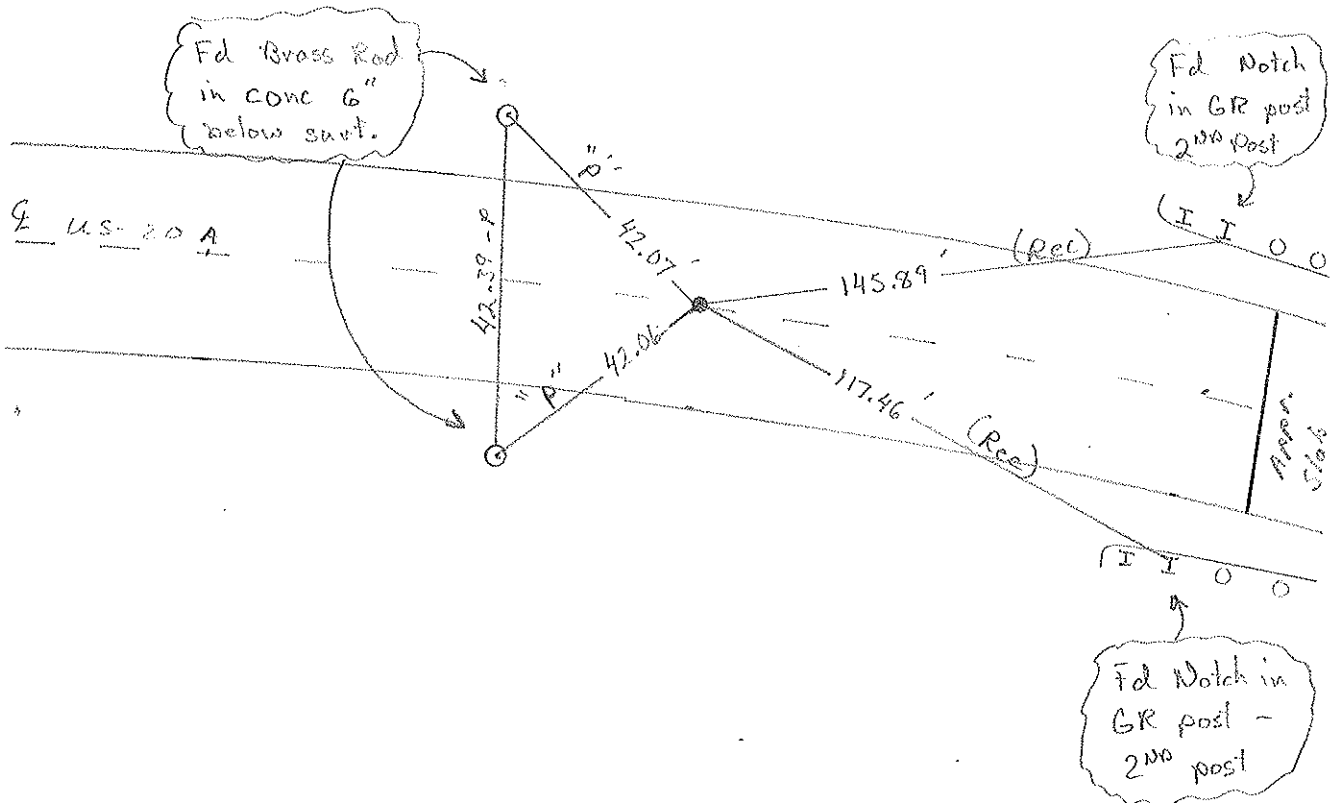

Hubs Set