



O.D.O.T. DISTRICT 2 SURVEY OFFICE (USE ONLY)

PERSONNEL _____ REFERENCE NO. 4 A SHEET 4 OF 23
 NOTES NIESE DATE 4/28/22 ROUTE US 20A
 H.C. AUBLE WEATHER SUNNY COUNTY WILLIAMS
 R.C. PARADYZ TEMP. 40° TOWNSHIP MADISON
 DWG BY RHOADES PID 95786 SECTION 33
 T 9 S R 2 W

TYPE MONUMENT MAG/WASHER
 ON SURFACE - ~~BELOW~~ ON _____
 OFFSET ϕ PAVEMENT 0.3' ~~LT~~ : RT
 - TO - EDGE PAVEMENT
 STATION: 60+74.62

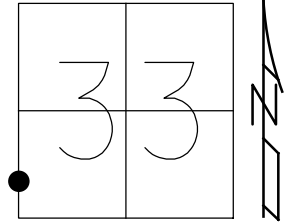

HORIZ.DATUM: NAD83 2011 GEOID: NAVD88 2012B
 GRID: NORTHING: 725347.730 EASTING: 1407235.109

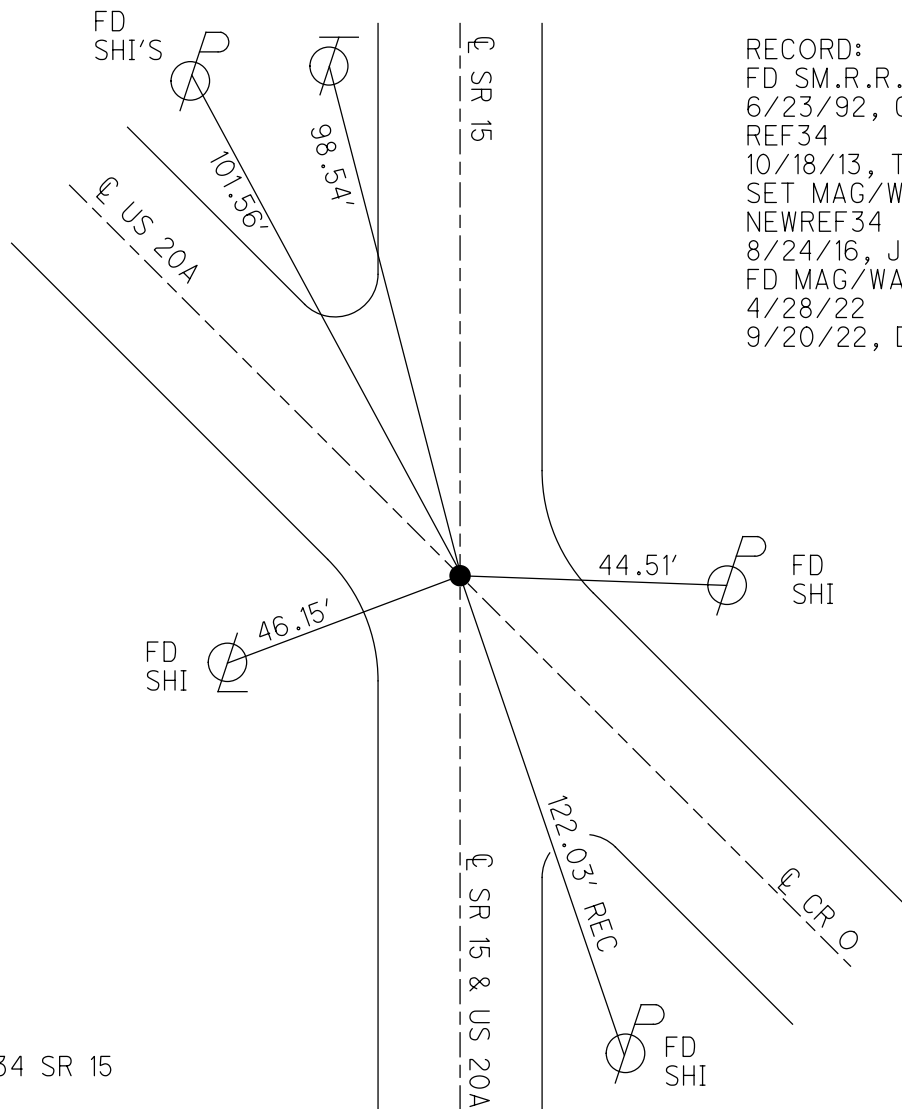


RECORD:
 FD SM.R.R.SPIKE
 6/23/92, CL
 REF34
 10/18/13, TMR
 SET MAG/WASHER
 NEWREF34
 8/24/16, JFO
 FD MAG/WASHER
 4/28/22
 9/20/22, DSA

NOTE: REF 34 SR 15

O.D.O.T. DISTRICT 2 SURVEY OFFICE (USE ONLY)

PERSONNEL _____ REFERENCE NO. 4 A SHEET 1 OF 21
 NOTES LEU _____ DATE 3/29/16 ROUTE US 20A
 H.C. HOMAN WEATHER SUNNY COUNTY WILLIAMS
 R.C. LEU TEMP. 32° TOWNSHIP MADISON
 _____ SECTION 33
 _____ T 10 S R 2 W


TYPE MONUMENT SM.R.R.SPIKE
 ON SURFACE - ~~BELOW~~ ON _____
~~LEFT~~ - ☉ PAV'T - ~~RIGHT~~ ON _____
 - TO - EDGE PAVEMENT
 S.L.M. 60+74.62

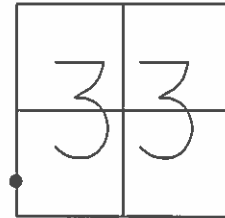

GRID: NORTHING: 725347.730 EASTING: 1407235.109

NOTE:
 SR 15 REF34

RECORD:
 FD SM.R.R.SPIKE
 6/23/92, CL
 FD SM.R.R.SPIKE
 REF34
 10/18/13, TMR
 SET MAG/WASHER
 NEWREF34
 8/24/16, JFO

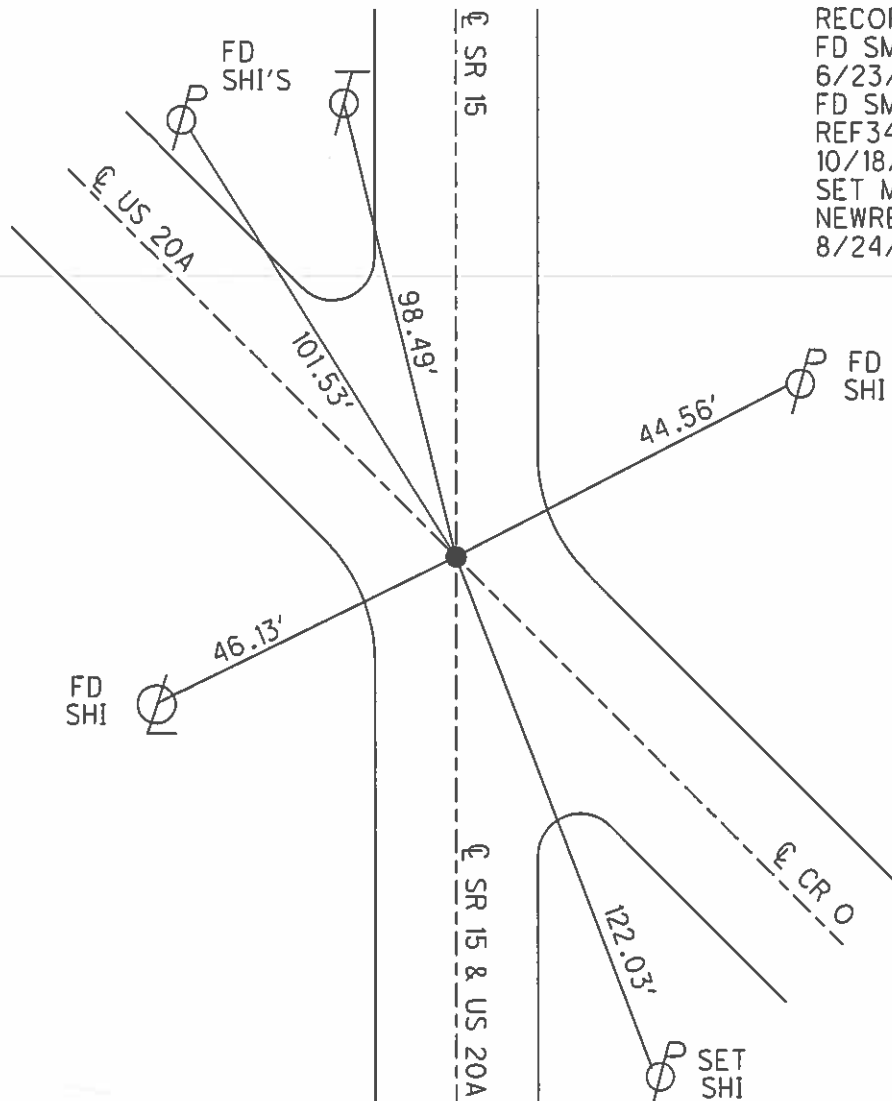


O.D.O.T. DISTRICT 2 SURVEY OFFICE (USE ONLY)


PERSONNEL _____ REFERENCE NO. 34 SHEET 1 OF 40

NOTES LEU _____ DATE 3/29/16 ROUTE SR 15
 H.C. HOMAN WEATHER SUNNY COUNTY WILLIAMS
 R.C. LEU TEMP. 32° TOWNSHIP MADISON
 _____ SECTION 33
 _____ T 10 S R 2 W

TYPE MONUMENT SM.R.R.SPIKE
 ON SURFACE - ~~BELOW~~ ON
~~LEFT~~ - Q PAV'T - ~~RIGHT~~ ON
 _____ TO _____ EDGE PAVEMENT
 S.L.M. 422+92.80

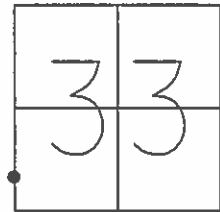

NOTE:
US 20A REF4A

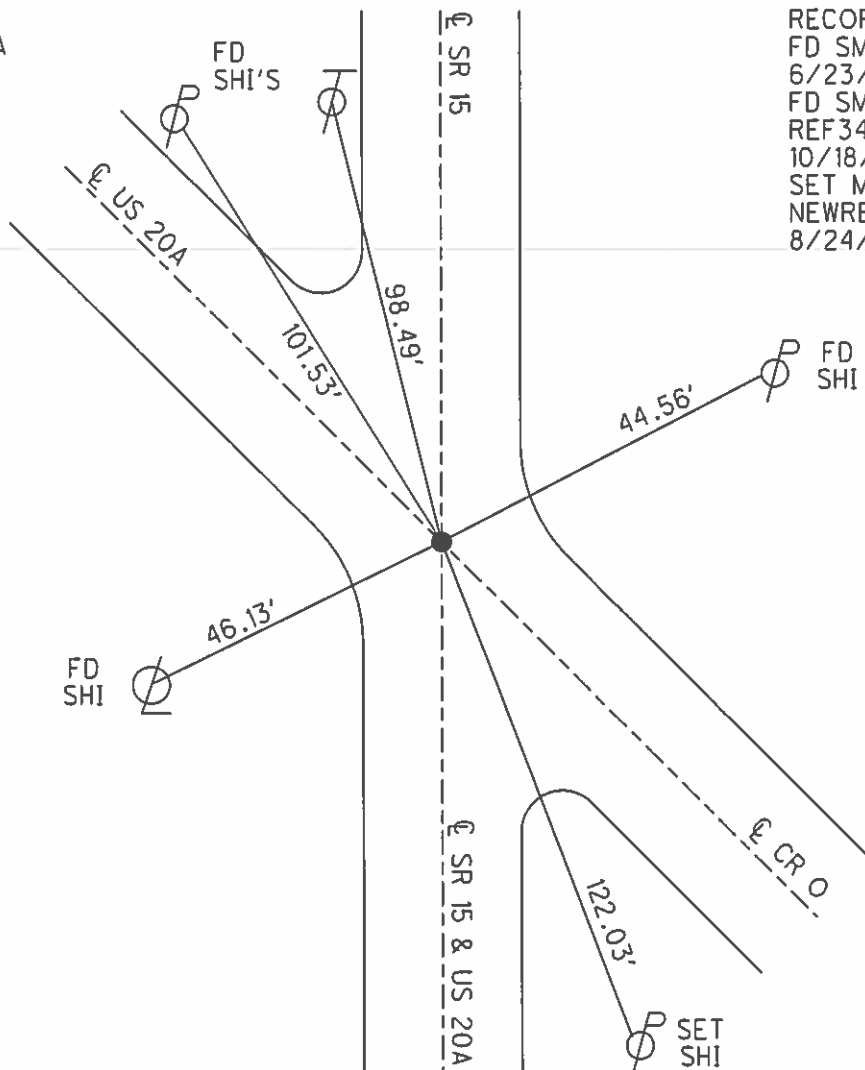

RECORD:
 FD SM.R.R.SPIKE
 6/23/92, CL
 FD SM.R.R.SPIKE
 REF34
 10/18/13, TMR
 SET MAG/WASHER
 NEWREF34
 8/24/16, JFO

GRID: NORTHING: 725347.730 EASTING: 1407235.109