


O.D.O.T. DISTRICT 2 SURVEY OFFICE (USE ONLY)

PERSONNEL _____ REFERENCE NO. 4 Q SHEET 18 OF 21
 NOTES O'DONNELL DATE 4/1/16 ROUTE US 20A
 H.C. RHOADES WEATHER CLOUDY COUNTY WILLIAMS
 R.C. O'DONNELL TEMP. 43° TOWNSHIP JEFFERSON
 _____ SECTION 5
 _____ T 7 N R 3 E


TYPE MONUMENT P.K./WASHER
 ON SURFACE - ~~BELOW~~ ON _____
~~LEFT~~ - ☉ PAV'T - RIGHT 4.5'
8.8' TO RT EDGE PAVEMENT
 S.L.M. 207+05.18

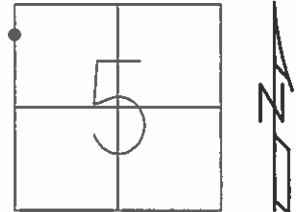

GRID: NORTHING: 710844.856 EASTING: 1406245.011

NOTE:
SR 15 REF29B


RECORD: P.I.
 FD R.R.SPIKE
 ON SURFACE
 7/16/92
 SET P.K./WASHER
 9/22/92, CL
 FD P.K./WASHER
 10/22/13
 REFB28
 10/23/13, TMR
 SET MAG/WASHER
 NEWREFB28
 8/29/16, JFO

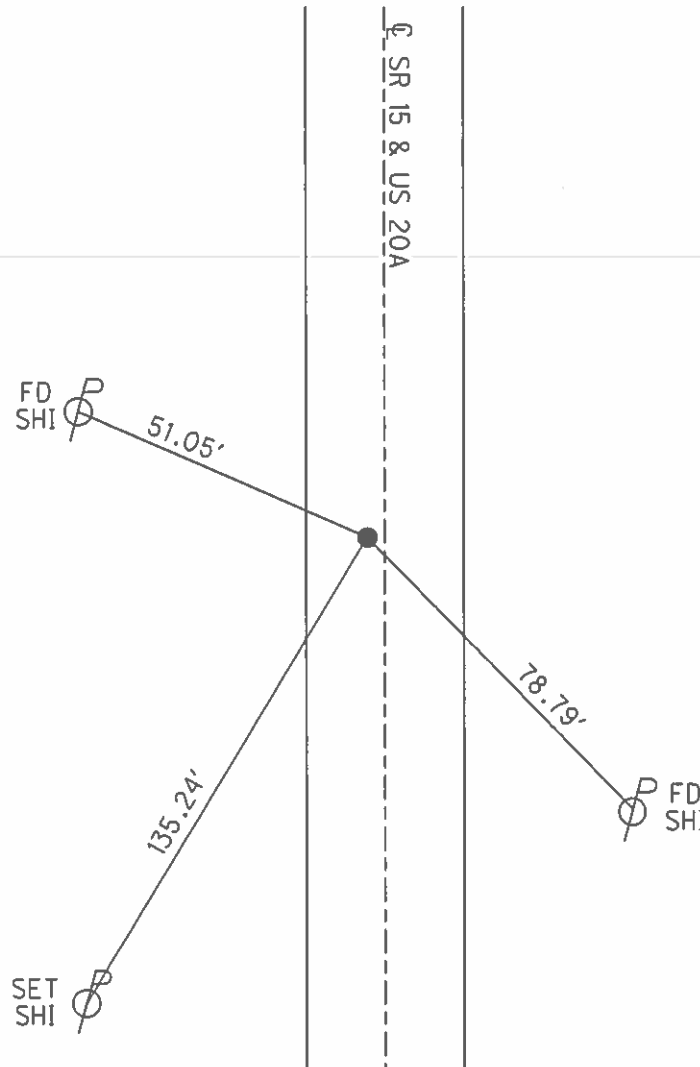

O.D.O.T. DISTRICT 2 SURVEY OFFICE (USE ONLY)

PERSONNEL _____ REFERENCE NO. 28 B SHEET 18 OF 40
 NOTES O'DONNELL DATE 4/1/16 ROUTE SR 15
 H.C. RHOADES WEATHER CLOUDY COUNTY WILLIAMS
 R.C. O'DONNELL TEMP. 43° TOWNSHIP JEFFERSON
 _____ SECTION 5
 _____ T 7 N R 3 E

TYPE MONUMENT P.K./WASHER
 ON SURFACE - ~~BELOW~~ ON
~~LEFT~~ - Q PAV'T - RIGHT 4.5'
8.8' TO RT EDGE PAVEMENT
 S.L.M. 569+44.65
 GRID: NORTHING: 710844.856 EASTING: 1406245.011

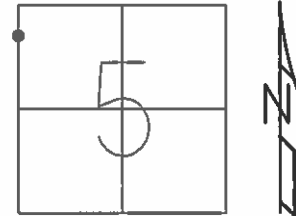

NOTE:
US 20A REF40

RECORD: P.I.
FD R.R.SPIKE
ON SURFACE
7/16/92
SET P.K./WASHER
9/22/92, CL
FD P.K./WASHER
10/22/13
REFB28
10/23/13, TMR
SET MAG/WASHER
NEWREFB28
8/29/16, JFO

