


O.D.O.T. DISTRICT 2 SURVEY OFFICE (USE ONLY)


PERSONNEL _____ REFERENCE NO. 6 SHEET 7 OF 32

NOTES RHOADES DATE 4/17/17 ROUTE US 20 A
 H.C. O'DONNELL WEATHER SUNNY COUNTY WILLIAMS
 R.C. HELDMAN TEMP. 62° TOWNSHIP JEFFERSON
 _____ SECTION 3
 _____ T 7 N R 3 E

TYPE MONUMENT P.K.NAIL
 ON SURFACE - ~~BELOW~~ ON
 LEFT - ☉ PAV'T - ~~RIGHT~~ ON
10.6' TO LT EDGE PAVEMENT
 S.L.M. 385+10.20
 Grid: Northing: 705794.221 Easting: 1419483.439

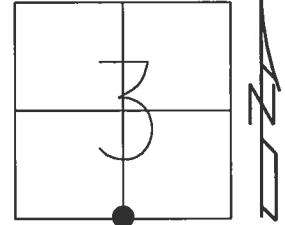

RECORD:
 P.K.NAIL ATOP
 SM.R.R.SPIKE
 STA. 496+27
 FD P.K.NAIL
 5/23/02, MC
 SET MAG/WASHER
 1/2/04, MB
 FD P.K.NAIL
 REF6
 5/16/16, JFO
 SET MAG/WASHER
 11/16/17, JFO

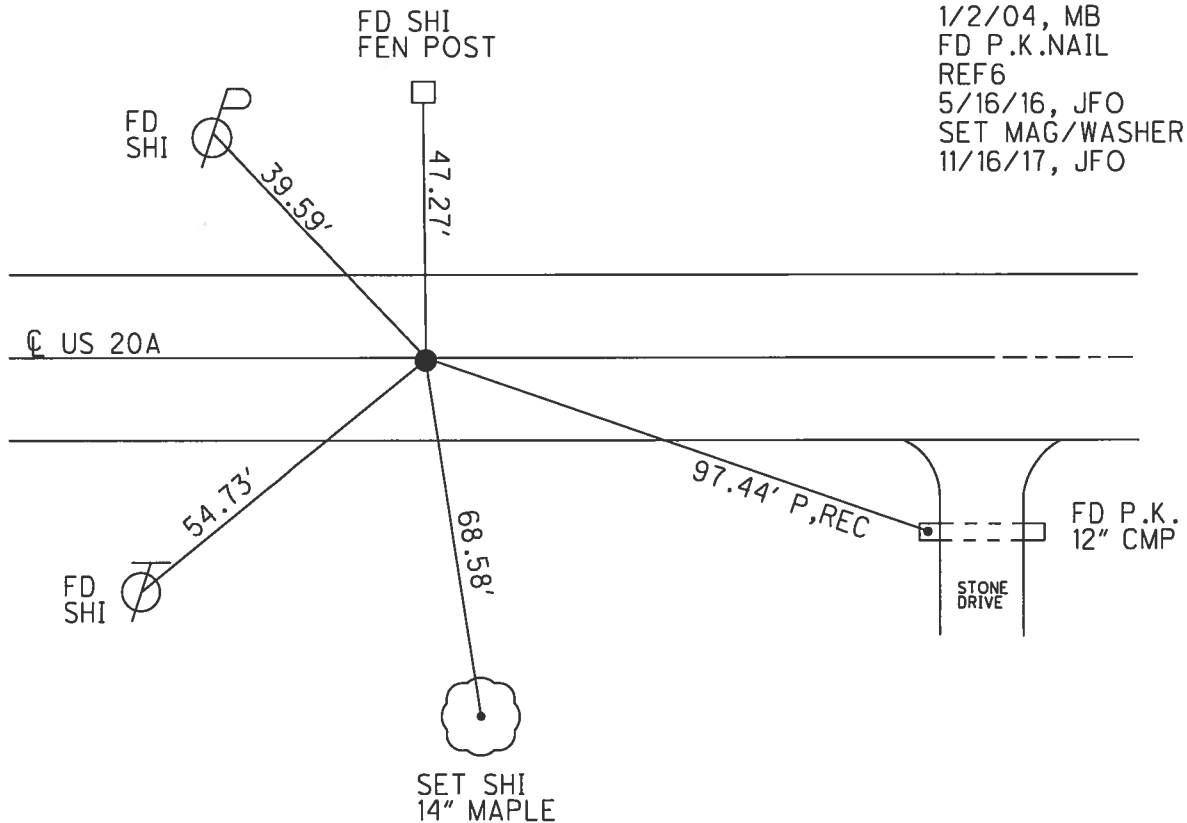

O.D.O.T. DISTRICT 2 SURVEY OFFICE

PERSONNEL

REFERENCE NO. 6

SHEET 5 OF 28

NOTES MALINSKY

H.C. CANTERRURY

R.C. BEAMONT

DATE 5-23-02

WEATHER Sun

TEMP. +62°

ROUTE U.S. 20-A

COUNTY Williams

TOWNSHIP Jefferson

SECTION 3

T7 N R 3 E


TYPE MONUMENT P.K. NAIL

ON SURFACE - ~~BELOW~~ on surface

~~LEFT - & PAV'T. - RIGHT~~ ON 4

10.6' TO LT. EDGE PAVEMENT

S.L.M. 496+27

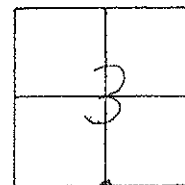

RECORD: P.K. NAIL ATOP SM. R.R. SPK

RESET MAG/WASHER
 1-02-04
 M.B.

