


O.D.O.T. DISTRICT 2 SURVEY OFFICE (USE ONLY)

PERSONNEL _____ REFERENCE NO. 7 SHEET 8 OF 32


NOTES RHOADES DATE 4/17/17 ROUTE US 20 A
 H.C. O'DONNELL WEATHER SUNNY COUNTY WILLIAMS
 R.C. HELDMAN TEMP. 61° TOWNSHIP JEFFERSON
 SECTION 3
 T 7 N R 3 E

TYPE MONUMENT P.K.NAIL
~~ON SURFACE~~ - BELOW 3"
 LEFT - ☉ PAV'T - ~~RIGHT~~ 2.6'
- TO - EDGE PAVEMENT
 S.L.M. 412+49.80

Grid: Northing: 705777.794 Easting: 1422223.030

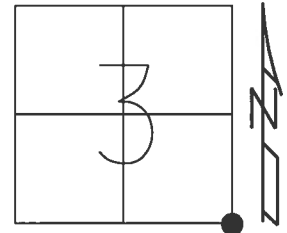

RECORD:
 P.K.NAIL ATOP
 SM.R.R.SPIKE
 STA. 523+67
 FD P.K.NAIL
 5/23/02, MC
 SET MAG/WASHER
 1/2/04, MB
 FD P.K.NAIL
 REF7
 5/16/16, JFO
 SET MAG/WASHER
 11/16/17, JFO

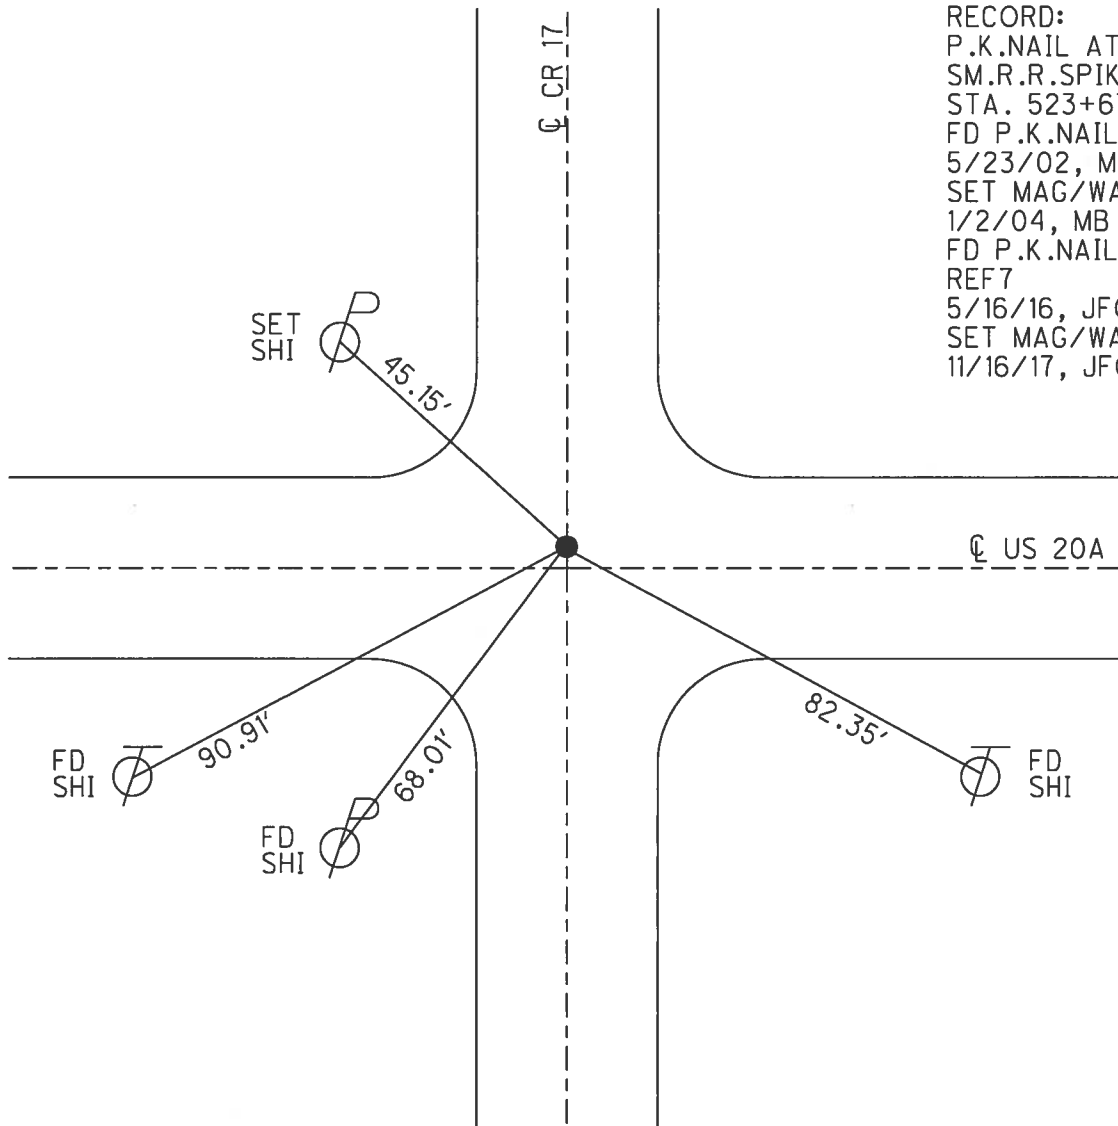

O.D.O.T. DISTRICT 2 SURVEY OFFICE

PERSONNEL _____

REFERENCE NO. 7

SHEET 6 OF 28

NOTES MALINSKY

H.C. CANTERBURY

DATE 5-23-02

ROUTE U.S. 20-A

R.C. BEAUMONT

WEATHER Sun

COUNTY Williams

TEMP. +62°

TOWNSHIP Jefferson

SECTION 3

T 7 N R 3 E


TYPE MONUMENT P.K. NAIL

ON SURFACE - ~~BELOW~~ on surface

LEFT - ~~E PAV'T.~~ RIGHT 2.6' LT

TO EDGE PAVEMENT ON E N&S

S.L.M. 523+67

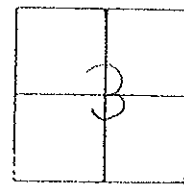

RECORD: P.K. NAIL ATOP SM. R.R. SPK.

RESET MAG/WASHER
1-02-04
M.B.

