


O.D.O.T. DISTRICT 2 SURVEY OFFICE (USE ONLY)


PERSONNEL _____ REFERENCE NO. 20 SHEET 25 OF 32
 NOTES RHOADES DATE 11/21/17 ROUTE US 20 A
 H.C. O'DONNELL WEATHER FAIR COUNTY WILLIAMS
 R.C. FARKAS TEMP. 42° TOWNSHIP BRADY
 _____ SECTION 5
 _____ T 7 N R 4 E

TYPE MONUMENT MAG/WASHER
 ON SURFACE - ~~BELOW~~ ON
 LEFT - ☉ PAV'T - RIGHT ON
 - TO - EDGE PAVEMENT
 S.L.M. 591+48.95

Grid: Northing: 705299.336 Easting: 1440101.102

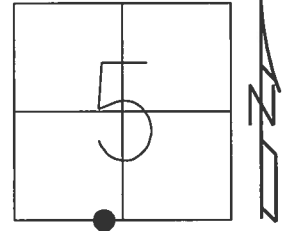

NOTE: REF 45 US 127

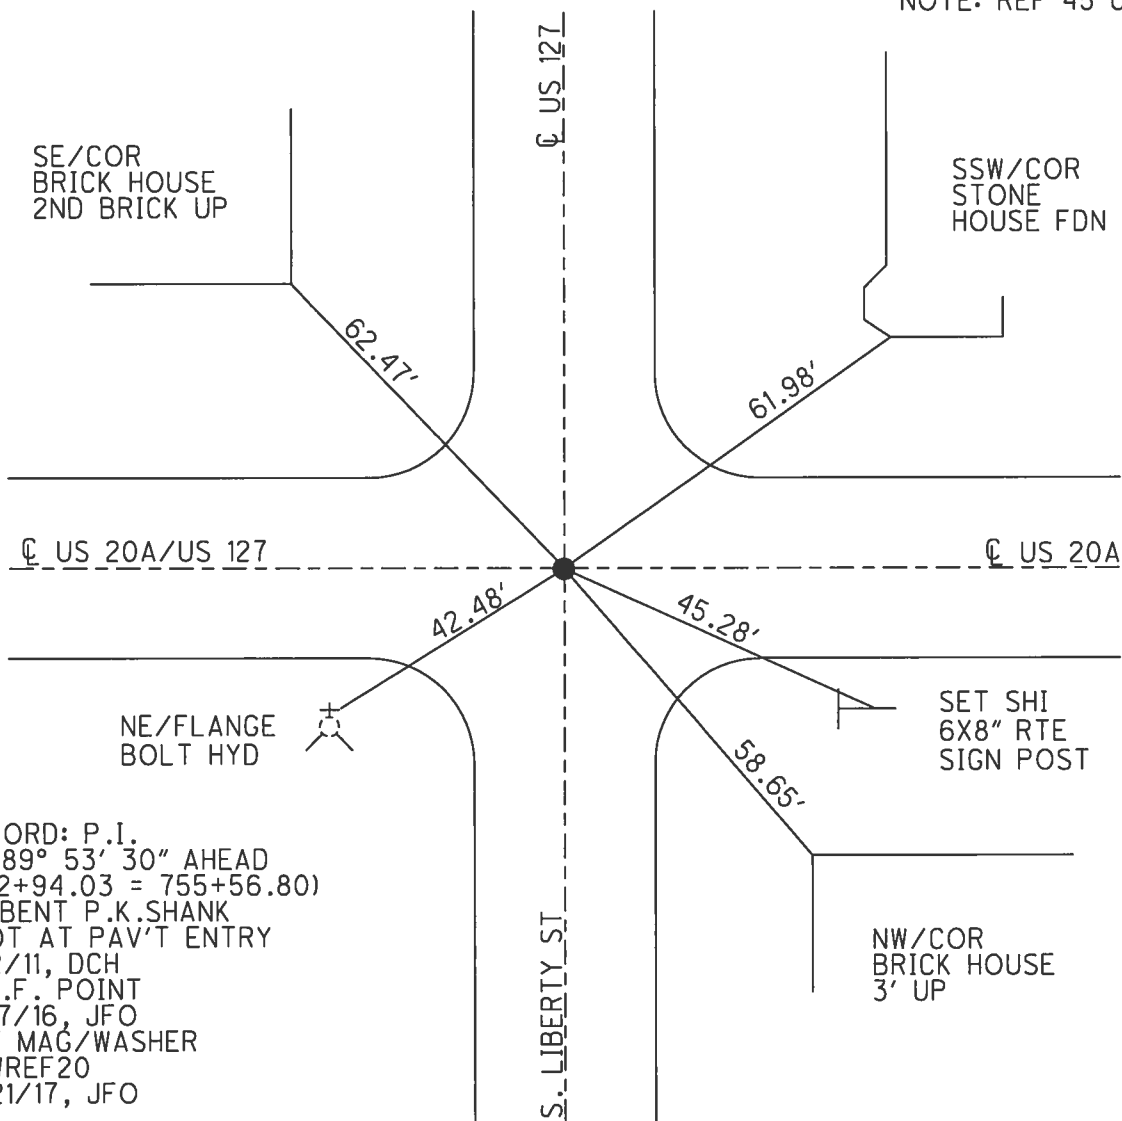

RECORD: P.I.
 $\Delta = 89^\circ 53' 30''$ AHEAD
 (702+94.03 = 755+56.80)
 FD BENT P.K.SHANK
 SHOT AT PAV'T ENTRY
 8/2/11, DCH
 D.N.F. POINT
 5/17/16, JFO
 SET MAG/WASHER
 NEWREF20
 11/21/17, JFO